


2 TYPICAL PAVEMENT SECTION

IN AREAS WITH OUT PERVIOUS CONCRETE Scale: Not To Scale

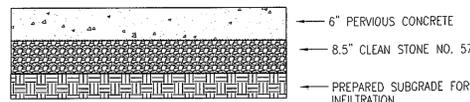

3 TYPICAL PERVIOUS PAVEMENT SECTION

Scale: Not To Scale

APPROVED CONSTRUCTION PLAN
 NAME _____ DATE _____
 PLANNING _____
 TRAFFIC _____
 FIRE _____

STORMWATER MANAGEMENT PLAN
 APPROVED
 CITY OF WILMINGTON
 ENGINEERING DEPARTMENT

DATE _____
 PERMIT # _____
 SIGNED _____

- ALL TRAFFIC CONTROL SIGNS AND MARKINGS OFF THE RIGHT OF WAY ARE TO BE MAINTAINED BY THE PROPERTY OWNER IN ACCORDANCE WITH MUTCD STANDARDS.
- CONTACT TRAFFIC ENGINEERING AT 910-341-7888 FORTY EIGHT HOURS PRIOR TO ANY EXCAVATION IN THE RIGHT OF WAY.
- IMMEDIATELY NOTIFY CITY OF WILMINGTON TRAFFIC ENGINEERING AT 910-341-7888 IF ANY TRAFFIC SIGNAL FACILITIES OR CITY OWNED STREET LIGHT FACILITIES ARE DAMAGED.
- DAMAGED FACILITIES SHALL BE REPLACED BY AN APPROVED CONTRACTOR, ACCORDING TO STANDARD NCDOT REPLACEMENT SCHEDULES AND CURRENT NCDOT DESIGN STANDARDS.
- ALL REPAIR REPLACEMENT OF TRAFFIC SIGNAL INFRASTRUCTURE SHALL BE COORDINATED WITH THE CITY OF WILMINGTON TRAFFIC ENGINEERING DIVISION.
- VERIFY THE LOCATION OF THE CITY OF WILMINGTON TRAFFIC SIGNAL SYSTEM FIBER RUNNING ALONG 16TH, 17TH AND WOOSTER ST. CONTACT TRAFFIC ENGINEERING AT 910-341-7888 TO DETERMINE IF THIS FIBER HAS TO BE RELOCATED.

DEVELOPER: EASTERN PRIDE, INC. 2405-F NASH STREET WILSON, NC 27896

OWNER: THOMSON REALTY INVEST LP 910 SAND MILLS BLVD ABERDEEN, NC 28315

GENERAL CONTRACTOR: STOCKS AND TAYLOR CONSTRUCTION, INC. 1825 CAROLINA AVENUE WASHINGTON, NC 27889

GENERAL BUILDING INFORMATION
 BUILDING USE: COMMERCIAL - RETAIL
 TOTAL LOT SIZE = 1.51 AC
 LOT 1 = 0.395 AC TO R/W
 LOT 2 = 1.115 AC TO R/W
 BUILDING SIZE: 9,914 SF

7427 SF RETAIL, 2487 SF OTHER
 BUILDING HEIGHT: 20 FT
 BUILDING CONSTRUCTION TYPE = V-B

BUILDING LOT COVERAGE
 9914SF / 65,775.6SF = 15.07%
 NO. OF BUILDINGS = 1


PROPOSED 5/8" WATER METER WITH BACKFLOW PREVENTER AND RPZ IN HOT BOX WITH ELECTRICAL TO PREVENT FREEZING

TOTAL IMPERVIOUS AREA
 BUILDING = 9914.00 SF
 SIDEWALK (ONSITE) = 1516.35 SF
 PAVEMENT = 10,084.77 SF
 PERVIOUS PAVEMENT = 10,531.22 SF
 (ON SITE ALONG WOOSTER)

TOTAL IMPERVIOUS AREA = 34,653.34 SF
 TOTAL GREEN SPACE = 31,122.26 SF

TOTAL PERVIOUS PAVEMENT = 10,531.22 SF
 % IMPERVIOUS EXISTING = 000%
 % IMPERVIOUS PROPOSED = 34,653.34/65,775.6 = 52.68%
 (WITH NO CREDIT FOR PERVIOUS PAVEMENT)

Max 7% GRADE

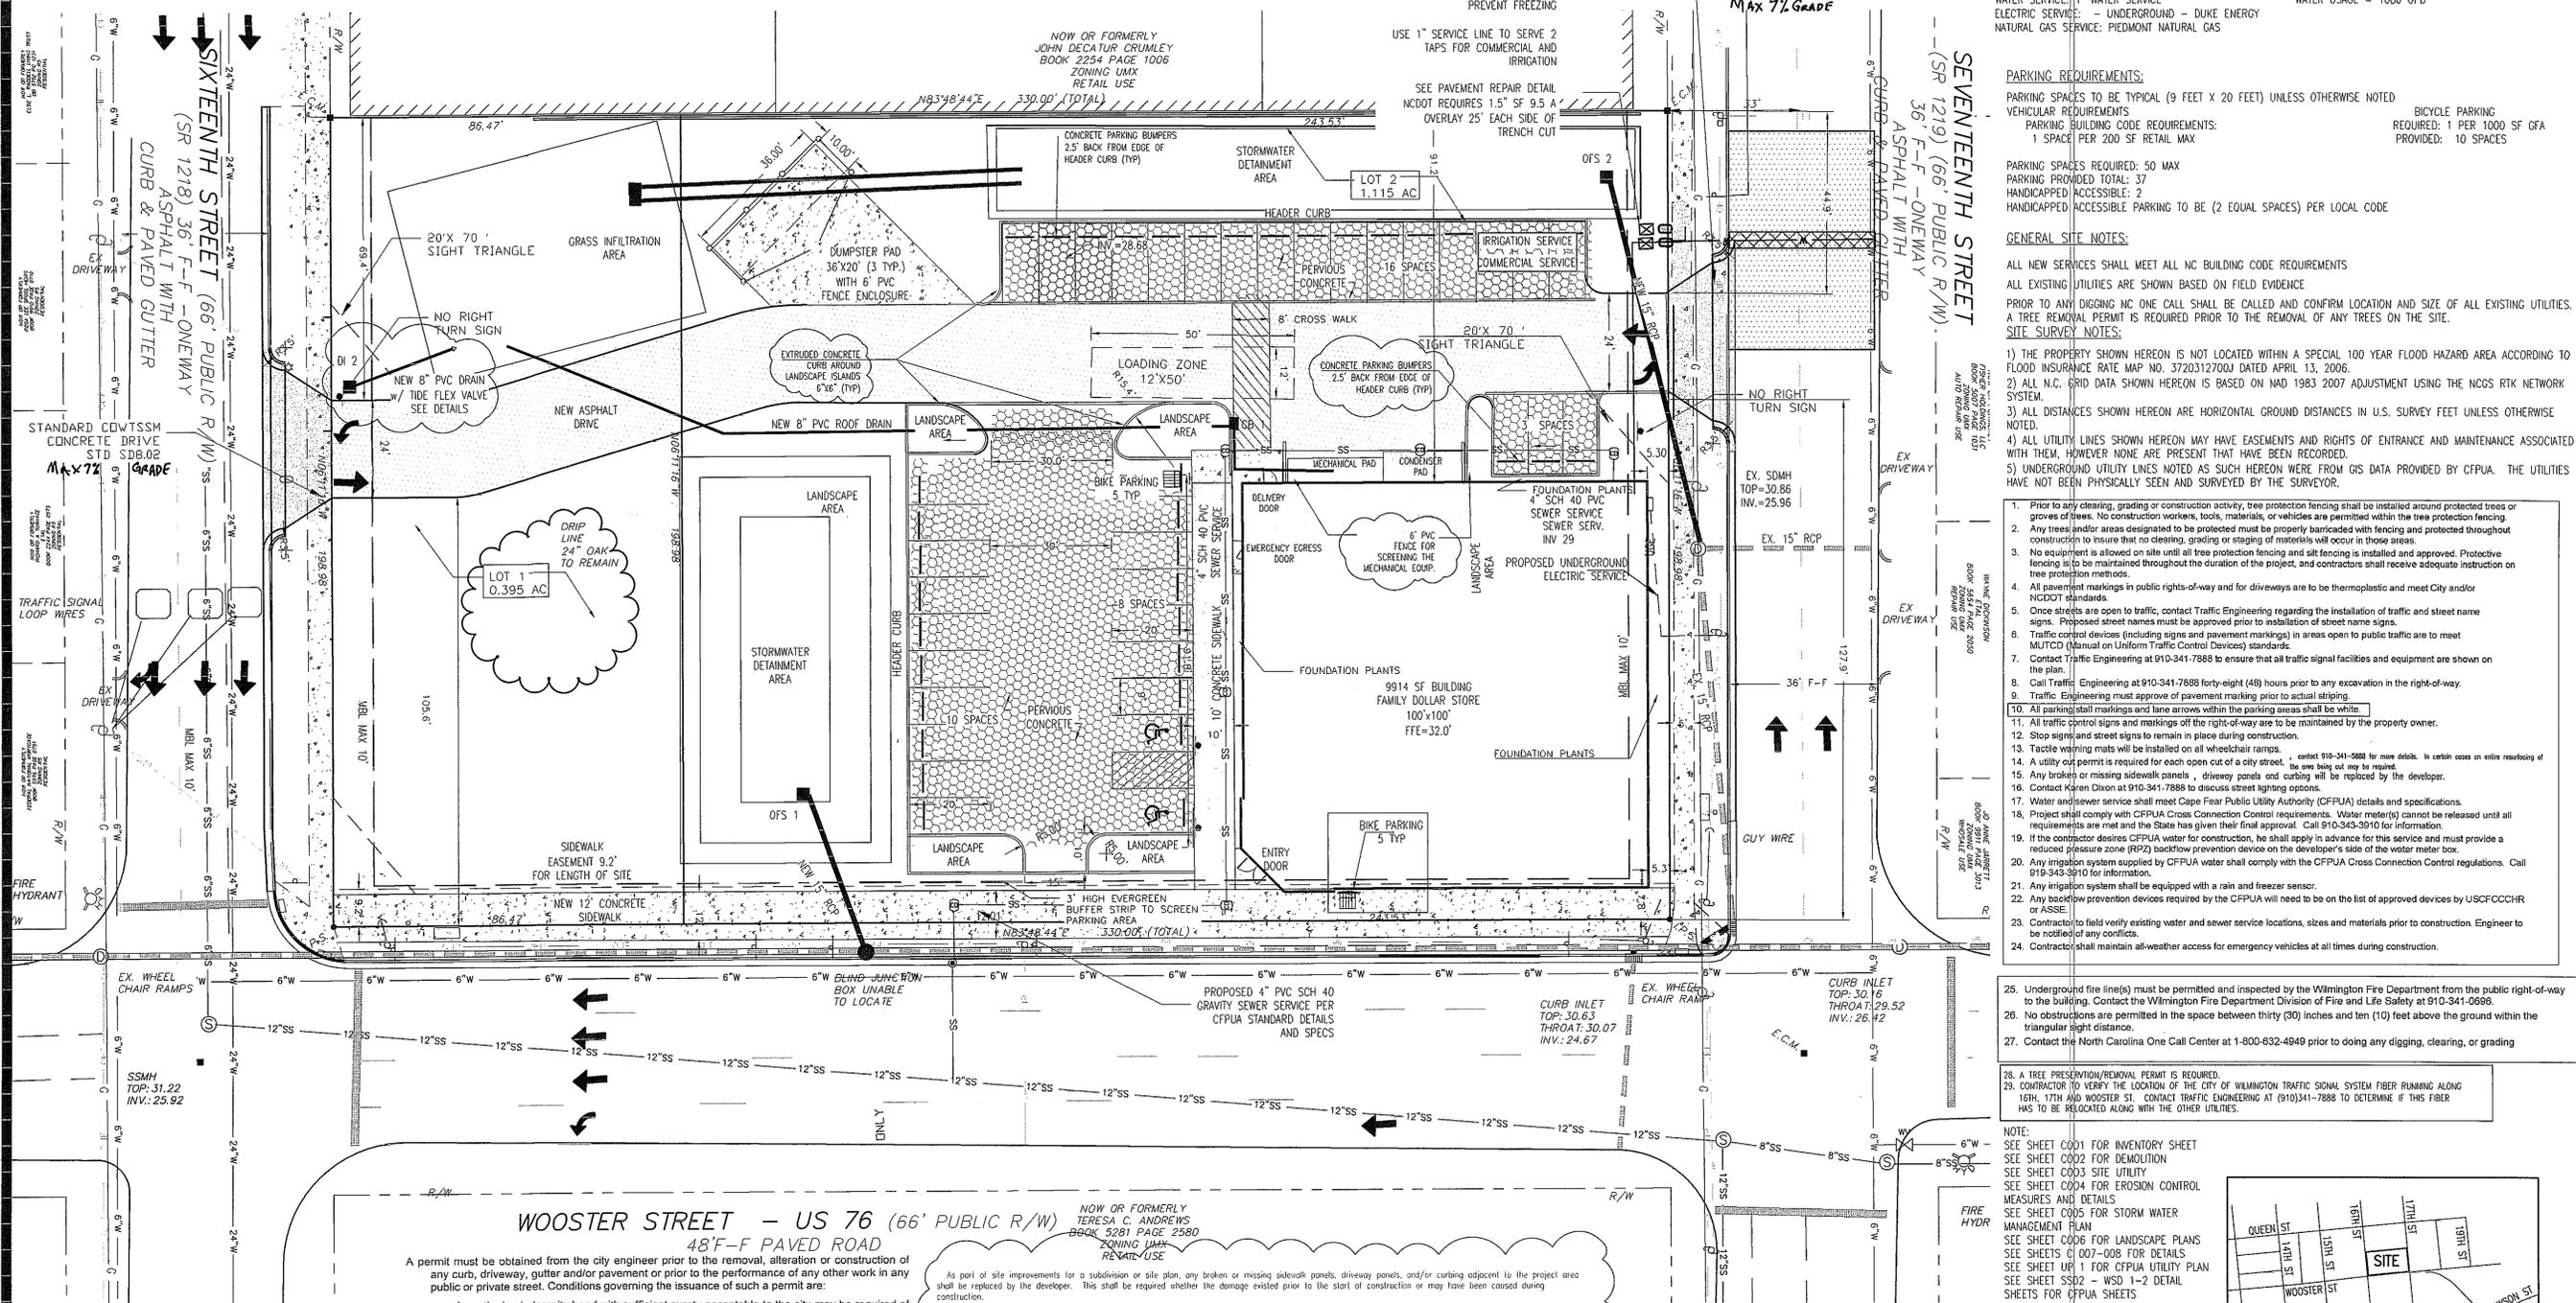

ZONING INFORMATION:
 PARCEL ID NO. - R05411-011-008-000 R05411-011-001-000
 TRACTS WILL BE RECOMBINED AND SUBDIVIDED PRIOR TO OBTAINING A CERTIFICATE OF OCCUPANCY.

SIGNAGE
 FREE STANDING MAX AREA = 35 SF MONUMENT
 WALL SIGN MAX AREA = 200 SF
 SIGNAGE WILL REQUIRE A SEPARATE PERMITTING AND REVIEW PROCESS THROUGH THE CITY ZONING DEPT.

TRANSPORTATION
 WOOSTER STREET - URBAN PRINCIPAL ARTERIAL
 16TH STREET - URBAN PRINCIPAL ARTERIAL
 17TH STREET - URBAN PRINCIPAL ARTERIAL

SIGHT LIGHTING
 ALL SIGHT LIGHTING SHALL BE LOCATED, ANGLED SHIELDED, AND OR LIMITED IN INTENSITY SO AS TO CAST NO DIRECT LIGHT UPON ADJACENT PROPERTIES, SHALL MINIMIZE OFF-SITE BACKLIGHTING GLARE, AND UP LIGHTING. LIGHT POST SHALL BE NO TALLER THAN TWELVE FEET.

UTILITIES:
 WATER LINE: CFPWA
 WASTEWATER SERVICE: 4" SEWER SERVICE
 WATER SERVICE: 1" WATER SERVICE
 ELECTRIC SERVICE: UNDERGROUND - DUKE ENERGY
 NATURAL GAS SERVICE: PIEDMONT NATURAL GAS

SEWER USAGE = 1080 GPD
 WATER USAGE = 1080 GPD

PARKING REQUIREMENTS:
 PARKING SPACES TO BE TYPICAL (9 FEET X 20 FEET) UNLESS OTHERWISE NOTED
 VEHICULAR REQUIREMENTS:
 PARKING BUILDING CODE REQUIREMENTS:
 1 SPACE PER 200 SF RETAIL MAX

BICYCLE PARKING
 REQUIRED: 1 PER 1000 SF GFA
 PROVIDED: 10 SPACES

PARKING SPACES REQUIRED: 50 MAX
 PARKING PROVIDED TOTAL: 37
 HANDICAPPED ACCESSIBLE: 2
 HANDICAPPED ACCESSIBLE PARKING TO BE (2 EQUAL SPACES) PER LOCAL CODE



GENERAL SITE NOTES:
 ALL NEW SERVICES SHALL MEET ALL NC BUILDING CODE REQUIREMENTS
 ALL EXISTING UTILITIES ARE SHOWN BASED ON FIELD EVIDENCE
 PRIOR TO ANY DIGGING NC ONE CALL SHALL BE CALLED AND CONFIRM LOCATION AND SIZE OF ALL EXISTING UTILITIES. A TREE REMOVAL PERMIT IS REQUIRED PRIOR TO THE REMOVAL OF ANY TREES ON THE SITE.

- SITE SURVEY NOTES:
- THE PROPERTY SHOWN HEREON IS NOT LOCATED WITHIN A SPECIAL 100 YEAR FLOOD HAZARD AREA ACCORDING TO FLOOD INSURANCE RATE MAP NO. 3720312700Q DATED APRIL 13, 2006.
 - ALL N.C. GRID DATA SHOWN HEREON IS BASED ON NAD 1983 2007 ADJUSTMENT USING THE NCGS RTK NETWORK SYSTEM.
 - ALL DISTANCES SHOWN HEREON ARE HORIZONTAL GROUND DISTANCES IN U.S. SURVEY FEET UNLESS OTHERWISE NOTED.
 - ALL UTILITY LINES SHOWN HEREON MAY HAVE EASEMENTS AND RIGHTS OF ENTRANCE AND MAINTENANCE ASSOCIATED WITH THEM, HOWEVER NONE ARE PRESENT THAT HAVE BEEN RECORDED.
 - UNDERGROUND UTILITY LINES NOTED AS SUCH HEREON WERE FROM GIS DATA PROVIDED BY CFPWA. THE UTILITIES HAVE NOT BEEN PHYSICALLY SEEN AND SURVEYED BY THE SURVEYOR.

- Prior to any clearing, grading or construction activity, tree protection fencing shall be installed around protected trees or groves of trees. No construction workers, tools, materials, or vehicles are permitted within the tree protection fencing.
- Any trees and/or areas designated to be protected must be properly barricaded with fencing and protected throughout construction to insure that no clearing, grading or staging of materials will occur in those areas.
- No equipment is allowed on site until all tree protection fencing and site fencing is installed and approved. Protective fencing to be maintained throughout the duration of the project, and contractors shall receive adequate instruction on tree protection methods.
- All pavement markings in public rights-of-way and for driveways are to be thermoplastic and meet City and/or NCDOT standards.
- Once streets are open to traffic, contact Traffic Engineering regarding the installation of traffic and street name signs. Proposed street names must be approved prior to installation of street name signs.
- Traffic control devices (including signs and pavement markings) in areas open to public traffic are to meet MUTCD (Manual on Uniform Traffic Control Devices) standards.
- Contact Traffic Engineering at 910-341-7888 to ensure that all traffic signal facilities and equipment are shown on the plan.
- Contact Traffic Engineering at 910-341-7888 forty-eight (48) hours prior to any excavation in the right-of-way.
- Traffic Engineering must approve of pavement marking prior to actual striping.
- All parking stall markings and lane arrows within the parking areas shall be white.
- All traffic control signs and markings off the right-of-way are to be maintained by the property owner.
- Stop signs and street signs to remain in place during construction.
- Traffic warning mats will be installed on all wheelchair ramps.
- A utility cut permit is required for each open cut of a city street. Contact 910-341-5888 for more details. In certain cases an entire resectioning of a city street may be required.
- Any broken or missing sidewalk panels, driveway panels and curbing will be replaced by the developer.
- Contact Karen Dixon at 910-341-7888 to discuss street lighting options.
- Water and sewer service shall meet Cape Fear Public Utility Authority (CFPUA) details and specifications.
- Project shall comply with CFPWA Cross Connection Control requirements. Water meter(s) cannot be released until all requirements are met and the State has given their final approval. Call 910-343-3910 for information.
- If the contractor desires CFPWA water for construction, he shall apply in advance for this service and must provide a reduced pressure zone (RPZ) backflow prevention device on the developer's side of the water meter box.
- Any irrigation system supplied by CFPWA water shall comply with the CFPWA Cross Connection Control regulations. Call 910-343-3910 for information.
- Any irrigation system shall be equipped with a rain and freeze sensor.
- Any backflow prevention devices required by the CFPWA will need to be on the list of approved devices by USCFOCHR or ASSE.
- Contractor to field verify existing water and sewer service locations, sizes and materials prior to construction. Engineer to be notified of any conflicts.
- Contractor shall maintain all-weather access for emergency vehicles at all times during construction.

- Underground fire line(s) must be permitted and inspected by the Wilmington Fire Department from the public right-of-way to the building. Contact the Wilmington Fire Department Division of Fire and Life Safety at 910-341-0698.
- No obstructions are permitted in the space between thirty (30) inches and ten (10) feet above the ground within the triangular sight distance.
- Contact the North Carolina One Call Center at 1-800-632-4949 prior to doing any digging, clearing, or grading.

NOTE:
 SEE SHEET C001 FOR INVENTORY SHEET
 SEE SHEET C002 FOR DEMOLITION
 SEE SHEET C003 SITE UTILITY
 SEE SHEET C004 FOR EROSION CONTROL MEASURES AND DETAILS
 SEE SHEET C005 FOR STORM WATER MANAGEMENT PLAN
 SEE SHEET C006 FOR LANDSCAPE PLANS
 SEE SHEETS C100-008 FOR DETAILS
 SEE SHEET U1 FOR CFPWA UTILITY PLAN
 SEE SHEET SS02 - WSD 1-2 DETAIL SHEETS FOR CFPWA SHEETS

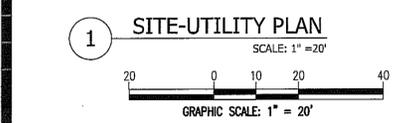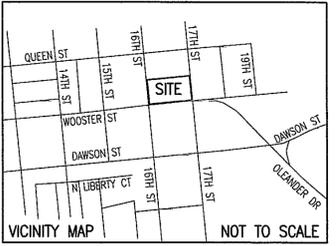

1 SITE-UTILITY PLAN
 SCALE: 1" = 20'

WOOSTER STREET - US 76 (66' PUBLIC R/W)
 48'-F PAVED ROAD

A permit must be obtained from the city engineer prior to the removal, alteration or construction of any curb, driveway, gutter and/or pavement or prior to the performance of any other work in any public or private street. Conditions governing the issuance of such a permit are:

- A continuing indemnity bond with sufficient surety acceptable to the city may be required of the party performing the work. All work must be done in conformity with the standards established herein.
- The city shall be indemnified for any damages it might sustain as a result of the breach of condition above. The damages payable to the city shall be the amount required to make such improvement conform to city standards.
- A fee in accordance with the city's adopted fee schedule shall be paid to the city at the time the application for a driveway permit is made.

As part of site improvements for a subdivision or site plan, any broken or missing sidewalk panels, driveway panels, and/or curbing adjacent to the project area shall be replaced by the developer. This shall be required whether the damage existed prior to the start of construction or may have been caused during construction.

- Per the requirements of the stormwater permit, the following shall occur prior to issuance of a certificate of occupancy or operation of the permitted facility.
 - As-built drawings for all stormwater management facilities shall be submitted to the City of Wilmington Engineering Division.
 - An Engineer's certification shall also be submitted, along with all supporting documentation that specifies, under seal that the as-built stormwater measures, controls and devices are in compliance with the approved stormwater management plans.
 - A final inspection by City of Wilmington Engineering personnel.
 - All required assessment maps shall be reviewed by City staff and recorded prior to issuance of a certificate of occupancy.

APPLICANT STATEMENT:
 A. THERE ARE NO EXISTING EASEMENT OR OTHER RESTRICTIONS ON THE PROPERTY WHICH THE APPLICANT IS AWARE OF HOWEVER THE APPLICANT IS PROPOSING A BMP EASEMENT FOR THE PROPOSED BMP ON THE SITE AS WELL AS A SIDEWALK ENCROACHMENT AND MAINTENANCE EASEMENT.
 B. THERE IS CURRENTLY PUBLIC SEWER, WATER AND STREETS AVAILABLE TO THIS SITE FOR USE.
 C. BASED ON THE DATA COLLECTED, IN THE OPINION OF THE APPLICANT THE ONLY PROBLEM IS THE SIDE YARD/ FRONT YARD MAX 10' SET BACK OFF 16TH STREET. THIS SITE HAS NO INTENTIONS OF PLACING ANOTHER BUILDING.




FAMILY DOLLAR STORE
 S. 17TH ST.
 722 S. 17TH STREET
 WILMINGTON, NC

SITE UTILITY PLAN

EASTERN PRIDE, INC.
 2405-F NASH ST.
 WILSON, NC 27896

RECEIVED
 JUN 27 2014
 PLANNING DIVISION

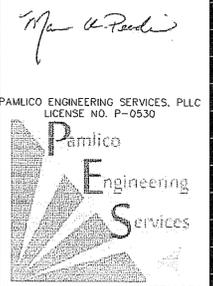

PAMLICO ENGINEERING SERVICES
 128 Abbey Lane
 Washington, NC 27889
 252-945-2983
 pmes@pamlicoengineeringservices.com

REVISIONS	Date	Description
1	5/26/14	REVISED FROM TRC REV. 1
2	5/26/14	ADDED BIKE RACK AND FOUNDATION PLANTINGS, ADD ADDED NOTES AND OTHER COW COMMENTS AND REVIEW
3	5/15/14	REVISED IMPERVIOUS AREA AND ADDED ENG NOTES
4	5/20/14	ADDED SCREENING FENCE TO WEST SIDE OF MECHANICAL
5	6/7/14	MODIFIED SEWER SERVICE LOCATIONS

File No. 14001
 Scale: 1" = 20'
 Sheet No. C-003

LANDSCAPE LEGEND						
KEY	QTY	SCIENTIFIC NAME	COMMON NAME	PLANTING SIZE	CATEGORY	TYPE
RB	3	Betula nigra	River BIRCH	8 7/2" col.	TREES(LARGE)	DECIDUOUS
CM	34	LAGERSTEMIA	CREPE MYRTLE	8 7/2" col.	SMALL TREE	DECIDUOUS
TM	16	ACER BUERGERIANUM	TRIDENT MAPLE	8 7/2" col.	TREES(LARGE)	DECIDUOUS
NH	28	ILEX CORNUTA	NEEDLEPOINT HOLLY	36" 7 gal.	LOW BUFFER	EVERGREEN
JH	78	Rhaphiolepis indica	Indian Hawthorn	18" 3 gal.	SHRUB(SMALL)	EVERGREEN
BW	98	BUXUS SINICA	WINTERGREEN BOXWOOD	18" 3 gal.	SHRUB(SMALL)	EVERGREEN
IC	8	CUPRESSUS SEMPERVIRENS	ITALIAN CYPRESS	10" 3" CAL	TREE	EVERGREEN
MN	44	NANDINA DOMESTICA	MINIATURE NANDINA	18" 3 gal.	SHRUB(SMALL)	EVERGREEN
LB	28	LOROPETALUM CHINESE RUBRUM	LOROPETALUM BLUSH	18" 3 gal.	SHRUB(SMALL)	EVERGREEN
WM	8	MYRICA CERIFERA	WAX MYRTLE	30" 3 GAL.	SHRUB	EVERGREEN
JFC	17	PRUNUS SERRULATA	JAPANESE FLOWERING CHERRY	8 7/2" col.	TREE	DECIDUOUS

LANDSCAPE CALCULATIONS:
STREET TREES
 LINEAR FOOTAGE OF ROAD FRONTAGE = 728 LF - 48LF = 680 LF
 STREET TREES - 1/30LF = 23 TREES IN ROW PROVIDED

SHADE REQUIREMENTS
 PARKING AND DRIVE IMPERVIOUS AREA = 10,495 SF
 20% X 10495 = 2099 SF REQUIRED
 SA = 4244 SF PROVIDED

LANDSCAPE AREA PROVIDED = 1542 SF (LSA)

FOUNDATION PLANTINGS AREA

	REQUIRED	PROVIDED
FRONT = 84.5 X 20 X 0.12 =	203 SF	209 SF
NORTH SIDE = 100 X 15 X 0.12 =	180 SF	248 SF
EAST SIDE = 100 X 20 X 0.12 =	180 SF	530 SF

TREE MITIGATION CALCS
 25" OAK X 2 (100%) = 50 50/3 = 17 TREES 17 TREES

STREET YARD BUFFER 16TH AND WOOSTER STREETS
 528 LF - 24" - 100" = 404 LF X 18" = 7272 SF TOTAL REQUIRED

	REQUIRED	PROVIDED
7222 / 600 =	12	12
SHADE TREE	12	12
SHRUBS (6)	72	72

- LANDSCAPE NOTES**
- LOCATE ALL EXISTING UTILITIES PRIOR TO INSTALLATION OF PLANT MATERIAL. NOTIFY ENGINEER OF ANY DISCREPANCIES BETWEEN FIELD CONDITIONS AND THOSE SHOWN IN PLAN.
 - ALL PLANT MATERIAL SHALL CONFORM WITH THE STANDARDS SET FORTH BY THE AMERICAN ASSOCIATION OF NURSERYMEN AND THE WRITTEN SPECIFICATIONS.
 - PLANTING BEDS TO BE MULCHED WITH A MINIMUM OF 3" LONGLEAF PINESTRAW. ALL PLANT GROUPINGS SHALL BE MULCHED AS ONE BED.
 - ESTABLISH POSITIVE DRAINAGE IN ALL PLANTING BEDS AND AWAY FROM BUILDINGS.
 - APPLY PRE-EMERGENT HERBICIDE TO ALL NEW PLANTING BEDS AS MANUFACTURER'S RECOMMENDED RATE PRIOR TO INSTALLATION OF MULCH.
 - DO NOT INSTALL PLANT MATERIAL IN IMPERVIOUS SOILS (i.e. HOLES WHICH, WHEN FILLED WITH WATER, DO NOT COMPLETELY DRAIN WITHIN TWO HOURS).
 - ALL LANDSCAPING IS SUBJECT TO THE CITY ZONING ORDINANCE AND ANY MODIFICATIONS MADE SHALL MEET ALL REQUIREMENTS SET FORTH BY THE ZONING CODE.
 - THE AREA WITHIN THE SIGHT TRIANGLE SHALL BE MAINTAINED FREE OF ALL OBSTRUCTIONS BETWEEN 30' AND 10'.
 - LANDSCAPE SHALL BE COMPLETE BEFORE ISSUANCE OF A FINAL CD.
 - A RAIN/FREEZE SENSOR SHALL BE USED IF THERE IS AN IRRIGATION SYSTEM.
 - ALL PLANTED AND RETAINED MATERIAL REQUIRED TO MEET THE PROVISIONS OF THE CITY OF WILMINGTON LAND DEVELOPMENT CODE SHALL BE PERPETUALLY PROTECTED AND MAINTAINED TO PROFESSIONALLY ACCEPTED STANDARDS BY JOINT AND SEVERAL RESPONSIBILITY OF THE OWNER, TENANT AND RESPECTIVE AGENTS OF THE PROPERTY ON WHICH THE MATERIAL IS LOCATED.
 - CREATIVE STANDARD: TO PROMOTE CREATIVE DESIGNS, STREET YARDS MAY CONSIST OF TREES AND SHRUBBERY WHICH COVER AT LEAST 50% OF ITS AREA.

DEVELOPER
 EASTERN PRIDE, INC.
 2405-F WASH STREET
 WILSON, NC 27896

OWNER
 THOMSON REALTY INVEST LP
 910 SAND MILLS BLVD
 ABERDEEN, NC 28315

GENERAL CONTRACTOR:
 STOCKS AND TAYLOR CONSTRUCTION, INC.
 1825 CAROLINA AVENUE
 WASHINGTON, NC 27889

GENERAL BUILDING INFORMATION
 BUILDING USE: COMMERCIAL - RETAIL
 TOTAL LOT SIZE = 1.51 AC
 LOT 1 = 0.935 AC TO R/W
 LOT 2 = 1.115 AC TO R/W
 BUILDING SIZE: 9,914 SF

7427 SF RETAIL, 2487 SF OTHER
 BUILDING HEIGHT: 20 FT
 BUILDING CONSTRUCTION TYPE = V-B



BUILDING LOT COVERAGE
 9914SF / 65,775.6SF = 15.07%
 NO. OF BUILDINGS = 1

TOTAL IMPERVIOUS AREA
 BUILDING = 9914.00 SF
 SIDEWALK (ONSITE) = 1228.74 SF
 PAVEMENT = 10,495.00 SF
 PERVIOUS PAVEMENT = 10,631.00 SF
 SIDEWALK (ON SITE ALONG WOOSTER) = 2640.00 SF

TOTAL IMPERVIOUS AREA = 34,908.74 SF
TOTAL GREEN SPACE = 30,867.8 SF

TOTAL PERVIOUS PAVEMENT = 10,631 SF
 % IMPERVIOUS EXISTING = 000%
 % IMPERVIOUS PROPOSED = 34,908.74 / 65775.6 = 53%
 (WITH NO CREDIT FOR PERVIOUS PAVEMENT)

- GENERAL NOTES**
- ANY EXISTING ROOTS EXPOSED BY CONSTRUCTION ACTIVITY SHALL BE SEVERED CLEANLY WITH A PRUNING TOOL.
 - DO NOT DISPOSE OF ANY CHEMICALS, PETROLEUM PRODUCTS, OR REMOVE SOIL ANY OUTSIDE THE LIMIT OF WORK.
 - LANDSCAPE CONTRACTOR SHALL BE RESPONSIBLE FOR DETERMINING THE LOCATION OF ALL UNDERGROUND UTILITIES AND SHALL BE RESPONSIBLE FOR REPAIRING DAMAGE TO ANY UTILITIES AS A RESULT OF INSTALLING ANY LANDSCAPE MATERIALS.
 - THE ONLY EXISTING TREE IS THE 24" OAK AS SHOWN TO REMAIN. ALL OTHER TREES AND SHRUBS ARE NEW.
- Note on plan stating that prior to any clearing, grading, or construction activity, tree protection fencing will be installed around protected trees or groves of trees. No construction workers, tools, materials, or vehicles are permitted within the tree protection fencing.

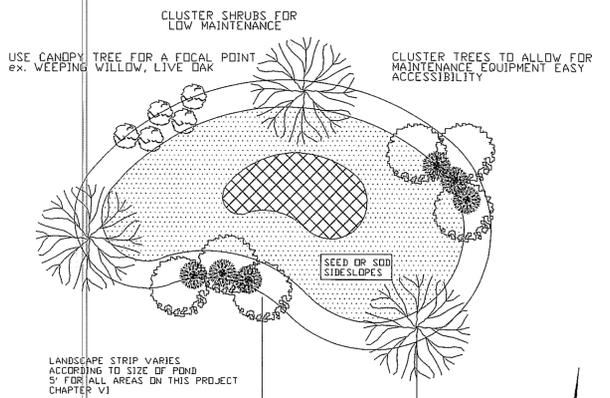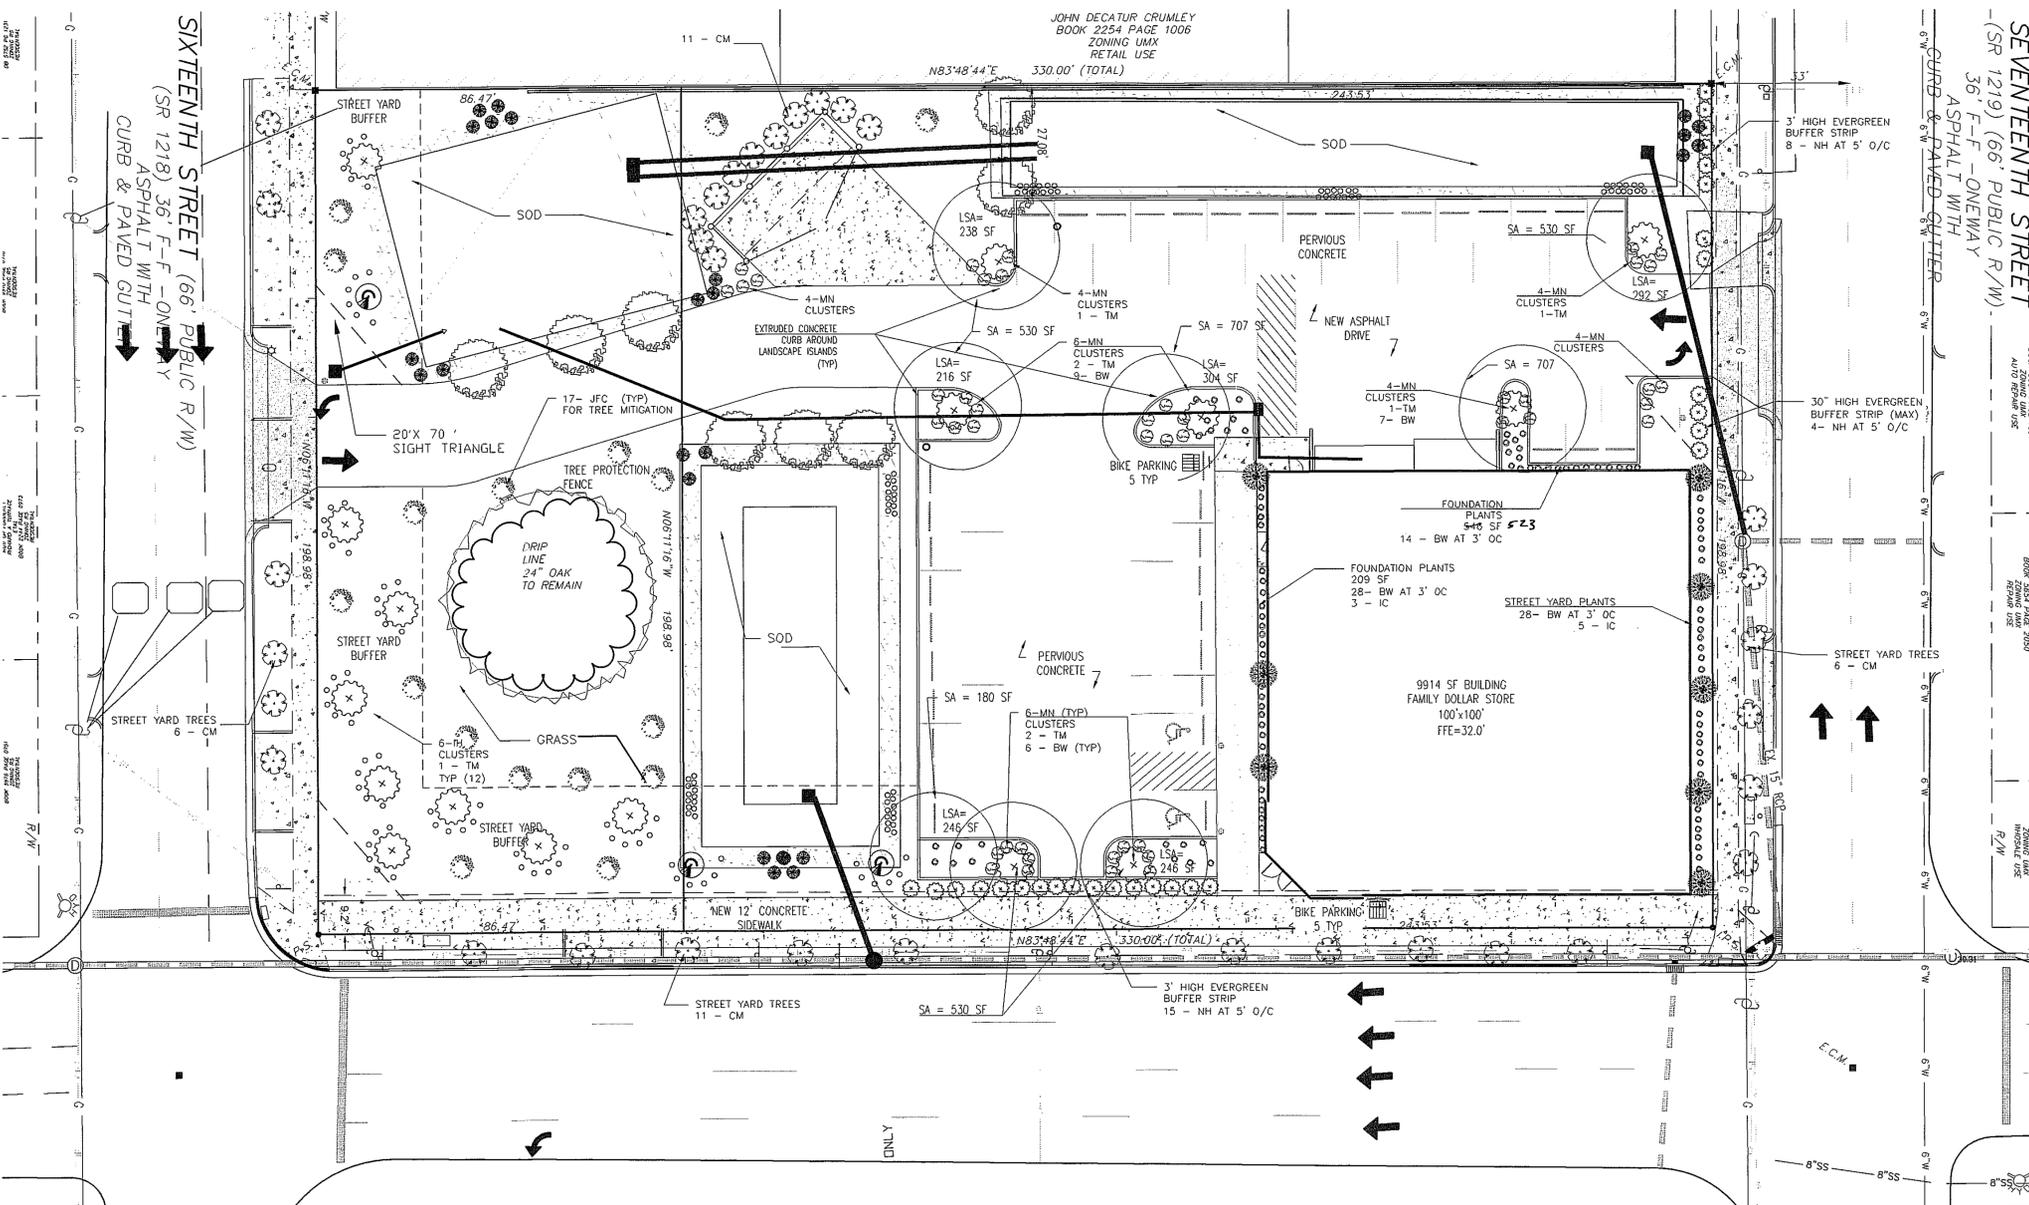

APPROVED CONSTRUCTION PLAN

NAME _____ DATE _____

PLANNING _____

TRAFFIC _____

FIRE _____


STORMWATER MANAGEMENT PLAN

APPROVED _____

CITY OF WILMINGTON ENGINEERING DEPARTMENT

DATE PERMIT # _____

SIGNED _____

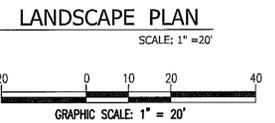


Designed MUP
 Drawn MSP
 Checked MUP
 Approved MARIE U. PEEDIN

LANDSCAPE PLAN

FAMILY DOLLAR STORE
S. 17TH ST.
722 S. 17TH STREET
WILMINGTON, NC

EASTERN PRIDE, INC.
 2405-F WASH ST.
 WILSON, NC 27896

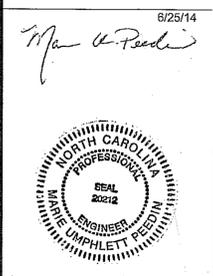

Pamlico Engineering Services, PLLC
 LICENSE NO. P-0530

Pamlico Engineering Services

PAMLICO ENGINEERING SERVICES
 128 Abbey Lane
 Washington, NC 27889
 252-945-2983
 mpeedin@pamlicoengineeringservices.com

REVISIONS	Date	Description
1	5/9/14	REVISED PER CDW COMMENTS 4/22/14
2	6/7/14	REVISED PER PLANNING COMMENTS AND URBAN FORESTOR
3	6/7/14	REVISED PLANT SCHEDULE PER PLANNING COMMENTS
4	6/7/14	REVISED PARKING AREA AND LANDSCAPE AREA TO AVOID RIGHT TRIANGLE - EAST SIDE DRIVE

File No. 14001
 Scale: 1" = 20'
 Sheet No. **C-006**