



1 NORTH ELEVATION
A6.1 SCALE 1/16" = 1'-0"

EXTERIOR FINISH LEGEND

EEF-001 EIFS - COLOR 1	ALJ-09 LIGHT STRIP
EEF-002 EIFS - COLOR 2	ALJ-10 LIGHT STRIP
EEF-003 EIFS - COLOR 3	EXTERIOR WALL PANEL
EEF-004 EIFS - COLOR 4	EXISTING BRICK VENEER
EEF-005 EIFS - COLOR 5	

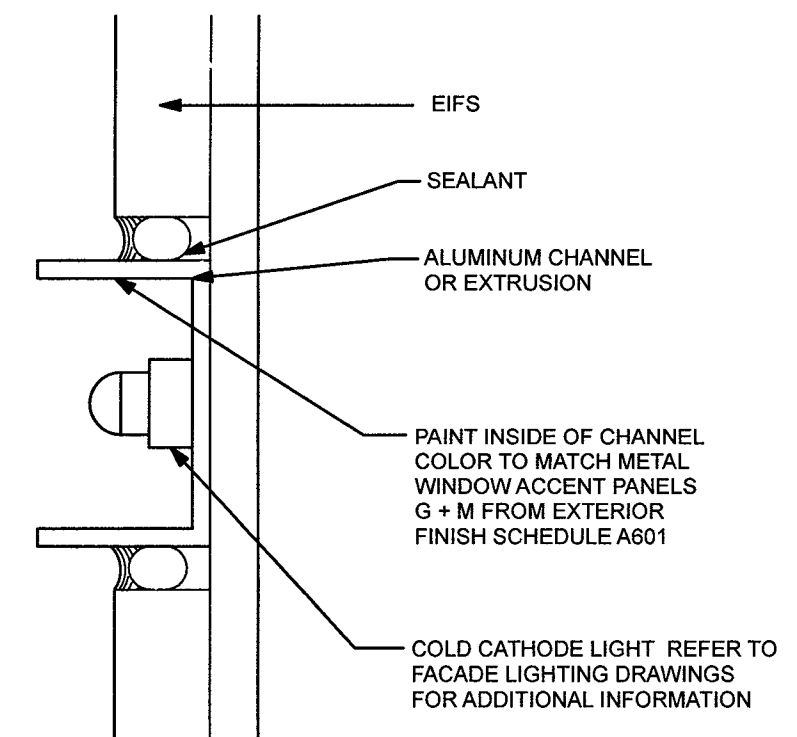

4 FACADE DETAIL
A6.1 SCALE 3" = 1'-0"


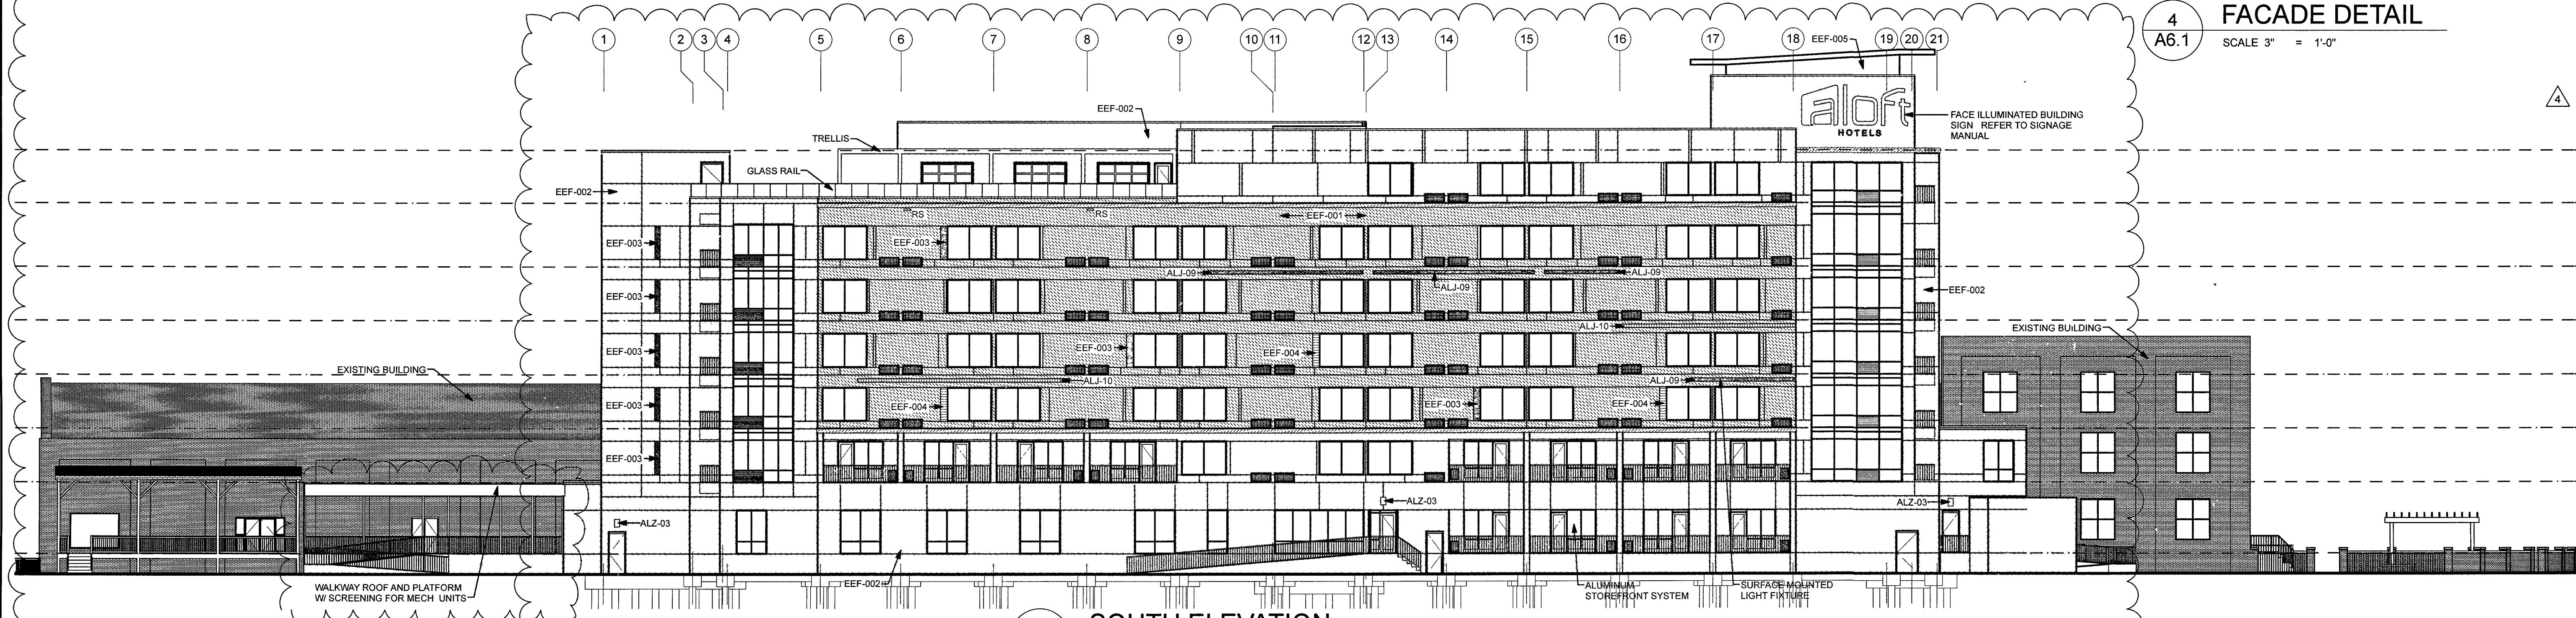


2 SOUTH ELEVATION
A6.1 SCALE 1/16" = 1'-0"

ALL CONTRACTORS AND SUB-CONTRACTORS SUBMITTING BIDS ON THIS PROJECT SHALL BE REQUIRED TO RECEIVE THE ENTIRE SET OF DRAWINGS. BROKEN SETS ARE NOT ALLOWED FOR BIDDING PROJECTS.
UNLESS OTHERWISE NOTED, DRAWINGS TO BE SCALED !!

DATE	REVISIONS	BY	RCW
9/17/17	(1) - OWNER REQUESTED REVISIONS	RCW	RCW
1/28/18	(2) - OWNER REQUESTED REVISIONS	RCW	RCW
1/28/18	(3) - OWNER REQUESTED REVISIONS	RCW	RCW
5/1/18	(4) - MARRIOTT 90% REVIEW COMMENTS	RCW	RCW

PROJ #	DATE	APPROVED	DATE
15030	06/02/17	RCW	RCW

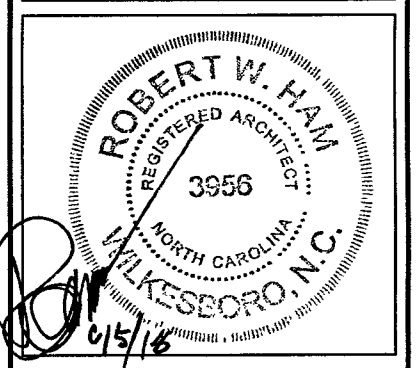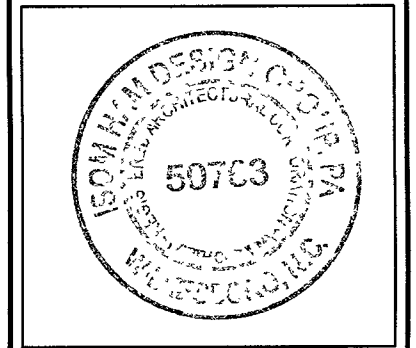

QUALITY FIRST


isom ham
DESIGN GROUP, P.A.
Architecture - Planning
1308 Collegiate Drive, Wileysboro, NC 28697
www.isomham.com

NORTH CAROLINA


EXTERIOR ELEVATIONS

aloft
HOTELS

SHEET
A6.1

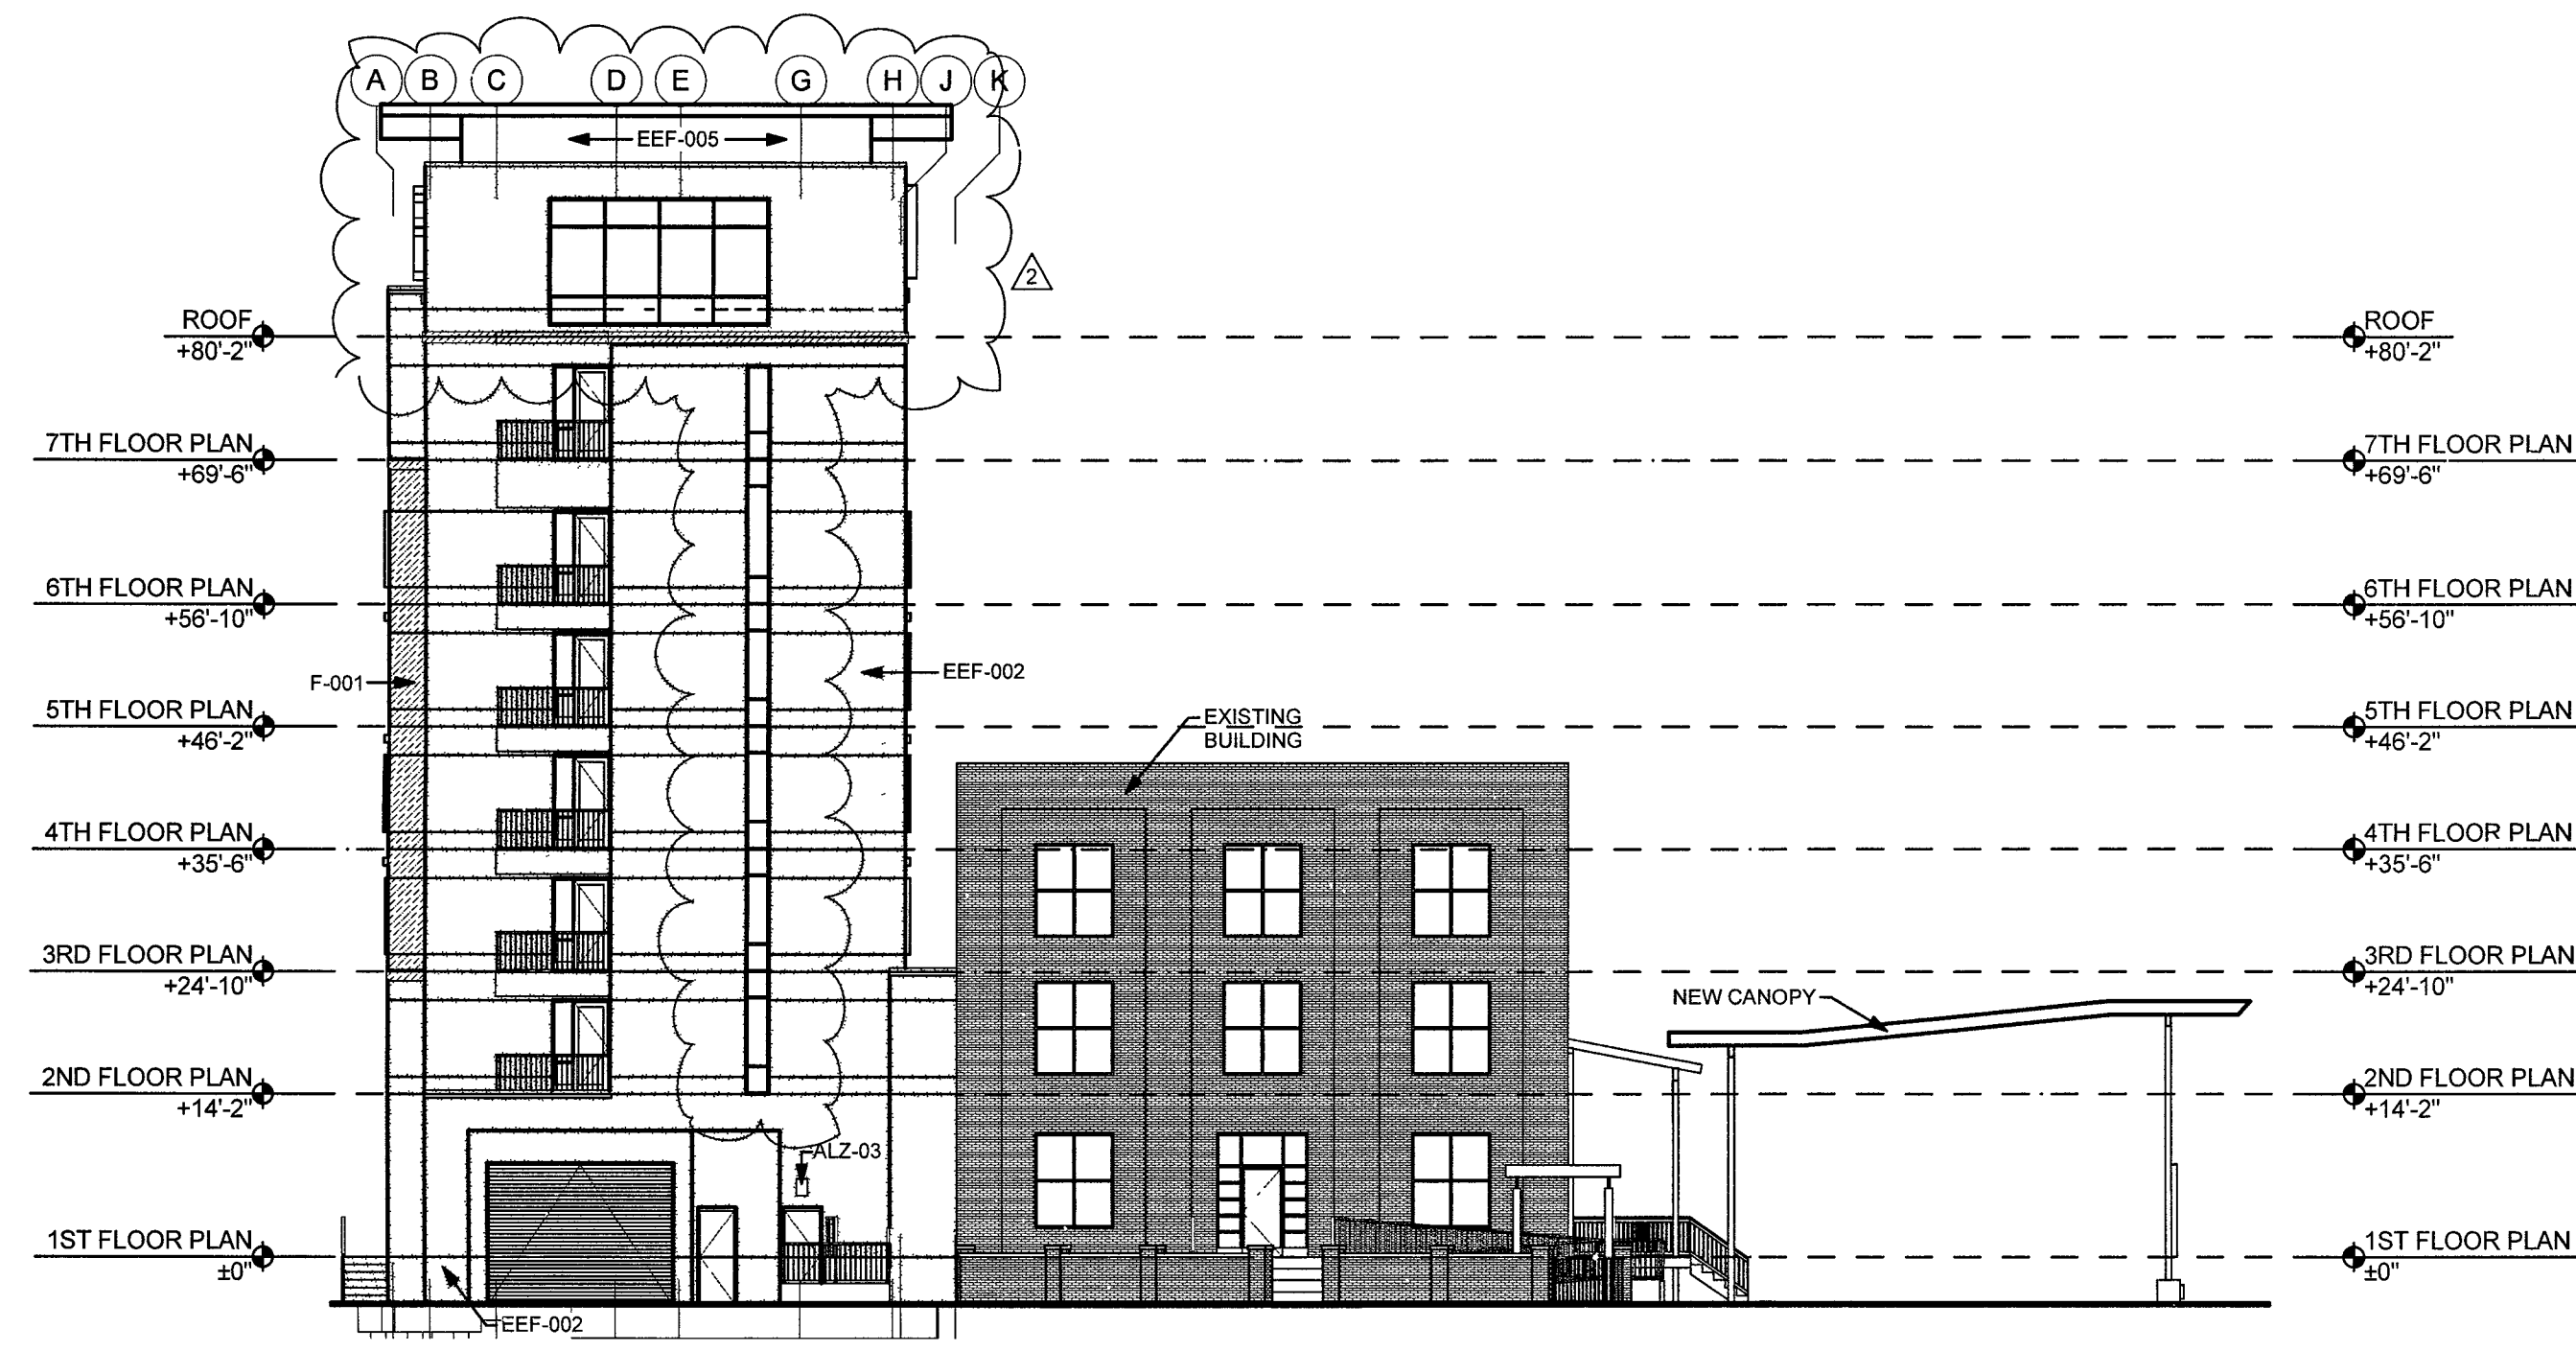

1 EAST ELEVATION
A6.2 SCALE 1/16" = 1'-0"

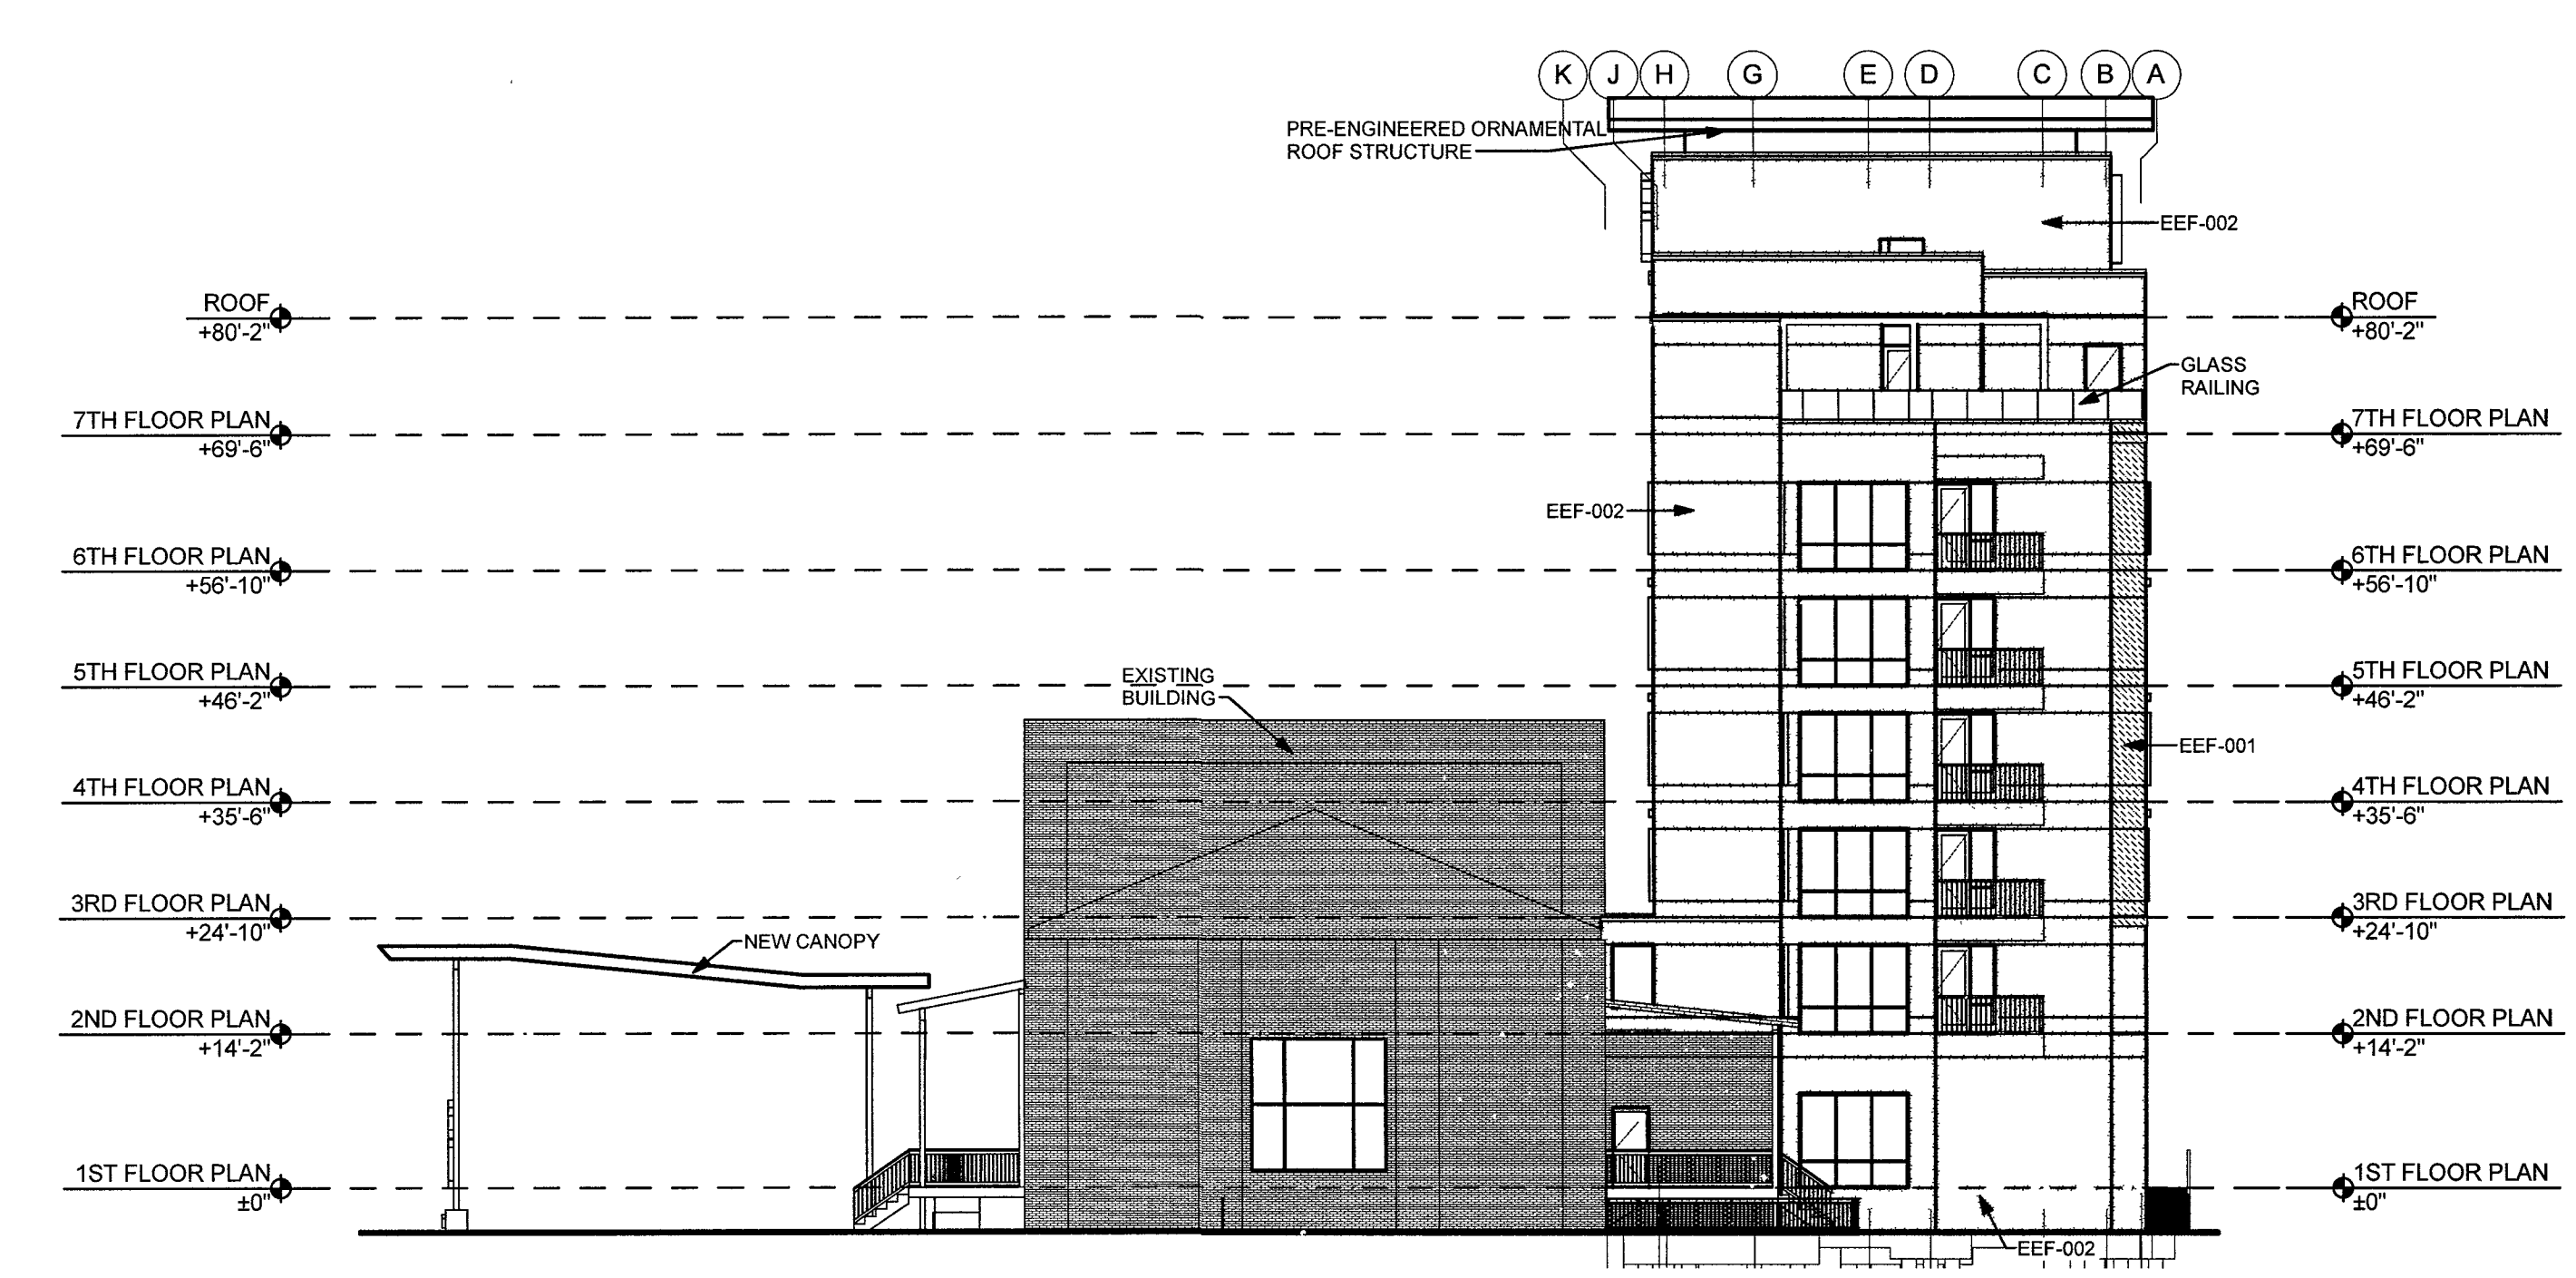



2 WEST ELEVATION
A6.2 SCALE 1/16" = 1'-0"

EXTERIOR FINISH LEGEND

EEF-001 EIFS - COLOR 1	ALJ-09 LIGHT STRIP
EEF-002 EIFS - COLOR 2	ALJ-10 LIGHT STRIP
EEF-003 EIFS - COLOR 3	EXTERIOR WALL PANEL
EEF-004 EIFS - COLOR 4	EXISTING BRICK VENEER
EEF-005 EIFS - COLOR 5	

BY	RCW	RCW	RCW	RCW
REVISIONS	(1) - OWNER REQUESTED REVISIONS	(2) - OWNER REQUESTED REVISIONS	(3) - MARRIOTT 90% REVIEW COMMENTS	
DATE	9/17/17	1/25/18	9/1/18	

DRAWN BY	APPROVED
RCW	RWH
PROJ #	DATE
15030	09/02/17

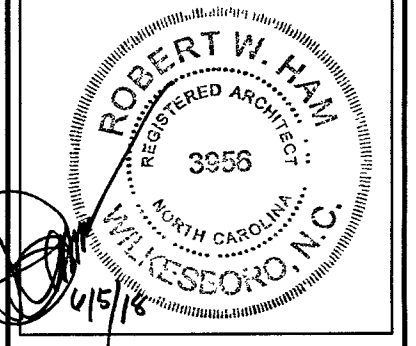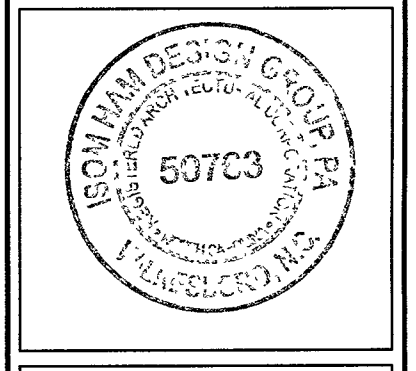

QUALITY FIRST

isom ham
DESIGN GROUP, P.A.
Architecture - Planning
1309 Collegiate Drive, Wilkesboro, NC 28687 www.isomham.com

EXTERIOR ELEVATIONS

Aloft
HOTELS

NORTH CAROLINA

WILMINGTON

ALL CONTRACTORS AND SUB-CONTRACTORS SUBMITTING BIDS ON THIS PROJECT SHALL BE REQUIRED TO RECEIVE THE ENTIRE SET OF DRAWINGS. BROKEN SETS ARE NOT ALLOWED FOR BIDDING PROJECTS. UNDER NO CIRCUMSTANCES ARE THE DRAWINGS TO BE SCALED !!

SHEET
A6.2