RIVERLIGHTS

MARINA VILLAGE- PHASE 1B

CITY OF WILMINGTON, NC

MARCH 17, 2016 (REVISED SEPT. 21, 2016)

ISSUED FOR CONSTRUCTION

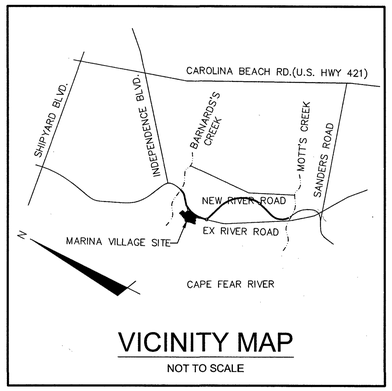

VICINITY MAP

NOT TO SCALE

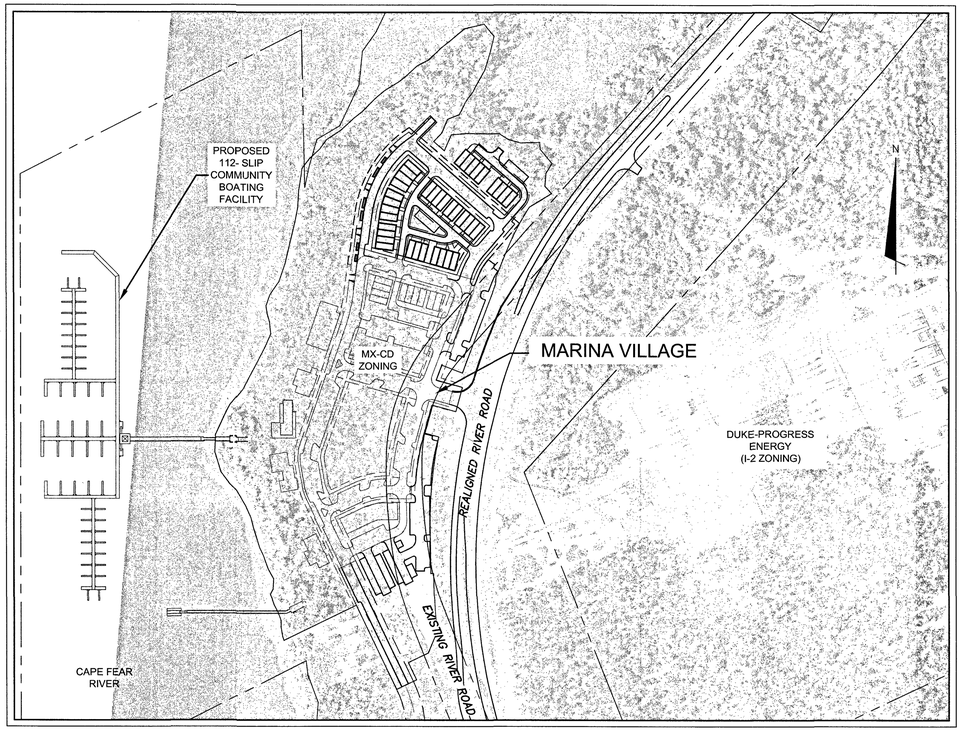

VICINITY MAP

1"=200'

CITY AND AGENCY CONTACTS

A. City of Wilmington
Planning Department
102 North Third Street
PO BOX 1810
Wilmington, NC 28402-1810
(910)341-7800
Contact: Ron Satterfield
Email: Ron.Satterfield@wilmingtonnc.gov

B. City of Wilmington
Engineering
212 Operations Center Drive
PO BOX 1810
Wilmington, NC 28402-1810
(910) 341-7807
Contact: Rob Gordon
Email: Rob.Gordon@wilmingtonnc.gov

C. New Hanover County
Sediment and Erosion Control
230 Government Center Drive, Suite 160
Wilmington, NC 28403
(910) 798-7432
Contact: Beth Wetherill
Email: BWetherill@nhcgov.com

D. Cape Fear Public Utility Authority
235 Government Center Drive
Wilmington, NC 28403
(910) 332-6626
Contact: David Dailey
Email: David.Dailey@cfpua.org

E. NCDENR
Division of Environmental Health
Public Water Supply Section
1634 Mail Service Center
Raleigh, NC 27699-1634
(919) 707-9075
Contact: Christyn Fertenbaugh
Email: christyn.fertenbaugh@ncdenr.gov

PROJECT DATA

NAME OF PROJECT:
RIVERLIGHTS - MARINA VILLAGE PHASE 1B
WILMINGTON, NORTH CAROLINA

OWNER/DEVELOPER:
NNP IV-CAPE FEAR RIVER, LLC
3410 RIVER ROAD, SUITE 103
WILMINGTON, NC 28412
PHONE: (704)813-8697
CONTACT: DOUG BROWN

PREPARED BY:
MCKIM & CREED, INC
243 NORTH FRONT ST
WILMINGTON, NC 28401
PHONE: (910)343-1048
FAX: (910)251-8282
CONTACT: NICK LAURETTA, PE, LEED AP
EMAIL: NLAURETTA@MCKIMCREED.COM

SHEET INDEX		
SHEET NUMBER	SHEET TITLE	SHEET DESCRIPTION
1	G-001	COVER
2	G-002	ABBREVATIONS & LEGEND
3	G-003	GENERAL NOTES
4	CX-101	EXISTING CONDITIONS SITE INVENTORY MAP
5	CX-102	TREE REMOVAL PLAN
~~6~~	~~GE-101~~	~~PHASE 1 SEDIMENT & EROSION CONTROL PLAN~~
~~7~~	~~GE-102~~	~~PHASE 2 SEDIMENT & EROSION CONTROL PLAN~~
8	CG-101	GRADING PLAN NORTH
9	CG-102	GRADING PLAN SOUTH
10	CG-103	STORM DRAINAGE PLAN
11	CS-100	OVERALL SITE PLAN
12	CS-101	SITE PLAN
13	CS-102	SITE PLAN NORTH
14	CS-103	SITE PLAN SOUTH
15	CU-101	UTILITY PLAN
~~15A~~	~~CU-102~~	~~UTILITY PROFILE INDEX SHEET~~
16	CU-701	PLAN AND PROFILE
17	CU-702	PLAN AND PROFILE
18	CU-703	PLAN AND PROFILE
19	L-160	OVERALL PLANTING PLAN SHEET REFERENCE
20	L-161	PLANTING PLAN NORTH
21	L-162	PLANTING PLAN SOUTH
22	L-501	LANDSCAPE DETAILS
23	CN-501	STORMWATER MANAGEMENT DETAILS
24	CT-301	ROADWAY SECTIONS
~~25~~	~~GE-501~~	~~SEDIMENT & EROSION CONTROL DETAILS~~
~~26~~	~~GE-502~~	~~SEDIMENT & EROSION CONTROL DETAILS~~
27	CS-501	SITE DETAILS
28	CS-502	SITE DETAILS
29	CG-501	STORMWATER DRAINAGE DETAILS
30	CG-502	STORMWATER DRAINAGE DETAILS
31	CG-503	STORMWATER DRAINAGE DETAILS
~~32~~	~~WSD-1~~	~~UTILITY DETAILS~~
~~33~~	~~WSD-2~~	~~UTILITY DETAILS~~
~~34~~	~~SSD-1~~	~~UTILITY DETAILS~~
~~35~~	~~SSD-2~~	~~UTILITY DETAILS~~
~~36~~	~~SSD-3~~	~~UTILITY DETAILS~~
~~37~~	~~SSD-4~~	~~UTILITY DETAILS~~
~~38~~	~~PS-1~~	~~SIMPLEX PUMP STATION DETAILS~~

NORTH CAROLINA PROFESSIONAL ENGINEER SEAL 035107 NICHOLAS J. LAURETTA 9/21/16

For each open utility cut of City streets, a $325 permit shall be required from the City prior to occupancy and/or project acceptance.

1 inch

Approved Construction Plan

	Name	Date
Planning		12/13/16
Traffic		12-13-16
Fire		12:16:16

CITY OF WILMINGTON NORTH CAROLINA
Public Services • Engineering Division
APPROVED STORMWATER MANAGEMENT PLAN
Date: 12/15/16 Permit # 20150212
Signed:

McKIM & CREED
243 North Front Street
Wilmington, North Carolina 28401
Phone: (910)343-1048 , Fax: (910)251-8282
License: F-1222
www.mckimcreed.com

811 Know what's below. Call before you dig.

NASH NORTH AMERICA SEKISUI HOUSE, LLC

RIVERLIGHTS by Newland COMMUNITIES

RECEIVED
SEP 13 2016
PLANNING DIVISION

MARINA VILLAGE- PHASE 1B

02735-0124

MARCH 17, 2016 (REVISED SEPT. 21, 2016)

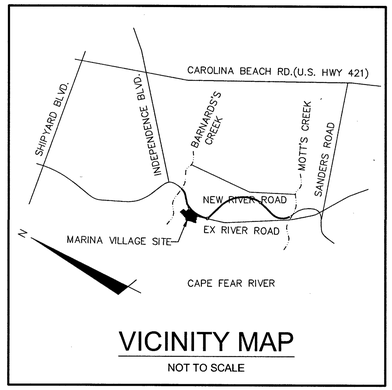

VICINITY MAP

NOT TO SCALE

RIVERLIGHTS

MARINA VILLAGE- PHASE 1B

CITY OF WILMINGTON, NC

MARCH 17, 2016 (REVISED SEPT. 21, 2016)

ISSUED FOR CONSTRUCTION

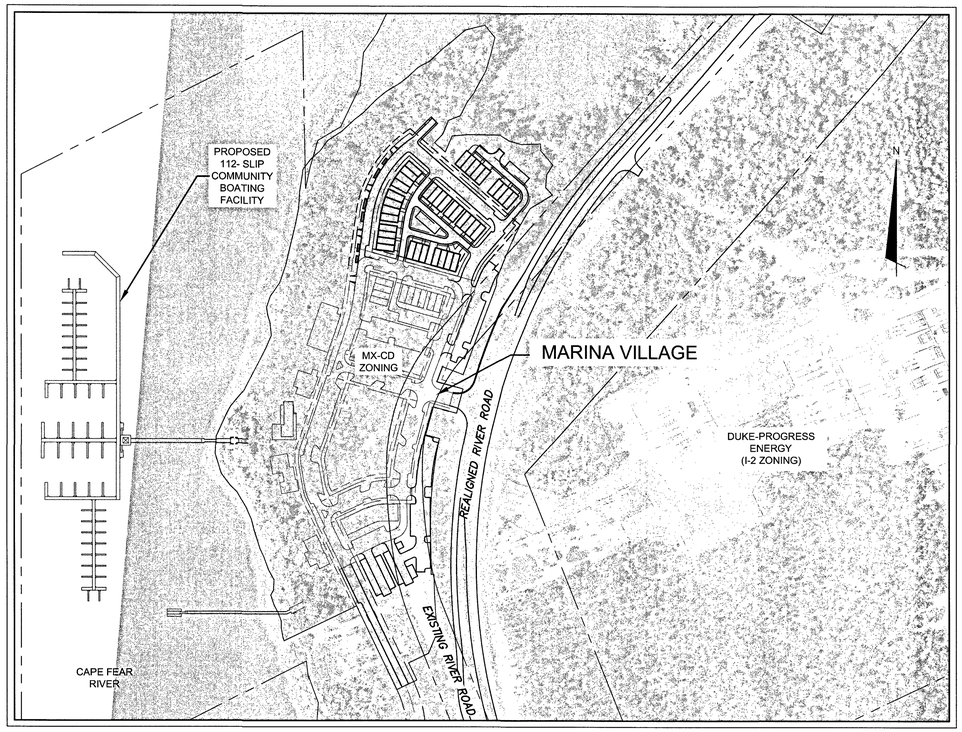

VICINITY MAP

1"=200'

SHEET INDEX		
SHEET NUMBER	SHEET TITLE	SHEET DESCRIPTION
1	G-001	COVER
2	G-002	ABBREVATIONS & LEGEND
3	G-003	GENERAL NOTES
4	CX-101	EXISTING CONDITIONS SITE INVENTORY MAP
5	CX-102	TREE REMOVAL PLAN
~~6~~	~~GE-101~~	~~PHASE 1 SEDIMENT & EROSION CONTROL PLAN~~
~~7~~	~~GE-102~~	~~PHASE 2 SEDIMENT & EROSION CONTROL PLAN~~
8	CG-101	GRADING PLAN NORTH
9	CG-102	GRADING PLAN SOUTH
10	CG-103	STORM DRAINAGE PLAN
11	CS-100	OVERALL SITE PLAN
12	CS-101	SITE PLAN
13	CS-102	SITE PLAN NORTH
14	CS-103	SITE PLAN SOUTH
15	CU-101	UTILITY PLAN
~~15A~~	~~CU-102~~	~~UTILITY PROFILE INDEX SHEET~~
16	CU-701	PLAN AND PROFILE
17	CU-702	PLAN AND PROFILE
18	CU-703	PLAN AND PROFILE
19	L-160	OVERALL PLANTING PLAN SHEET REFERENCE
20	L-161	PLANTING PLAN NORTH
21	L-162	PLANTING PLAN SOUTH
22	L-501	LANDSCAPE DETAILS
23	CN-501	STORMWATER MANAGEMENT DETAILS
24	CT-301	ROADWAY SECTIONS
~~25~~	~~GE-501~~	~~SEDIMENT & EROSION CONTROL DETAILS~~
~~26~~	~~GE-502~~	~~SEDIMENT & EROSION CONTROL DETAILS~~
27	CS-501	SITE DETAILS
28	CS-502	SITE DETAILS
29	CG-501	STORMWATER DRAINAGE DETAILS
30	CG-502	STORMWATER DRAINAGE DETAILS
31	CG-503	STORMWATER DRAINAGE DETAILS
~~32~~	~~WSD-1~~	~~UTILITY DETAILS~~
~~33~~	~~WSD-2~~	~~UTILITY DETAILS~~
~~34~~	~~SSD-1~~	~~UTILITY DETAILS~~
~~35~~	~~SSD-2~~	~~UTILITY DETAILS~~
~~36~~	~~SSD-3~~	~~UTILITY DETAILS~~
~~37~~	~~SSD-4~~	~~UTILITY DETAILS~~
~~38~~	~~PS-1~~	~~SIMPLEX PUMP STATION DETAILS~~

CITY AND AGENCY CONTACTS

A. City of Wilmington
Planning Department
102 North Third Street
PO BOX 1810
Wilmington, NC 28402-1810
(910)341-7800
Contact: Ron Satterfield
Email: Ron.Satterfield@wilmingtonnc.gov

B. City of Wilmington
Engineering
212 Operations Center Drive
PO BOX 1810
Wilmington, NC 28402-1810
(910) 341-7807
Contact: Rob Gordon
Email: Rob.Gordon@wilmingtonnc.gov

C. New Hanover County
Sediment and Erosion Control
230 Government Center Drive, Suite 160
Wilmington, NC 28403
(910) 798-7432
Contact: Beth Wetherill
Email: BWetherill@nhcgov.com

D. Cape Fear Public Utility Authority
235 Government Center Drive
Wilmington, NC 28403
(910) 332-6626
Contact: David Dailey
Email: David.Dailey@cfpua.org

E. NCDENR
Division of Environmental Health
Public Water Supply Section
1634 Mail Service Center
Raleigh, NC 27699-1634
(919) 707-9075
Contact: Christyn Fertenbaugh
Email: christyn.fertenbaugh@ncdenr.gov

PROJECT DATA

NAME OF PROJECT:
RIVERLIGHTS - MARINA VILLAGE PHASE 1B
WILMINGTON, NORTH CAROLINA

OWNER/DEVELOPER:
NNP IV-CAPE FEAR RIVER, LLC
3410 RIVER ROAD, SUITE 103
WILMINGTON, NC 28412
PHONE: (704)813-8697
CONTACT: DOUG BROWN

PREPARED BY:
MCKIM & CREED, INC
243 NORTH FRONT ST
WILMINGTON, NC 28401
PHONE: (910)343-1048
FAX: (910)251-8282
CONTACT: NICK LAURETTA, PE, LEED AP
EMAIL: NLAURETTA@MCKIMCREED.COM

NORTH CAROLINA PROFESSIONAL ENGINEER SEAL 035107 NICHOLAS J. LAURETTA 9/21/16

For each open utility cut of City streets, a $325 permit shall be required from the City prior to occupancy and/or project acceptance.

1 inch

Approved Construction Plan

	Name	Date
Planning		12/17/16
Traffic		12-13-16
Fire		12-16-16

CITY OF WILMINGTON NORTH CAROLINA
Public Services • Engineering Division
APPROVED STORMWATER MANAGEMENT PLAN
Date: 12/15/16 Permit # 20150218
Signed:

McKIM & CREED
243 North Front Street
Wilmington, North Carolina 28401
Phone: (910)343-1048 , Fax: (910)251-8282
License: F-1222
www.mckimcreed.com

811 Know what's below. Call before you dig.

NASH NORTH AMERICA SEKISUI HOUSE, LLC

RIVERLIGHTS by Newland COMMUNITIES

MARINA VILLAGE- PHASE 1B

02735-0124

MARCH 17, 2016 (REVISED SEPT. 21, 2016)

ABBREVIATIONS

ALT	ALTERNATE
AMP	AMPERE
ANCH	ANCHOR
Ac.	ACRE
BIT	BITUMINOUS
BLDG	BUILDING
BM	BEAM, BENCH MARK
BOTT	BOTTOM
CB	CATCH BASIN
C/C	CENTER TO CENTER
CDI	CURB DROP INLET
CFM	CUBIC FEET PER MINUTE
C&G	CURB & GUTTER
CI	CAST IRON
CIP	CAST IN PLACE
CL	CENTERLINE, CLASS
CMP	CORRUGATED METAL PIPE
CO	CLEANOUT
CONC	CONCRETE
CONC PVMT	CONCRETE PAVEMENT
COND	CONDUIT
CONST	CONSTRUCT, CONSTRUCTION
CTR	CENTER
CTV	CABLE TELEVISION
DB	DEED BOOK
DI	DROP INLET, DUCTILE IRON
DIA	DIAMETER
DISCH	DISCHARGE
DWG	DRAWING
E	EAST
EA	EACH
EAP	EXPOSED AGGREGATE PAVING
EL, ELEV	ELEVATION
ELEC	ELECTRIC, ELECTRICAL
EMER	EMERGENCY
EOP, EP	EDGE OF PAVEMENT
EQUIP	EQUIPMENT
ESMT	EASEMENT
EW	EACH WAY, END WALL
EXIST, EX	EXISTING
FL	FLOW LINE
FLG	FLANGE
FLR	FLOOR
FM	FORCE MAIN
FT	FOOT, FEET
G	GAS LINE, GUTTER
GA	GAGE
GAL	GALLON
GALV	GALVANIZED
GEN	GENERATOR
GPM	GALLONS PER MINUTE
h	HEIGHT
HP	HORSEPOWER
HWY	HIGHWAY
ID	INSIDE DIAMETER
INV	INVERT
IP	IRON PIPE, IRON PIN
IPF	IRON PIN FOUND
IR	IRON ROD
JB	JUNCTION BOX
KW	KILOWATTS
M	METER
MANUF, MFR	MANUFACTURER
MATL	MATERIAL
MAX	MAXIMUM
MGD	MILLION GALLONS PER DAY
MH	MANHOLE
MIN	MINIMUM
MON	MONUMENT
N	NORTH
N&C	NAIL AND CAP
NEC	NATIONAL ELECTRIC CODE
NGS	NATIONAL GEODETIC SURVEY
NIC	NOT IN CONTRACT
NO. #	NUMBER
NTS	NOT TO SCALE
OC	ON CENTER
OD	OUTSIDE DIAMETER
PI	POINT OF INTERSECTION
PL	PROPERTY LINE
PNL	PANEL
PSF	POUNDS PER SQUARE FOOT
PSI	POUNDS PER SQUARE INCH
PVC	POLYVINYL CHLORIDE/
PVMT	POINT OF VERTICAL CURVE PAVEMENT
QTY, QUAN	QUANTITY
RCCP	REINFORCED CONCRETE CYLINDER PIPE
RCM	RECLAIMED WATER MAIN
RCP	REINFORCED CONCRETE PIPE
RED	REDUCER
REF	REFERENCE
REINF	REINFORCED, REINFORCING
REQ'D	REQUIRED
REV	REVISION
ROW, R/W	RIGHT OF WAY
RT	RIGHT
RU	REUSE WATER MAIN
RW	RAW WATER
S	SOUTH
SAN	SANITARY
SCHED	SCHEDULE
SD	STORM DRAIN
S.F.	SQUARE FEET
SHT	SHEET
SR	STATE ROUTE
STA	STATION
STD	STANDARD
S/W	SIDEWALK
TELE, TEL	TELEPHONE
TOB	TOP OF BANK
TOS	TOE OF SLOPE
TPS	TURN POINT SET
TS & V	TAPPING SLEEVE & VALVE
TYP	TYPICAL
UL	UNDERWRITERS LAB
UNO	UNLESS NOTED OTHERWISE
V	VOLT
VC	VITRIFIED CLAY
VERT	VERTICAL
VOL	VOLUME
w	WIDTH
W/	WITH
WM	WATER METER, WATER MAIN
WP	WATERPROOF, WEATHERPROOF
WSL	WATER SERVICE LINE
WV	WATER VALVE

LEGEND

DESCRIPTION	EXISTING	NEW
PROPERTY LINE		
ROAD RIGHT-OF-WAY		
UTILITY EASEMENT		
PAVED ROADWAY		
DIRT OR CRUSHED STONE ROADWAY		
STORM DRAINAGE	12"RCP	12"RCP
GAS LINE	12"G	
OVERHEAD ELECTRIC	OHE	
OVERHEAD TELEPHONE	OHT	
OVERHEAD TELEVISION	OHTV	
UNDERGROUND ELECTRIC	UGE	
UNDERGROUND TELEPHONE	UGT	
UNDERGROUND TELEVISION	UGTV	
DIRECTION OF FLOW		
GROUND ELEVATION	7.26	7.64 (TOP OF CURB) / 7.26 (EDGE OF PAVEMENT); 7.64 (SPOT EL.)
CONTOUR (MAJOR)	15	15
CONTOUR (MINOR)		12
MANHOLE		
CATCH BASIN		
INLETS		
DROP INLET (THROAT OPENING)		
UTILITY POLE		
LIGHT POLE		
SUPPORT POLE		
LANDSCAPE LIGHTING		
UTILITY PEDESTAL		
GUY WIRE		
BOLLARD	BOL	
MAILBOX	MB	
SIGN		
BENCHMARK		
TREE LINE		
SHRUB		
EXISTING IRON ROD (DISTURBED)	EIR (D)	
EXISTING IRON ROD	EIR	
LIMITS OF DISTURBANCE	LOD	
SILT FENCE	SF	
TREE PROTECTION FENCE	TP TP	
TEMPORARY DIVERSION DITCH	>TDD	
SANITARY SEWER LINE		SS
SANITARY SEWER MANHOLE		
WATER LINE		8"W
FIRE HYDRANT		
VALVE	WV	
STORMWATER PIPE		
CITY OF WILMINGTON CONSERVATION RESOURCE SETBACK LINE	COD COD	
MEAN HIGH WATER	MHW MHW	
AREA OF ENVIRONMENTAL CONCERN	AEC AEC	
100-YEAR FLOODPLAIN (PRELIMINARY)		
100-YEAR FLOODPLAIN (EFFECTIVE)		
COASTAL MARSH LINE		
35' CONSERVATION RESOURCE VEGETATED BUFFER		
CAMA CLASSIFICATION BOUNDARY		

For each open utility cut of City streets, a $325 permit shall be required from the City prior to occupancy and/or project acceptance.

1 inch

Approved Construction Plan

	Name	Date
Planning		12/13/16
Traffic		12-13-16
Fire		12.16.16

CITY OF WILMINGTON NORTH CAROLINA
Public Services • Engineering Division
APPROVED STORMWATER MANAGEMENT PLAN
Date: 12/15/16 Permit # 20130216Z
Signed:

REV.NO.	DESCRIPTIONS	DATE
	REVISIONS	
4	CITY OF WILMINGTON ENGINEERING COMMENTS	09/21/2016
3	CITY OF WILMINGTON TRC COMMENTS	08/23/2016
2	SITE PLAN AND STORM DRAINAGE REVISIONS	07/19/2016
1	CFPUA COMMENTS	04/11/2016
0	ISSUED FOR CONSTRUCTION	03/17/2016

SEAL

SEAL
NORTH CAROLINA PROFESSIONAL CIVIL 035107 ENGINEER NICHOLAS J. LAURETTA
09/21/16

McKIM & CREED
243 North Front Street
Wilmington, North Carolina 28401
Phone: (910)343-1048, Fax: (910)251-8282
License: F-1222
www.mckimcreed.com

NORTH AMERICA SEKISUI HOUSE, LLC

RIVERLIGHTS™

RIVERLIGHTS MARINA VILLAGE PHASE 1B

ABBREVATIONS & LEGEND

DATE:	17MAR16
MCE PROJ. #	2735-0124
DRAWN	ALM
DESIGNED	NJL
CHECKED	KCBE
PROJ. MGR.	NJL

SCALE
HORIZONTAL: N/A
VERTICAL: N/A

M&C FILE NUMBER G-002
DRAWING NUMBER 2

STATUS: FINAL DESIGN
ISSUED FOR CONSTRUCTION
REVISION 0

S:\2735\0124 Marina Village\BIC-Drawings\Phase 1B\S-003.dwg

CONSTRUCTION NOTES

1. CONSTRUCTION AND MATERIALS SHALL BE IN ACCORDANCE WITH NEW HANOVER COUNTY AND THE CITY OF WILMINGTON STANDARDS AND SPECIFICATIONS.
2. CONTRACTOR IS FULLY RESPONSIBLE FOR ACQUIRING THE LOCATION OF EXISTING UTILITIES FROM THE APPROPRIATE PARTIES PRIOR TO CONSTRUCTION.
3. CONTRACTOR IS RESPONSIBLE FOR PLACING BARRICADES, USING FLAGMEN, ETC. AS NECESSARY TO INSURE SAFETY TO THE PUBLIC.
4. THESE DRAWINGS SHOW INFORMATION OBTAINED FROM THE AVAILABLE RECORDS REGARDING PIPES, CONDUITS, TELEPHONE LINES, AND OTHER STRUCTURES AND CONDITIONS WHICH EXIST ALONG THE LINES OF WORK AND BELOW THE SURFACE OF THE GROUND. THE OWNER AND ENGINEER DISCLAIM ANY RESPONSIBILITIES FOR THE ACCURACY OR COMPLETENESS OF SAID INFORMATION, AND SUCH INFORMATION IS BEING SHOWN ONLY FOR THE CONVENIENCE OF THE CONTRACTOR WHO MUST VERIFY THE INFORMATION TO HIS OWN SATISFACTION DURING THE BIDDING AND CONSTRUCTION PHASES. IF THE CONTRACTOR RELIES ON SAID INFORMATION, HE DOES SO AT HIS OWN RISK. THE GIVING OF THE INFORMATION ON THE CONTRACT DRAWINGS WILL NOT RELIEVE THE CONTRACTOR OF HIS OBLIGATIONS TO SUPPORT AND PROTECT ALL PIPES, CONDUITS, TELEPHONE LINES, AND OTHER STRUCTURES, WHETHER ABOVE OR BELOW GRADE.
5. SHOULD ANY DAMAGE OCCUR TO EXISTING UTILITIES, IT SHALL BE REPAIRED SOLELY AT THE CONTRACTOR'S EXPENSE.
6. THE CONTRACTOR SHALL VERIFY EXISTING INVERTS PRIOR TO CONSTRUCTION OF UNDERGROUND UTILITIES. TEST PITTING OF EXISTING LINES PRIOR TO CONSTRUCTION, IF NECESSARY, SHALL BE COORDINATED WITH THE OWNER.
7. ALL MATERIALS AND METHODS OF CONSTRUCTION SHALL CONFORM TO THE DRAWINGS, PROJECT SPECIFICATIONS, AND LOCAL BUILDING CODES.
8. ALL DISTURBED AREAS SHALL BE SMOOTHLY GRADED TO PROMOTE POSITIVE DRAINAGE AND STABILIZED WITH TOPSOIL, SEED, AND MULCH. IF SETTLEMENT OCCURS, TOPSOIL, SEEDING, AND MULCH SHALL BE REPEATED UNTIL SETTLEMENT SUBSIDES. (SEE EROSION AND SEDIMENT CONTROL DETAILS AND SPECIFICATIONS.)
9. WATER MAINS WILL BE INSTALLED AT A DEPTH THAT WILL PROVIDE 36" COVER OVER THE PIPES BELOW PROPOSED GRADE UNLESS SHOWN OTHERWISE ON THESE PLANS OR DIRECTED OTHERWISE BY THE ENGINEER.
10. WHEREVER SEWER OR WATER MAINS CROSS ONE ANOTHER, A MINIMUM VERTICAL CLEARANCE OF 18" SHALL BE PROVIDED BETWEEN THE BOTTOM OF THE WATER PIPE AND THE TOP OF THE SEWER PIPE.
11. WHEREVER SEWER OR WATER MAINS RUN PARALLEL TO EACH OTHER, A MINIMUM HORIZONTAL SEPARATION OF 10' SHALL BE PROVIDED, OR 18" VERTICAL SEPARATION.
12. IF NEITHER OF THESE CONDITIONS (#10 OR #11 ABOVE) CAN BE MET, THEN THE SEWER SHALL BE CLASS 50 DIP, MINIMUM OF 20 LF CENTERED OVER THE CROSSING.
13. ALL WATER VALVES, BOXES, AND FIRE HYDRANT ASSEMBLES SHALL BE SET AND ADJUSTED TO FINISHED GRADE.
14. THE OWNER IS RESPONSIBLE FOR THE ACQUISITION OF ALL EASEMENTS, BOTH TEMPORARY AND PERMANENT.
15. THE CONTRACTOR SHALL VERIFY HORIZONTAL AND VERTICAL SURVEY CONTROL PRIOR TO STAKING OUT CONSTRUCTION. ANY DISCREPANCIES SHALL BE BROUGHT TO THE ATTENTION OF THE ENGINEER PRIOR TO PROCEEDING WITH WORK.
16. ANY PROPERTY LINE MONUMENTATION DISTURBED DURING CONSTRUCTION SHALL BE REPLACED SOLELY AT THE CONTRACTOR'S EXPENSE.
17. THE CONTRACTOR ASSUMES ALL RESPONSIBILITY FOR ANY DEVIATION FROM THESE PLANS.
18. FIRE HYDRANTS SHALL BE PLACED A MINIMUM DISTANCE OF 6 FEET FROM BACK OF CURB AND SHALL HAVE A CLEAR SPACE OF 3 FEET FROM ANY PERMANENT STRUCTURE PER CFPUA STANDARDS.
19. ALL SELECT AND BORROW MATERIAL SHALL MEET CRITERIA SET FORTH BY SECTIONS 1016 AND 1018 OF THE NORTH CAROLINA DEPARTMENT OF TRANSPORTATION'S STANDARDS AND SPECIFICATIONS FOR ROADS AND STRUCTURES. SEE SECTION -- FOR PLACEMENT AND COMPACTION INFORMATION.
20. THE ENGINEER AND THE CONTRACTOR SHALL INSPECT ALL EXISTING PIPES USED IN THE FINAL DRAINAGE SYSTEM AND AGREE ON THE CONDITION OF THE PIPES PRIOR TO CONSTRUCTION. IF DAMAGE OCCURS TO THESE PIPES DURING CONSTRUCTION, THE CONTRACTOR SHALL BE RESPONSIBLE FOR THE REPAIR OR REPLACEMENT OF THE PIPE(S).
21. EXISTING PAVING, CONCRETE, AND OTHER UNSUITABLE MATERIALS INCLUDING UNDERCUT EXCAVATION SHALL NOT BE USED AS FILL MATERIAL AND SHALL BE DISPOSED OF OUTSIDE THE PROJECT LIMITS AT THE CONTRACTOR'S EXPENSE. THE CONTRACTOR IS RESPONSIBLE FOR ALL PERMITTING AND FEES FOR DISPOSAL.
22. ALL TREES, STUMPS, ROOT MAT, ETC. SHALL BE ENTIRELY REMOVED REGARDLESS OF DEPTH. BURIAL OF ORGANIC MATERIAL WITHIN THE PROJECT LIMITS IS NOT PERMITTED. OPEN BURNING OF DOWNED TREES AND STUMPS IS NOT PERMITTED. CHIPPED MATERIALS MUST BE REMOVED PRIOR TO THE PLACEMENT OF EMBANKMENT OR TOPSOIL.
23. THE CONTRACTOR IS SOLELY RESPONSIBLE TO OBTAIN OFF-SITE SPOIL AREAS FOR DISPOSAL OF EXCESS AND/OR UNSUITABLE MATERIALS AS NECESSARY. OFF-SITE SPOIL AREAS MUST BE SUBMITTED TO THE ENGINEER AND APPLICABLE REGULATORY AGENCIES PRIOR TO UTILIZATION BY THE CONTRACTOR. NO AREAS DESIGNATED AS WETLANDS WILL BE PERMITTED FOR USE AS A DISPOSAL SITE. THE CONTRACTOR SHALL SUBMIT DOCUMENTATION TO THE ENGINEER THAT NO WETLANDS WILL BE IMPACTED. THE ENGINEER WILL NOT CONSIDER ANY DELAYS OR MONETARY CLAIMS OF ANY NATURE RESULTING FROM THE CONTRACTOR'S FAILURE OR DIFFICULTY IN FINDING NECESSARY DISPOSAL SITES TO MEET THE TIME FRAMES AND CAPACITIES REQUIRED. THE CONTRACTOR SHALL BE RESPONSIBLE FOR ALL PLANS, PERMITS, EROSION AND SEDIMENT CONTROL MEASURES, ETC. REQUIRED BY THE APPROPRIATE REGULATORY AGENCIES FOR UTILIZING OFF-SITE SPOIL AREAS. THE CONTRACTOR SHALL CERTIFY TO THE ENGINEER THAT ALL REQUIRED PERMITS HAVE BEEN OBTAINED PRIOR TO UTILIZING THE OFF-SITE SPOIL AREAS. ALL COSTS FOR PROCURING AND UTILIZING THE OFF-SITE SPOIL AREAS ARE TO BE INCIDENTAL TO THE BASE BID.

For each open utility cut of City streets, a $325 permit shall be required from the City prior to occupancy and/or project acceptance.

1 inch

Approved Construction Plan

	Name	Date
Planning		12/13/16
Traffic		12-13-16
Fire		12-16-16

CITY OF WILMINGTON NORTH CAROLINA
Public Services Engineering Division
APPROVED STORMWATER MANAGEMENT PLAN
Date: 12/15/16 Permit # 20150282
Signed:

DEMOLITION NOTES

1. THE CONTRACTOR SHALL VISIT THE SITE TO BECOME FAMILIARIZED WITH FIELD DEMOLITION CONDITIONS.
2. THE CONTRACTOR IS RESPONSIBLE FOR THE PROPER DISPOSAL OF ALL DEMOLISHED DEBRIS ASSOCIATED WITH THE PROJECT IN ACCORDANCE WITH THE PROJECT SPECIFICATIONS.
3. THE CONTRACTOR IS RESPONSIBLE FOR CONTROLLING DUST GENERATED BY THE WORK, INCLUDING BUT NOT LIMITED TO DEMOLITION AND CONSTRUCTION ACTIVITIES, SITE VEHICULAR TRAFFIC AND RELATED OPERATIONS.
4. THE CONTRACTOR IS RESPONSIBLE FOR HAVING ALL EXISTING UTILITIES LOCATED PRIOR TO BEGINNING ANY DEMOLITION. CONTRACTOR SHALL CONTACT NC ONE CALL AT LEAST 72 HOURS PRIOR TO BEGINNING CONSTRUCTION OR EXCAVATION TO HAVE EXISTING UTILITIES LOCATED.
5. EXISTING UTILITIES AND STRUCTURES SHOWN, BOTH UNDERGROUND AND ABOVE GROUND, ARE BASED ON FIELD SURVEY AND THE BEST AVAILABLE RECORD DRAWINGS. THE CONTRACTOR SHALL VERIFY FIELD CONDITIONS PRIOR TO BEGINNING RELATED CONSTRUCTION. ANY DISCREPANCIES SHALL BE REPORTED TO THE OWNER'S REPRESENTATIVE AND ENGINEER IMMEDIATELY.
6. THE CONTRACTOR IS RESPONSIBLE FOR THE COORDINATION OF DISCONNECTING AND ABANDONING ALL EXISTING UTILITIES WITH THE OWNER UNLESS OTHERWISE NOTED. ALL EXISTING UTILITIES AND ASSOCIATED PIPING, ETC. NOT IN USE ON THE SITE SHALL BE PROPERLY ABANDONED AND REMOVED AS REQUIRED. COORDINATE WITH THE OWNER.
7. THE CONTRACTOR IS RESPONSIBLE FOR THE PROTECTION OF ANY EXISTING UTILITIES THAT REMAIN IN SERVICE DURING DEMOLITION.
8. THE CONTRACTOR IS RESPONSIBLE FOR STABILIZATION OF ALL DISTURBED AREAS AND SLOPES ON AND OFF SITE IN ACCORDANCE WITH THE EROSION CONTROL MEASURES SPECIFIED ON THE PLANS AND IN THE SPECIFICATIONS. THE CONTRACTOR SHALL COORDINATE WITH THE OWNER TO DETERMINE WHO IS RESPONSIBLE FOR PROVIDING THE PERMANENT STABILIZATION MEASURES AND THE TYPE OF PERMANENT MEASURES PRIOR TO BEGINNING DEMOLITION AND CONSTRUCTION. THE PERMANENT STABILIZATION MEASURES SHALL BE IN PLACE AND ACCEPTABLE TO THE OWNER'S REPRESENTATIVE AND ENGINEER PRIOR TO PROJECT CLOSEOUT. COORDINATE INSPECTION WITH THE OWNER AND ENGINEER PRIOR TO PROJECT CLOSEOUT.
9. THE CONTRACTOR IS RESPONSIBLE FOR COORDINATING AND CONTACTING THE ENGINEER FOR THE REQUIRED INSPECTIONS ON THE PROJECT.
10. WETLANDS DO EXIST ON SITE AND ARE NOTED ON THE PLANS. UNLESS OTHERWISE INDICATED, THE WETLANDS SHALL NOT BE DISTURBED DURING CONSTRUCTION OF THIS PROJECT.

EXCAVATION, GRADING, AND BACKFILLING NOTES

1. ANY UNDERCUTTING IN GOOD SOIL SHALL BE REPLACED AND THE REPLACEMENT MATERIAL SHALL BE COMPACTED TO NINETY-FIVE (95) PERCENT OF MAXIMUM DENSITY OBTAINED AT OPTIMUM MOISTURE CONTENT, AS DETERMINED BY THE ASTM D 698 STANDARD PROCTOR TEST METHOD. IN THE EVENT THAT MATERIAL ENCOUNTERED AT PIPE GRADE, SUBGRADE OF PARKING OR ROADWAYS AND SUBGRADE OF BUILDING FOUNDATIONS IS FOUND TO BE SOFT, SPONGY, OR IN ANY OTHER WAY UNSUITABLE, THE CONTRACTOR SHALL NOTIFY THE GEOTECHNICAL ENGINEER IMMEDIATELY. SUCH UNSUITABLE MATERIAL SHALL BE REMOVED TO A DEPTH AS SPECIFIED BY THE GEOTECHNICAL ENGINEER AND REPLACED WITH A MINIMUM OF SIX (6) INCHES OF STONE, OR AS DIRECTED BY THE GEOTECHNICAL ENGINEER.
2. BEFORE BACKFILLING IS COMMENCED OVER PIPES AND OTHER INSTALLATIONS, EARTH FILL SHALL BE SOLIDLY TAMPED AROUND AND ABOVE THE PIPE TO A DEPTH OF ONE (1) FOOT ABOVE THE TOP OF THE PIPE. CARE SHALL BE TAKEN TO PREVENT ANY DISTURBANCE TO THE PIPE OR DAMAGE TO NEWLY MADE JOINTS. THE FILLING OF THE TRENCH SHALL BE CARRIED OUT SIMULTANEOUSLY ON BOTH SIDES OF THE PIPES IN SUCH A MANNER THAT INJURIOUS SIDE PRESSURES DO NOT OCCUR.
3. THE MATERIAL FOR BACKFILLING SHALL BE FREE FROM ALL PERISHABLE AND OBJECTIONABLE MATERIALS. BEFORE PLACING ANY BACKFILL, ALL RUBBISH, FORM, BLOCKS, WIRES OR OTHER UNSUITABLE MATERIAL SHALL BE REMOVED FROM EXCAVATION. THE BACK-FILLING OVER PIPES SHALL BE PLACED IN LAYERS NOT OVER SIX (6) INCHES THICK AND COMPACTED TO A MINIMUM DENSITY OF NINETY-FIVE (95) PERCENT OF THE MAXIMUM DRY DENSITY AS DETERMINED BY THE MODIFIED PROCTOR COMPACTION TEST TO A DEPTH OF 12 INCHES BELOW FINISHED GRADE. THE LAST 12 INCHES OF BACKFILL SHALL BE PLACED IN LAYERS NOT OVER SIX (6) INCHES THICK AND COMPACTED TO A MINIMUM DENSITY OF NINETY-EIGHT (98) PERCENT OF THE MAXIMUM DRY DENSITY AS DETERMINED BY THE MODIFIED PROCTOR COMPACTION TEST.

STORM DRAINAGE AND GRADING NOTES

1. IN ACCORDANCE WITH NC GENERAL STATUTES, NPDES REGULATIONS, AND NCDENR REQUIREMENTS, STORMWATER DISCHARGE OUTFALLS SHALL BE INSPECTED BY THE CONTRACTOR. INSPECTIONS SHALL BE PERFORMED BY THE CONTRACTOR ONCE A WEEK AND WITHIN 24 HOURS OF EACH STORM EVENT OF 1/2 INCH OR GREATER. NCDENR STANDARD INSPECTION REPORTS SHALL BE COMPLETED ONCE A WEEK AND WITHIN 24 HOURS OF EVERY 1/2 INCH OR GREATER RAINFALL WITH COPIES PROVIDED TO THE OWNER, ARCHITECT, AND ENGINEER, BY THE CONTRACTOR.
2. INLET PROTECTION SHALL BE INSTALLED AROUND OUTFALL DEVICES SHALL BE CONSTRUCTED TO FINAL PROPOSED CONDITION UPON STABILIZATION OF CONTRIBUTING GROUND SURFACES AND REMOVAL OF SEDIMENT FROM STORM PIPES.
3. ALL DIMENSIONS AND GRADES SHOWN ON THE PLANS SHALL BE FIELD VERIFIED BY THE CONTRACTOR PRIOR TO CONSTRUCTION. CONTRACTOR SHALL NOTIFY CONSTRUCTION MANAGER IF ANY DISCREPANCIES EXIST PRIOR TO PROCEEDING WITH CONSTRUCTION FOR NECESSARY PLAN OR GRADE CHANGES. NO EXTRA COMPENSATION SHALL BE PAID TO CONTRACTOR FOR ANY WORK DONE DUE TO DIMENSIONS OR GRADES SHOWN INCORRECTLY ON THESE PLANS IF SUCH NOTIFICATION HAS NOT BEEN GIVEN.
4. UNLESS OTHERWISE NOTED, GRADES AND SPOT ELEVATIONS NOTED ON PLANS INDICATE FINISHED GRADE OF PAVEMENT SURFACE. ALL DIMENSIONS ARE MEASURED TO THE BACK OF CURB UNLESS OTHERWISE INDICATED.

UTILITY NOTES

1. SCHEDULE A PRECONSTRUCTION MEETING WITH CAPE FEAR PUBLIC UTILITY AUTHORITY 48 HOURS PRIOR TO CONSTRUCTION OF WATER AND SEWER LINES.
2. WATER AND SANITARY SEWER UTILITY MAINS ARE CONTAINED WITH PUBLIC DRAINAGE EASEMENTS. MAINS ARE PRIVATE BEYOND THE PUBLIC UTILITY EASEMENT.
3. THIS PROJECT SHALL COMPLY WITH THE CFPUA CROSS CONNECTION CONTROL REQUIREMENTS. WATER METER(S) CANNOT BE RELEASED UNTIL ALL REQUIREMENTS ARE MET AND NCDENR HAS ISSUED THE "FINAL APPROVAL".
4. ALL COMMERCIAL WATER SERVICES AND ANY IRRIGATION SYSTEMS SUPPLIED BY CFPUA WATER SHALL HAVE A BACKFLOW PREVENTION DEVICE ACCEPTABLE TO CFPUA AND APPROVED BY USCFCCCHR OR ASSE.
5. BACKFLOW PREVENTION WILL BE PROVIDED FOR BOTH FIRE LINES (RPDA) AND COMMERCIAL DOMESTIC SERVICE (RPZ). FIRE LINE BACKFLOW PREVENTER AND DOMESTIC SERVICE BACKFLOW PREVENTER WILL BE LOCATED AS SHOWN ON THE UTILITY PLANS. INSTALLER OF BACKFLOW PREVENTERS MUST CONTACT CFPUA PRIOR TO INSTALLING UNITS TO GIVE CFPUA THE OPTION TO VERIFY INSTALLATION PROCEDURES.
   - 5.1. REDUCED PRESSURE PRINCIPLE ASSEMBLY FOR DOMESTIC WATER SERVICE
   - 5.2. REDUCE PRESSURE DETECTOR ASSEMBLY WILL BE UTILIZED FOR THE BACKFLOW PREVENTER ON THE FIRE SERVICE.
6. IF THE CONTRACTOR DESIRES CFPUA WATER FOR CONSTRUCTION HE SHALL APPLY IN ADVANCE FOR THIS SERVICE AND MUST PROVIDE A REDUCED PRESSURE ZONE (RPZ) BACKFLOW PREVENTION DEVICE ON THE DEVELOPER'S SIDE OF THE WATER METER BOX.
7. WATER: 2" PVC MAINS SHALL BE CONSTRUCTED USING ASTM D2241, IPS, GASKETED PIPE, SDR 21. 4"-12" PVC MAINS AND SERVICES SHALL BE CONSTRUCTED USING AWWA C-900 PVC, CL150 (DR-18).
8. SANITARY SEWER: FOR PIPE SIZES 4" AND 6" PIPE SHALL BE SCH 40 CONFORMING TO THE REQUIREMENTS OF ASTM D1785 WITH SOLVENT WELD JOINTS CONFORMING TO ASTM D2672. FOR PIPE SIZES 8" THROUGH 12", PIPE SHALL BE CLASS 150, DR18 CONFORMING TO THE REQUIREMENTS OF AWWA C900 WITH ELASTOMERIC PUSH-ON JOINTS CONFORMING TO ASTM D3212 OR ASTM D3139.
9. WATER AND SEWER SERVICES CANNOT BE ACTIVATED ON NEW MAINS UNTIL ENGINEER'S CERTIFICATION AND AS-BUILTS ARE RECEIVED AND "FINAL APPROVAL" ISSUED BY PUBLIC WATER SUPPLY SECTION OF NCDENR AND "FINAL ENGINEERING CERTIFICATION" ISSUED BY DIVISION OF WATER QUALITY OF NCDENR.
10. PVC WATER MAINS AND POLYETHYLENE SERVICES ARE TO BE MARKED WITH NO. 10 SINGLE STRAND INSULATED COPPER WIRE INSTALLED THE ENTIRE LENGTH AND STRAPPED TO THE PIPES WITH DUCT TAPE. THE INSULATED WIRE IS TO BE STRIPPED TO BARE WIRE AND SECURED TO ALL VALVES. THIS WIRE IS TO BE ACCESSIBLE AT ALL FIRE HYDRANTS AND WATER METER BOXES TO AID IN FUTURE LOCATION OF FACILITIES.
11. SITE UTILITY CONTRACTOR TO PROVIDE WATER AND SANITARY SEWER SERVICE TO WITHIN 5 FEET OF THE BUILDING. CONTRACTOR SHALL COORDINATE SITE PLAN CONNECTIONS WITH THE ARCHITECTURAL BUILDING PLANS.
12. MAXIMUM BENDING RADIUS FOR 8" C-900 PVC WATER MAIN BENDS IS 380' (ONE-HALF MANUFACTURER'S RECOMMENDED ALLOWABLE LONGITUDINAL BENDING).
13. FIRE SPRINKLERS WILL BE PROVIDED FOR BUILDING.
14. UNDERGROUND UTILITIES: ALL NEW UTILITIES SHALL BE INSTALLED UNDERGROUND, EXCEPT WHERE SUCH PLACEMENT IS PROHIBITED OR DEEMED IMPRACTICAL BY THE UTILITY PROVIDER. UNDERGROUND TERMINAL FACILITIES FOR STREET LIGHTING ALONG THE PUBLIC STREETS ABUTTING THE SUBJECT SITE SHALL BE INSTALLED BY THE DEVELOPER.
15. MINIMUM OF 36" COVERAGE ABOVE ALL WATERMAINS.
16. MINIMUM OF 36" VERTICAL SEPARATION BETWEEN WATERLINES AND STORMDRAIN CURB INLETS.

RELATION OF WATER MAINS TO SANITARY SEWERS:

1. LATERAL SEPARATION OF SANITARY SEWERS AND WATER MAINS: WATER MAINS SHALL BE LAID AT LEAST 10 FEET LATERALLY FROM EXISTING OR PROPOSED SEWERS UNLESS LOCAL CONDITIONS OR BARRIERS PREVENT A 10 FOOT LATERAL SEPARATION, IN WHICH CASE:
   - 1.1. THE WATER MAIN IS LAID IN A SEPARATE TRENCH, WITH THE ELEVATION OF THE BOTTOM OF THE WATER MAIN AT LEAST 18 INCHES ABOVE THE TOP OF THE SEWER, OR
   - 1.2. THE WATER MAIN IS LAID IN THE SAME TRENCH AS THE SEWER WITH THE WATER MAIN LOCATED AT ONE SIDE ON A BENCH OF UNDISTURBED EARTH, AND ABOVE THE TOP OF THE SEWER.
2. CROSSING A WATER MAIN OVER A SEWER MAIN: WHENEVER IT IS NECESSARY FOR A WATER MAIN TO CROSS OVER A SEWER THE WATER MAIN SHALL BE LAID AT SUCH AN ELEVATION THAT THE BOTTOM OF THE WATER MAIN IS AT LEAST 24 INCHES ABOVE THE TOP OF THE SEWER MAIN. UNLESS LOCAL CONDITIONS OR BARRIERS PREVENT AN 18 INCH VERTICAL SEPARATION - IN WHICH CASE BOTH THE WATER MAIN AND THE SEWER MAIN SHALL BE CONSTRUCTED OF FERROUS MATERIALS AND WITH JOINTS THAT ARE EQUIVALENT TO WATER MAIN STANDARDS FOR A DISTANCE OF 10 FEET ON EACH SIDE OF THE POINT OF CROSSING.
3. CROSSING A WATER MAIN UNDER A SEWER MAIN: WHENEVER IT IS NECESSARY FOR A WATER MAIN TO CROSS UNDER A SEWER MAIN BOTH THE WATER MAIN AND THE SEWER MAIN SHALL BE CONSTRUCTED OF FERROUS MATERIALS AND WITH JOINTS EQUIVALENT TO WATER MAIN STANDARDS FOR A DISTANCE OF 10 FEET ON EACH SIDE OF THE POINT OF CROSSING.
4. CROSSING A SEWER MAIN/WATER MAIN OVER OR UNDER A STORM DRAIN: WHENEVER IT IS NECESSARY FOR A SEWER MAIN/WATER MAIN TO CROSS A STORM DRAIN PIPE, THE SEWER MAIN/WATER MAIN SHALL BE LAID AT SUCH AN ELEVATION THAT THE OUTSIDE OF THE SEWER MAIN/WATER MAIN NEAREST TO THE OUTSIDE OF THE STORM DRAIN PIPE SHALL MAINTAIN A 24 INCH CLEAR SEPARATION DISTANCE HORIZONTAL, OR THE SEWER MAIN/WATER MAIN SHALL EITHER BE CONSTRUCTED OF DUCTILE IRON PIPE OR DUCTILE IRON PIPE FOR AT LEAST 5 FEET ON EITHER SIDE OF THE CROSSING.
5.

MATERIALS AND EASEMENT NOTES:

- ALL CATCH BASINS ARE NCDOT STD 840.01
- ALL DROP INLETS IN TRAFFIC AREAS ARE NCDOT STD 840.35, ALL DROP INLETS IN LANDSCAPE AREAS ARE CITY OF WILMINGTON STD 2-02 & 14-04.
- ALL STORM DRAINAGE PIPING TO BE CLASS III RCP, UNLESS OTHERWISE NOTED
- ALL STORM DRAINAGE PIPING CONVEYING DISCHARGE FROM THE PUBLIC RIGHT-OF-WAY SHALL BE CONTAINED WITHIN A PUBLIC DRAINAGE EASEMENT WHOSE WIDTH IS DETERMINED BY THE DEPTH OF BURY
- A PUBLIC UTILITY EASEMENT SHALL BE RESERVED WITHIN THE STREET RIGHT-OF-WAY. A 10' NON-MUNICIPAL EASEMENT SHALL BE RESERVED ALONG BOTH SIDES OF ALL STREETS
- WATER AND SANITARY SEWER UTILITIES ARE PUBLIC - CAPE FEAR PUBLIC UTILITY AUTHORITY

EROSION CONTROL NOTES

1. ANY GRADING BEYOND THE DENUDED LIMITS SHOWN ON THE PLAN IS A VIOLATION OF THE COUNTY EROSION CONTROL ORDINANCE AND IS SUBJECT TO A FINE.
2. GRADING MORE THAN ONE ACRE WITHOUT AN APPROVED EROSION CONTROL PLAN IS A VIOLATION OF STATE LAW AND IS SUBJECT TO A FINE.
3. GROUND COVER MUST BE PROVIDED ON EXPOSED SLOPES WITHIN 21 CALENDAR DAYS FOLLOWING COMPLETION OF ANY PHASE OF GRADING; AND, A PERMANENT GROUND COVER FOR ALL DISTURBED AREAS WITHIN 15 WORKING DAYS OR 90 CALENDAR DAYS (WHICHEVER IS SHORTER) FOLLOWING COMPLETION OF CONSTRUCTION OR DEVELOPMENT.
4. ADDITIONAL MEASURES TO CONTROL EROSION AND SEDIMENT MAY BE REQUIRED BY A REPRESENTATIVE OF NEW HANOVER COUNTY.
5. SLOPES SHALL BE GRADED NO STEEPER THAN 3:1.
6. ADDITIONAL DEVICES MAY BE REQUIRED AS AGREED UPON BY THE FIELD INSPECTOR, ENGINEER, AND OWNER.
7. IF ACTIVE CONSTRUCTION CEASES IN ANY AREA FOR MORE THAN 15 WORKING DAYS OR 90 CALENDAR DAYS (WHICHEVER IS SHORTER), ALL DISTURBED AREAS MUST BE SEEDED, MULCHED, AND TACKED.
8. WITHIN 24 HOURS FOLLOWING ANY RAIN EVENT, THE CONTRACTOR SHALL INSPECT AND REPAIR, AS NECESSARY, ALL DAMAGED EROSION CONTROL MEASURES.
9. ALL ACTIVITY AND INSTALLATION OF EROSION CONTROL MATTING WILL BE COMPLETE PRIOR TO ANY RAIN EVENT.

EROSION CONTROL MAINTENANCE PLAN:

1. ALL SEDIMENT AND EROSION CONTROL DEVICES SHALL BE INSPECTED AND REPAIRED, AS NECESSARY, EVERY SEVEN (7) DAYS AND WITHIN 24 HOURS OF EVERY ONE-HALF (0.5) INCH OR GREATER RAINFALL OCCURRENCE.
2. ALL EROSION CONTROL DEVICES SHALL BE PROPERLY MAINTAINED DURING ALL PHASES OF CONSTRUCTION UNTIL THE COMPLETION OF ALL CONSTRUCTION ACTIVITIES AND ALL DISTURBED AREAS HAVE BEEN STABILIZED. ADDITIONAL CONTROL DEVICES MAY BE REQUIRED DURING CONSTRUCTION IN ORDER TO CONTROL EROSION AND/OR OFFSITE SEDIMENTATION. ALL TEMPORARY CONTROL DEVICES SHALL BE REMOVED ONCE CONSTRUCTION IS COMPLETE AND THE SITE IS STABILIZED.
3. SEDIMENT SHALL BE REMOVED FROM BEHIND THE SILT FENCE WHEN IT BECOMES ABOUT 0.5 FEET DEEP. THE SEDIMENT FENCE WILL BE REPAIRED OR REPLACED AS NECESSARY TO MAINTAIN A BARRIER.
4. ALL AREAS WILL BE FERTILIZED, RESEEDED AS NECESSARY, AND MULCHED ACCORDING TO SPECIFICATIONS IN THE VEGETATIVE PLAN TO MAINTAIN A VIGOROUS, DENSE VEGETATIVE COVER.
5. STONE CONSTRUCTION ENTRANCE TO BE CLEANED WHEN SEDIMENT ACCUMULATIONS ARE VISIBLE OR SEDIMENT IS TRACKED ON TO THE PAVEMENT. STONE WILL BE PERIODICALLY TOP DRESSED WITH 2 INCHES OF #4 STONE TO MAINTAIN 6 INCH DEPTH. THE CONTRACTOR SHALL DAILY REMOVE MUD/SOIL FROM PAVEMENT, AS REQUIRED.
6. INSPECT TEMPORARY DIVERSIONS AND CHECK DAMS ONCE A WEEK AND AFTER EVERY RAINFALL. IMMEDIATELY REMOVE SEDIMENT FROM THE FLOW AREA AND REPAIR THE DIVERSION RIDGE AND CHECK DAM. CAREFULLY CHECK OUTLETS AND MAKE TIMELY REPAIRS AS NEEDED. WHEN THE AREA PROTECTED IS PERMANENTLY STABILIZED, REMOVE THE RIDGE AND THE CHANNEL TO BLEND WITH THE NATURAL GROUND LEVEL AND APPROPRIATELY STABILIZE IT.
7. INSPECT TEMPORARY SEDIMENT BASINS AT LEAST WEEKLY AND AFTER EACH SIGNIFICANT (1/2" OR GREATER) RAINFALL EVENT AND REPAIR IMMEDIATELY. REMOVE SEDIMENT AND RESTORE THE BASIN TO ITS ORIGINAL DIMENSIONS WHEN IT ACCUMULATES TO ONE-HALF THE DESIGN DEPTH. PLACE REMOVED SEDIMENT IN AN AREA WITH SEDIMENT CONTROLS.
8. CHECK THE SEDIMENT BASIN EMBANKMENT, SPILLWAYS, AND OUTLET FOR EROSION DAMAGE, AND INSPECT THE EMBANKMENT FOR PIPING AND SETTLEMENT. MAKE ALL NECESSARY REPAIRS IMMEDIATELY. REMOVE ALL TRASH AND OTHER DEBRIS FROM THE RISER AND POOL AREA.
9. INSPECT INLETS AT LEAST WEEKLY AND AFTER EACH SIGNIFICANT (0.5" OR GREATER) RAINFALL EVENT. CLEAR THE MESH WIRE OF ANY DEBRIS OR OTHER OBJECTS TO PROVIDE ADEQUATE FLOW FOR SUBSEQUENT RAINS. TAKE CARE NOT TO DAMAGE OR UNDERCUT THE WIRE MESH DURING SEDIMENT REMOVAL. REPLACE STONE AS NEEDED. INLET PROTECTION SHOULD BE CLEANED OUT WHEN IT IS HALF FULL.
10. INSPECT TEMPORARY SEDIMENT TRAPS AT LEAST WEEKLY AND AFTER EACH SIGNIFICANT (1/2" OR GREATER) RAINFALL EVENT AND REPAIR IMMEDIATELY. REMOVE SEDIMENT AND RESTORE THE TRAP TO ITS ORIGINAL DIMENSIONS WHEN IT ACCUMULATES TO ONE-HALF THE DESIGN DEPTH. PLACE REMOVED SEDIMENT IN AN AREA WITH SEDIMENT CONTROLS.
11. REPAIR THE BAFFLES IF THEY ARE DAMAGED. RE-ANCHOR THE BAFFLES IF WATER IS FLOWING UNDERNEATH OR AROUND THEM.
12. INSPECT THE SKIMMER FOR CLOGGING. PULL THE SKIMMER TO THE SIDE OF THE BASIN AND REMOVE ANY DEBRIS. ALSO CHECK THE ORIFICE INSIDE THE SKIMMER AND THE ARM OR BARREL PIPE FOR CLOGGING; IF CLOGGED, REMOVE THE DEBRIS.

NOTE (G.S. 113A-57 (2))

THE ANGLE FOR GRADED SLOPES AND FILLS SHALL BE NO GREATER THAN THE ANGLE THAT CAN BE RETAINED BY VEGETATIVE COVER OR OTHER ADEQUATE EROSION CONTROL DEVICES OR STRUCTURES. IN ANY EVENT, SLOPES LEFT EXPOSED WILL, WITHIN 21 CALENDAR DAYS OF COMPLETION OF ANY GRADING, BE PLANTED OR OTHERWISE PROVIDED WITH TEMPORARY OR PERMANENT GROUND COVER, DEVICES, OR STRUCTURES SUFFICIENT TO RESTRAIN EROSION.

CITY OF WILMINGTON STANDARD NOTES

1. CONTACT THE NORTH CAROLINA ONE CALL CENTER PRIOR TO DOING ANY DIGGING AT 1-800-632-4949.
2. PRIOR TO ANY CLEARING, GRADING OR CONSTRUCTION ACTIVITY, TREE PROTECTION FENCING SHALL BE INSTALLED AROUND PROTECTED TREES OR GROVES OF TREES AND NO CONSTRUCTION WORKERS, TOOLS, MATERIALS, OR VEHICLES ARE PERMITTED WITHIN THE TREE PROTECTION FENCING.
3. ALL PAVEMENT MARKINGS IN PUBLIC RIGHTS-OF-WAY AND FOR DRIVEWAYS ARE TO BE THERMOPLASTIC AND MEET CITY AND/OR NCDOT STANDARDS.
4. ONCE STREETS ARE OPEN TO TRAFFIC, THE DEVELOPER SHALL CONTACT TRAFFIC ENGINEERING TO REQUEST INSTALLATION OF TRAFFIC AND STREET NAME SIGNS. PROPOSED STREET NAMES MUST BE APPROVED PRIOR TO INSTALLATION OF STREET NAME SIGNS.
5. TRAFFIC CONTROL DEVICES (INCLUDING SIGNS AND PAVEMENT MARKINGS) IN AREAS OPEN TO PUBLIC TRAFFIC ARE TO MEET MUTCD (MANUAL ON UNIFORM TRAFFIC CONTROL DEVICES) STANDARDS.
6. ANY BROKEN OR MISSING SIDEWALK PANELS AND CURBING SHALL BE REPLACED BY THE CONTRACTOR.
7. CONTACT CITY OF WILMINGTON AT 341-7888 TO DISCUSS STREET LIGHTING OPTIONS.
8. IF THE CONTRACTOR DESIRES WATER FOR CONSTRUCTION HE SHALL APPLY WITH THE CAPE FEAR PUBLIC UTILITY AUTHORITY IN ADVANCE FOR THIS SERVICE AND MUST PROVIDE A REDUCED PRESSURE ZONE (RPZ) BACKFLOW PREVENTION DEVICE ON THE DEVELOPER'S SIDE OF THE WATER METER BOX.
9. THE NUMBER AND SPACING OF DRIVEWAYS FOR ALL INTERCONNECTED SITES WILL BE DETERMINED BY THE COMBINED FRONTAGE OF THE INTERCONNECTED PROPERTIES.
10. CON

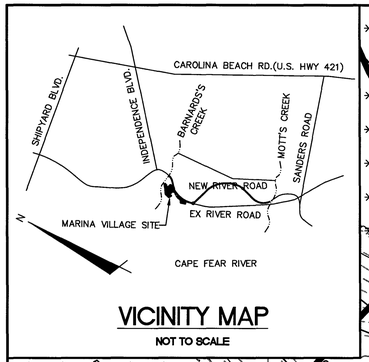

VICINITY MAP

NOT TO SCALE

404 WETLAND (BRACKISH)

COASTAL MARSH LINE

EXISTING NON-JURISDICTIONAL DITCH

REALIGNED RIVER ROAD (150' PUBLIC R/W)

SOIL BOUNDARY (TYP.)

TREE LINE (TYP.)

Kr

Pm

Ly

NNP IV CAPE FEAR RIVER LLC
4410 RIVER ROAD
PARCEL ID: R07000-006-009-000
ZONING: MX MIXED USE
LAND USE: 108-FORESTRY & RELATED

DUKE PROGRESS ACCESS EASEMENT

DUKE PROGRESS TRANSMISSION EASEMENT

PIEDMONT NATURAL GAS EASEMENT

4" PVC SLEEVE

6" PVC SLEEVE

8" PVC SLEEVE

35' VEGETATED BUFFER

CAMA AREA OF ENVIRONMENTAL CONCERN (AEC)

CITY OF WILMINGTON CONSERVATION RESOURCE LINE PER LDC ARTICLE 6, DIVISION III, SECTION 18-341

100-YR FLOODPLAIN (EFFECTIVE)(AE9)

MEAN HIGH WATER (APPROX. EL. 2)

100-YR FLOODPLAIN (PRELIMINARY)(AE9)

CAMA CLASSIFICATION BOUNDARY

COASTAL MARSH LINE

CAPE FEAR RIVER

60' 0 60' 120'
SCALE: 1"=60' (Horiz.)

SITE DATA TABLE	MARINA VILLAGE – PHASE 2	
GENERAL INFORMATION		
APPLICANT NAME	NNP IV– CAPE FEAR RIVER, LLC	
SITE ADDRESS	4410 RIVER ROAD	
PROPERTY OWNER	NNP IV– CAPE FEAR RIVER, LLC	
DEVELOPER	NNP IV– CAPE FEAR RIVER LLC	
MAP SCALE	1"=60'	
PROPERTY BOUNDARY		
TAX PARCEL IDENTIFICATION NUMBER	R07000–006–009–000	
ZONING DISTRICT	MX	
TOTAL ACREAGE WITHIN THE RIVER ROAD BOUNDARY	1,329.41 ACRES (57,909,099.6 SF)	
TOTAL ACREAGE WITHIN THE MARINA VILLAGE BOUNDARY	38.67 ACRES (1,684,343 SF)	
ADJACENT PROPERTY		
ADJACENT PROPERTY	PROPERTY	ZONING
	WATERMARK MARINA	LI
	DUKE PROGRESS ENERGY	I–2
VICINITY		
VICINITY MAP	SEE CX–101	
TOPOGRAPHY AND DRAINAGE		
2–FT TOPOGRAPHY MINIMUM INTERVAL	SEE CX–101	
DATE OF TOPOGRAPHY DATA	5/5/2015	
100–YR FLOODPLAIN LINE	SEE CX–101	
LOCATION OF NATURAL WATER FEATURES	LOCATION	CLASSIFICATION
DITCHES	SEE CX–101	NON–JURISDICTIONAL
STREAMS	N/A	
CREEKS	N/A	
FLOOD PRONE AREAS	SEE CX–101	
AREAS OF NATURALLY CONCENTRATED SURFACE DRAINAGE	N/A	
SOIL		
SOIL TYPE(S) AND BOUNDARIES	SEE CX–101	
NORTH CAROLINA COASTAL AREA MANAGEMENT AD INFORMATION		
CAMA AREA OF ENVIRONMENTAL CONCERN	SEE CX–101	
SETBACKS	75 FT	
CAMA LAND USE CLASSIFICATION(S)	TRANSITION/CONSERVATION	
CONSERVATION RESOURCE REGULATIONS		
PRESENCE OF CONSERVATION RESOURCE	PRESENCE; SEE CX–101	
SETBACKS	TABLE; SEE CX–101	
VEGETATED BUFFER	35' BUFFER, SEE CX–101	
HISTORIC AND ARCHEOLOGICAL SITES		
LOCAL, STATE,OR FEDERALLY RECOGNIZED HISTORIC STRUCTURE(S) OR ARCHEOLOGICAL RESOURCES	NOT PRESENT	
LOCATION	N/A	
CEMETERIES		
CEMETERIES, BURIAL SITES, OR BURIAL GROUNDS?	NOT PRESENT	
FORESTED AREAS		
BOUNDARIES OF FORESTED AREAS	SEE CX–101	
FOREST AREA	19.17 ACRES (835,039 SF)	
HABITAT	FORESTED WETLAND/TIDAL MARSH	
DOMINANT SPECIES	OAK, PINE	
WETLANDS		
404/SECTION 10 WETLAND LOCATION	PRESENCE; SEE CX–101	
METHOD OF DETERMINATION	FIELD SURVEY	
IMPACTED WETLANDS	N/A	
ENDANGERED SPECIES OR HABITAT		
ENDANGERED SPECIES OR HABITAT IN PROJECT AREA	NOT PRESENT	
AUTOMOBILE, BICYCLE, PEDESTRIAN, OR TRANSIT FACILITIES		
EXISTING OR PROPOSED THOROUGHFARES, BIKE ROUTES, PEDESTRIAN SIDEWALKS OR TRAILS, AND TRANSIT FACILITIES	NOT PRESENT	

LEGEND

- RBC = REBAR & CAP
- = POWER POLE
- = SANITARY SEWER MANHOLE
- = WETLAND
- OHE OHE = OVERHEAD ELECTRIC LINE
- COD COD = CITY OF WILMINGTON CONSERVATION RESOURCE SETBACK LINE
- SS SS = SANITARY SEWER MAIN
- MHW MHW = MEAN HIGH WATER
- AEC AEC AEC = AREA OF ENVIRONMENTAL CONCERN
- = 100-YEAR FLOODPLAIN (PRELIMINARY)
- = 100-YEAR FLOODPLAIN (EFFECTIVE)
- = COASTAL MARSH LINE
- = 35' CONSERVATION RESOURCE VEGETATED BUFFER
- TPF = TREE PROTECTION FENCE
- LOD LOD = LIMITS OF DISTURBANCE
- SF = SILT FENCE
- >TDD >TDD = TEMPORARY DIVERSION DITCH
- = CAMA CLASSIFCATION BOUNDARY

CONSERVATION RESOURCE SETBACK TABLE		
CONSERVATION RESOURCE	RES	COMM
POCOSIN	25'	50'
SAVANNAH	25'	50'
BRACKISH/SALT MARSH	75'	100'

REFERENCE: LDC 18–341 (d) 5h

TREE LEGEND

- = CEDAR
- = GUM
- = HOLLY
- = OAK
- = MAPLE
- = PINE

GENERAL NOTES:

1. FLOODPLAIN INFORMATION WAS OBTAINED FROM NC FLOODPLAIN MAPPING FLOOD RISK INFORMATION SYSTEM PROGRAM. RIVERLIGHTS IS LOCATED WITHIN FIRM MAP 3720312400K, PANEL 3124 AS REVISED JUNE 02, 2006.
2. ITEMS DESIGNATED AS "PROPOSED" ARE PART OF THE RIVER ROAD REALIGNMENT PROJECT THAT IS CURRENTLY UNDER CONSTRUCTION. RIVER ROAD CONSTRUCTION TO BE COMPLETE SPRING 2016.
3. WETLANDS SHOWN IN THIS PORTION OF RIVERLIGHTS WERE DESCRIBED AS BRACKISH/SALT MARSH AND POCOSIN WETLANDS AND CONSERVATION RESOURCE SETBACK LINES WERE GENERATED AS 100' FOR COMMERCIAL, 75' FOR RESIDENTIAL, AND 25', RESPECTIVELY, MINIMUM OUTSIDE OF THE RESOURCE.
4. FINISHED FLOOR ELEVATIONS OFF ALL INHABITABLE STRUCTURES WILL BE MIN. 2–FEET ABOVE BASE FLOOD ELEVATION

SURVEY NOTES:

1. ALL DISTANCES ARE HORIZONTAL GROUND IN US SURVEY FEET UNLESS OTHERWISE SHOWN.
2. BEARINGS BASED ON NCGRID NAD83.
3. VERTICAL DATUM IS NAVD 88.
4. UNDERGROUND UTILITIES ARE SHOWN ONLY WHERE ABOVEGROUND SERVICES WERE VISIBLE.

For each open utility cut of City streets, a $325 permit shall be required from the City prior to occupancy and/or project acceptance.

1 inch

Approved Construction Plan

	Name	Date
Planning		12/7/16
Traffic		12-13-16
Fire		12.16.16

CITY OF WILMINGTON NORTH CAROLINA
Public Services • Engineering Division
APPROVED STORMWATER MANAGEMENT PLAN
Date: 12/15/16 Permit # 20150218Z
Signed:

REV.NO.	DESCRIPTIONS	DATE
4	CITY OF WILMINGTON ENGINEERING COMMENTS	09/21/2016
3	CITY OF WILMINGTON TRC COMMENTS	08/23/2016
2	SITE PLAN AND STORM DRAINAGE REVISIONS	07/19/2016
1	CPRUA COMMENTS	04/11/2016
0	ISSUED FOR CONSTRUCTION	03/17/2016

REVISIONS

SEAL

SEAL
NORTH CAROLINA PROFESSIONAL ENGINEER SEAL 035107 CIVIL NICHOLAS J. LAURETTA
09/21/16

McKIM&CREED
243 North Front Street
Wilmington, North Carolina 28401
Phone: (910)343–1048, Fax: (910)251–8282
License: F–1222
www.mckimcreed.com

NORTH AMERICA SEKISUI HOUSE, LLC

RIVERLIGHTS™

RIVERLIGHTS MARINA VILLAGE PHASE 1B

EXISTING CONDITIONS SITE INVENTORY MAP

DATE:	17MAR16
MCE PROJ. #	2735–0124
DRAWN	ALM
DESIGNED	NJL
CHECKED	KCBE
PROJ. MGR.	NJL

SCALE: HORIZONTAL: 1"=60' VERTICAL: N/A

MAC FILE NUMBER: CX–101
DRAWING NUMBER: 4

STATUS: FINAL DESIGN
ISSUED FOR CONSTRUCTION
REVISION 0

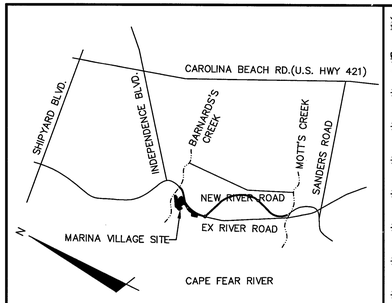

VICINITY MAP

NOT TO SCALE

404 WETLAND (POCOSIN)

404 WETLAND (BRACKISH)

PROJECT BOUNDARY

REALIGNED RIVER ROAD (330' PUBLIC R/W)

50.0' PIEDMONT NATURAL GAS EASEMENT

50.0' DUKE PROGRESS ACCESS EASEMENT

170.0' DUKE PROGRESS TRANSMISSION EASEMENT

TREE LINE (TYP.)

35' VEGETATED BUFFER

CAMA AREA OF ENVIRONMENTAL CONCERN (AEC)

CITY OF WILMINGTON CONSERVATION RESOURCE LINE PER LDC ARTICLE 6, DIVISION III, SECTION 18-341

100-YR FLOODPLAIN (EFFECTIVE)(AE9)

MEAN HIGH WATER (APPROX. EL. 2)

CAMA CLASSIFICATION BOUNDARY

100-YR FLOODPLAIN (PRELIMINARY)(AE9)

COASTAL MARSH LINE

CAPE FEAR RIVER

60' 0 60' 120'

SCALE: 1"=60' (Horiz.)

LEGEND

- RBC = REBAR & CAP
- = POWER POLE
- = SANITARY SEWER MANHOLE
- = WETLAND
- OHE = OVERHEAD ELECTRIC LINE
- COD = CITY OF WILMINGTON CONSERVATION RESOURCE SETBACK LINE
- SS = SANITARY SEWER MAIN
- MHW = MEAN HIGH WATER
- AEC = AREA OF ENVIRONMENTAL CONCERN
- = 100-YEAR FLOODPLAIN (PRELIMINARY)
- = 100-YEAR FLOODPLAIN (EFFECTIVE)
- = COASTAL MARSH LINE
- = 35' CONSERVATION RESOURCE VEGETATED BUFFER
- TPF = TREE PROTECTION FENCE
- LOD = LIMITS OF DISTURBANCE
- SF = SILT FENCE
- >TDD = TEMPORARY DIVERSION DITCH
- = CAMA CLASSIFCATION BOUNDARY

TREE LEGEND

- = CEDAR
- = GUM
- = HOLLY
- = OAK
- = MAPLE
- = PINE
- = TREE TO BE REMOVED

Approved Construction Plan

	Name	Date
Planning		12/15/16
Traffic		12-13-16
Fire		12-16-16

CITY OF WILMINGTON NORTH CAROLINA
Public Services • Engineering Division
APPROVED STORMWATER MANAGEMENT PLAN
Date: 12/15/16 Permit # 20150212
Signed:

For each open utility cut of City streets, a $325 permit shall be required from the City prior to occupancy and/or project acceptance.

1 inch

CONSERVATION RESOURCE SETBACK TABLE		
CONSERVATION RESOURCE	RES	COMM
POCOSIN	25'	50'
SAVANNAH	25'	50'
BRACKISH/SALT MARSH	75'	100'

REFERENCE: LDC 18-341 (d) 5h

REV.NO.	DESCRIPTIONS	DATE
	REVISIONS	
4	CITY OF WILMINGTON ENGINEERING COMMENTS	09/21/2016
3	CITY OF WILMINGTON TRC COMMENTS	08/23/2016
2	SITE PLAN AND STORM DRAINAGE REVISIONS	07/19/2016
1	CFPUA COMMENTS	04/11/2016
0	ISSUED FOR CONSTRUCTION	03/17/2016

SEAL

SEAL
NORTH CAROLINA PROFESSIONAL CIVIL 035107 ENGINEER NICHOLAS J. LAURITTA
09/21/16

McKIM & CREED
243 North Front Street
Wilmington, North Carolina 28401
Phone: (910)343-1048, Fax: (910)251-8282
License: F-1222
www.mckimcreed.com

NORTH AMERICA SEKISUI HOUSE, LLC

RIVERLIGHTS™

RIVERLIGHTS MARINA VILLAGE PHASE 1B

TREE REMOVAL PLAN

DATE:	17MAR16
MCE PROJ. #	2735-0124
DRAWN	ALM
DESIGNED	N.JL
CHECKED	KCBE
PROJ. MGR.	N.JL

SCALE: HORIZONTAL: 1"=60' VERTICAL: N/A

M&C FILE NUMBER: CX-102
DRAWING NUMBER: 5

STATUS: FINAL DESIGN
ISSUED FOR CONSTRUCTION
REVISION 3

S:\27xx\2735\124 Marina Village\dwg\Plan Sheets\Tree Removal\TREE REMOVAL.dwg

NOTE:

- CONSTRUCTION AND GRADING WILL NOT DISTURB THE WETLAND/CONSERVATION RESOURCE.

For each open utility cut of City streets, a $325 permit shall be required from the City prior to occupancy and/or project acceptance.

1 inch

Approved Construction Plan

	Name	Date
Planning		12/13/16
Traffic	W Saunders	12/13/16
Fire	S Howes	12/16/16

CITY OF WILMINGTON NORTH CAROLINA
Public Services • Engineering Division
APPROVED STORMWATER MANAGEMENT PLAN
Date: 12/15/16 Permit # 20150219.02
Signed:

2.5:1 GRADING STABILIZE USING LANDLOK 450 OR APPROVED EQUAL

2:1 GRADING STABILIZE USING LANDLOK 450 OR APPROVED EQUAL











N

30' 0 30' 60'

SCALE: 1"=30' (Horiz.)

MARINA VILLAGE - PHASE 1B NORTH

SCALE: 1" = 30'

REV.NO.	DESCRIPTIONS	DATE
	REVISIONS	
4	CITY OF WILMINGTON ENGINEERING COMMENTS	09/21/2016
3	CITY OF WILMINGTON TRC COMMENTS	08/23/2016
2	SITE PLAN AND STORM DRAINAGE REVISIONS	07/19/2016
1	CFPUA COMMENTS	04/11/2016
0	ISSUED FOR CONSTRUCTION	03/17/2016

SEAL

SEAL
NORTH CAROLINA PROFESSIONAL CIVIL 035107 ENGINEER NICHOLAS J. LAURETTA
9/21/16

McKIM & CREED
243 North Front Street
Wilmington, North Carolina 28401
Phone: (910)343-1048, Fax: (910)251-8282
License: F-1222
www.mckimcreed.com

NORTH AMERICA SEKISUI HOUSE, LLC

RIVERLIGHTS™

RIVERLIGHTS MARINA VILLAGE PHASE 1B

GRADING PLAN NORTH

DATE:	17MAR16
MCE PROJ. #	2735-0124
DRAWN	ALM
DESIGNED	NJL
CHECKED	KCBE
PROJ. MGR.	NJL

SCALE: HORIZONTAL: 1"=30' VERTICAL: N/A

M&C FILE NUMBER: CG-101
DRAWING NUMBER: 8

STATUS: FINAL DESIGN
ISSUED FOR CONSTRUCTION
REVISION 3

S:\Projects\2735\0124 Riverlights Marina Village\Drawings\Phase 1B\CG-103.dwg

For each open utility cut of City streets, a $325 permit shall be required from the City prior to occupancy and/or project acceptance.

1 inch

Approved Construction Plan

	Name	Date
Planning		12/12/16
Traffic		12-12-16
Fire		12.16.16

CITY OF WILMINGTON NORTH CAROLINA
Public Services • Engineering Division
APPROVED STORMWATER MANAGEMENT PLAN
Date: 12/15/16 Permit # 20150218Z
Signed:

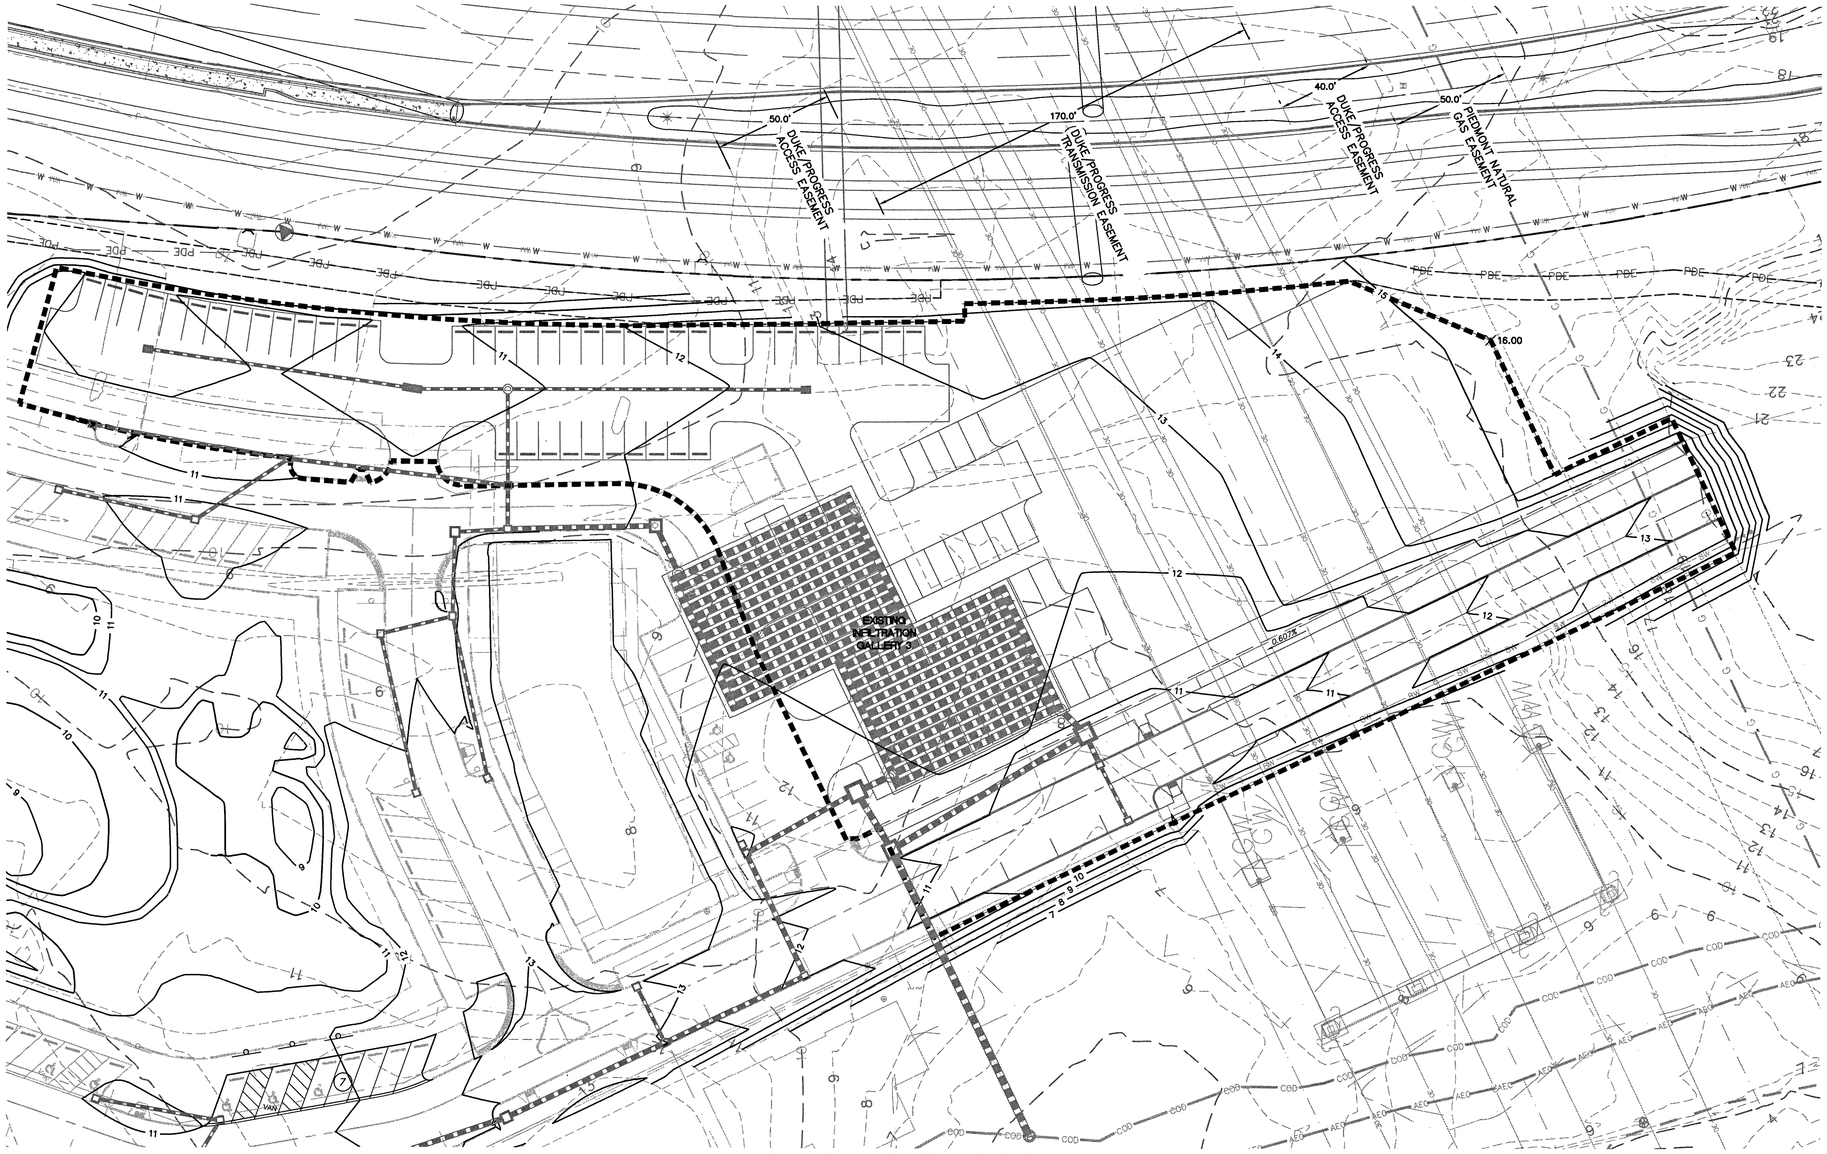

MARINA VILLAGE - PHASE 1B SOUTH
SCALE: 1" = 50'

N

30' 0 30' 60'
SCALE: 1"=30' (Horiz.)

NOTE:

- CONSTRUCTION AND GRADING WILL NOT DISTURB THE WETLAND/CONSERVATION RESOURCE.

REV.NO.	DESCRIPTIONS	DATE
	REVISIONS	
4	CITY OF WILMINGTON ENGINEERING COMMENTS	09/21/2016
3	CITY OF WILMINGTON TRC COMMENTS	08/23/2016
2	SITE PLAN AND STORM DRAINAGE REVISIONS	07/19/2016
1	CFPUA COMMENTS	04/11/2016
0	ISSUED FOR CONSTRUCTION	03/17/2016

SEAL

SEAL
NORTH CAROLINA PROFESSIONAL CIVIL 035107 ENGINEER NICHOLAS J. LAURETTA
9/21/16

McKIM&CREED
243 North Front Street
Wilmington, North Carolina 28401
Phone: (910)343-1048, Fax: (910)251-8282
License: F-1222
www.mckimcreed.com

NORTH AMERICA SEKISUI HOUSE, LLC

RIVERLIGHTS™

RIVERLIGHTS MARINA VILLAGE PHASE 1B

GRADING PLAN SOUTH

DATE:	17MAR16
MCE PROJ. #	2735-0124
DRAWN	ALM
DESIGNED	N.JL
CHECKED	KCBE
PROJ. MGR.	N.JL

SCALE: HORIZONTAL: 1"=30' VERTICAL: N/A

M&C FILE NUMBER: CG-102
DRAWING NUMBER: 9

STATUS: FINAL DESIGN
ISSUED FOR CONSTRUCTION
REVISION: 2

MATERIALS AND STANDARDS NOTES:

- ALL CATCH BASINS ARE NCDOT STD 840.01
- ALL DROP INLETS IN TRAFFIC AREAS ARE NCDOT STD 840.35, ALL DROP INLETS IN LANDSCAPE AREAS ARE CITY OF WILMINGTON STD 2-02 & 14-04.
- ALL STORM DRAINAGE PIPING TO BE CLASS III RCP, UNLESS OTHERWISE NOTED.

STRUCTURE TABLE – STRM – I4–I5	
STR. NAME	DETAILS
CB–401	RIM = 12.33 SUMP = 9.85 INV OUT = 9.85W
CB–402	RIM = 12.39 SUMP = 9.74 INV IN =9.74E INV OUT = 9.74NE
CB–403	RIM = 11.80 SUMP = 9.30 INV IN =9.30SW INV OUT = 9.30NE
CB–404	RIM = 11.28 SUMP = 8.76 INV IN =8.76SW INV OUT = 8.76SE
CB–405	RIM = 11.04 SUMP = 8.13 INV IN =8.13NW INV OUT = 8.13SE
CB–405A	RIM = 11.03 SUMP = 8.02 INV OUT = 8.02SE
CB–406	RIM = 11.43 SUMP = 7.74 INV IN =7.74NW INV OUT = 7.74SE
CB–409	RIM = 11.80 SUMP = 7.38 INV IN =7.38NW INV OUT = 7.38SE
CB–410	RIM = 11.82 SUMP = 7.95 INV OUT = 7.95NW

STRUCTURE TABLE – STRM – I4–I5	
STR. NAME	DETAILS
CB–417	RIM = 10.39 SUMP = 7.54 INV IN =7.54SE INV OUT = 7.54NE
CB–418	RIM = 10.37 SUMP = 7.66 INV IN =7.66NE INV OUT = 7.66NW
CB–419	RIM = 11.06 SUMP = 7.48 INV IN =7.48SE INV OUT = 7.48SW
CB–420	RIM = 11.04 SUMP = 7.63 INV OUT = 7.63NW
CB–424	RIM = 12.22 SUMP = 7.29 INV OUT = 7.29NW
DI–407	RIM = 11.13 SUMP = 6.04 INV OUT = 6.04E INV OUT = 7.10NW
DI–408	RIM = 12.09 SUMP = 7.20 INV IN =7.20NW INV IN =7.20SE INV OUT = 7.20NE
DI–411	RIM = 11.11 SUMP = 7.50 INV IN =7.50NE INV OUT = 7.50SW
DI–412	RIM = 10.48 SUMP = 7.23 INV IN =7.23NE INV OUT = 7.23SW

STRUCTURE TABLE – STRM – I4–I5	
STR. NAME	DETAILS
DI–412A	RIM = 10.48 SUMP = 7.23 INV IN =7.23NE INV OUT = 7.23SW
DI–413	RIM = 10.58 SUMP = 7.16 INV IN =7.16NE INV IN =7.16S INV OUT = 7.16SE
DI–413A	RIM = 10.55 SUMP = 7.16 INV IN =7.16NE INV OUT = 7.16SW
DI–414	RIM = 12.27 SUMP = 7.61 INV OUT = 7.61N
DI–415	RIM = 11.49 SUMP = 6.08 INV OUT = 7.08W
DI–416	RIM = 10.64 SUMP = 6.34 INV IN =7.34NE INV IN =7.34SW INV OUT = 7.34NW INV OUT = 7.34SE
DI–421	RIM = 11.10 SUMP = 6.09 INV IN =7.09SE INV OUT = 7.09NW
DI–422	RIM = 11.10 SUMP = 6.85 INV OUT = 7.85SW
DI–423	RIM = 10.91 SUMP = 6.07 INV IN =7.07NW INV OUT = 7.07SE

STRUCTURE TABLE – STRM – I4–I5	
STR. NAME	DETAILS
DI–424	RIM = 12.50 SUMP = 6.03 INV IN =7.03SW INV OUT = 7.03NE
EW–4	RIM = 7.00 INV IN =3.89S
I–4A	RIM = 11.07 SUMP = 7.00 INV IN =7.00NW
I–4B	RIM = 11.58 SUMP = 7.00 INV IN =7.00E
I–4C	RIM = 11.25 SUMP = 7.00 INV IN =7.00SE
I–5A	RIM = 11.81 SUMP = 7.00 INV IN =7.00SW
I–5B	RIM = 11.33 SUMP = 7.00 INV IN =7.00SE
JB–407A	RIM = 9.85 SUMP = 4.46 INV IN =4.46SW INV OUT = 4.46N
JB–416A	RIM = 9.56 SUMP = 7.00 INV IN =7.00NW INV IN =7.00SW INV OUT = 7.00NE

STRUCTURE TABLE – STRM – I3B	
STR. NAME	DETAILS
DI–501	RIM = 12.11 SUMP = 7.57 INV OUT = 8.57N
DI–502	RIM = 10.75 SUMP = 7.14 INV IN =8.14N INV OUT = 8.14S
DI–502A	RIM = 10.75 SUMP = 7.14 INV IN =8.14N INV OUT = 8.14S
DI–503	RIM = 10.86 SUMP = 7.54 INV OUT = 8.54S
EX. CB–318	RIM = 10.48 SUMP = 7.76 INV IN =7.76E
SDMH–2	RIM = 10.92 SUMP = 6.95 INV IN =7.95N INV IN =7.95S INV OUT = 7.95W

STRUCTURE TABLE – STRM – I4–I5	
STR. NAME	DETAILS
SDMH–1	RIM = 11.46 SUMP = 7.59 INV IN =7.59SE INV IN =7.59NW INV OUT = 7.59SW

STORM DRAINAGE PIPE DATA TABLE – STRM – I4–I5							
FROM	TO	LENGTH	SIZE	PIPE TYPE	SLOPE	UPSTREAM INVERT	DOWNSTREAM INVERT
SDMH–1	DI–411	17.50'	15"	RCP	0.51%	7.59'	7.50'
JB–416A	JB–407A	222.59'	24"	RCP	1.14%	7.00'	4.46'
JB–407A	EW–4	118.34'	30"	RCP	0.48%	4.46'	3.89'
DI–424	I–5A	15.00'	15"	CAP	0.22%	7.03'	7.00'
DI–423	I–4A	16.00'	15"	CAP	0.42%	7.07'	7.00'
DI–422	CB–418	48.51'	15"	CL IV RCP	0.40%	7.85'	7.66'
DI–421	I–4C	21.30'	18"	CAP	0.40%	7.09'	7.00'
DI–416	JB–416A	64.81'	18"	DUAL 18" RCP	0.52%	7.34'	7.00'
DI–416	DI–421	62.85'	18"	RCP	0.40%	7.34'	7.09'
DI–415	I–4B	6.39'	15"	CAP	1.25%	7.08'	7.00'
DI–414	DI–413	90.58'	15"	RCP	0.50%	7.61'	7.16'
DI–413A	DI–413	4.01'	15"	RCP	0.00%	7.16'	7.16'
DI–413	DI–423	22.64'	15"	RCP	0.42%	7.16'	7.07'
DI–412A	DI–413A	15.31'	15"	RCP	0.46%	7.23'	7.16'
DI–412	DI–412A	3.97'	15"	RCP	0.00%	7.23'	7.23'
DI–411	DI–412	53.12'	15"	RCP	0.51%	7.50'	7.23'
DI–408	DI–424	75.34'	15"	RCP	0.22%	7.20'	7.03'
DI–407	JB–407A	22.85'	18"	RCP	2.54%	6.04'	5.46'
DI–407	I–5B	20.91'	18"	CAP	0.50%	7.10'	7.00'
CB–424	DI–408	25.50'	15"	RCP	0.34%	7.29'	7.20'
CB–420	CB–419	29.30'	15"	RCP	0.50%	7.63'	7.48'

STORM DRAINAGE PIPE DATA TABLE – STRM – I4–I5							
FROM	TO	LENGTH	SIZE	PIPE TYPE	SLOPE	UPSTREAM INVERT	DOWNSTREAM INVERT
CB–419	DI–416	27.40'	15"	RCP	0.50%	7.48'	7.34'
CB–418	CB–417	29.30'	15"	CL IV RCP	0.40%	7.66'	7.54'
CB–417	DI–416	48.99'	15"	CL IV RCP	0.40%	7.54'	7.34'
CB–410	SDMH–1	72.71'	15"	RCP	0.50%	7.95'	7.59'
CB–409	DI–408	59.62'	15"	RCP	0.30%	7.38'	7.20'
CB–406	CB–409	72.73'	15"	RCP	0.50%	7.74'	7.38'
CB–405A	SDMH–1	84.00'	15"	RCP	0.51%	8.02'	7.59'
CB–405	CB–406	78.03'	15"	RCP	0.50%	8.13'	7.74'
CB–404	CB–405	34.46'	15"	CL IV RCP	1.83%	8.76'	8.13'
CB–403	CB–404	106.80'	15"	CL IV RCP	0.50%	9.30'	8.76'
CB–402	CB–403	88.45'	15"	CL IV RCP	0.50%	9.74'	9.30'
CB–401	CB–402	21.30'	15"	CL IV RCP	0.50%	9.85'	9.74'
	JB–416A	138.32'	24"	RCP	0.06%	7.08'	7.00'

STORM DRAINAGE PIPE DATA TABLE – STRM – I3B							
FROM	TO	LENGTH	SIZE	PIPE TYPE	SLOPE	UPSTREAM INVERT	DOWNSTREAM INVERT
SDMH–2	EX. CB–318	40.27'	15"	RCP	0.48%	7.95'	7.76'
DI–503	DI–502A	109.99'	15"	CL IV RCP	0.36%	8.54'	8.14'
DI–502A	DI–502	4.01'	15"	CL IV RCP	0.00%	8.14'	8.14'
DI–502	SDMH–2	37.99'	15"	CL IV RCP	0.50%	8.14'	7.95'
DI–501	SDMH–2	124.80'	15"	RCP	0.50%	8.57'	7.95'

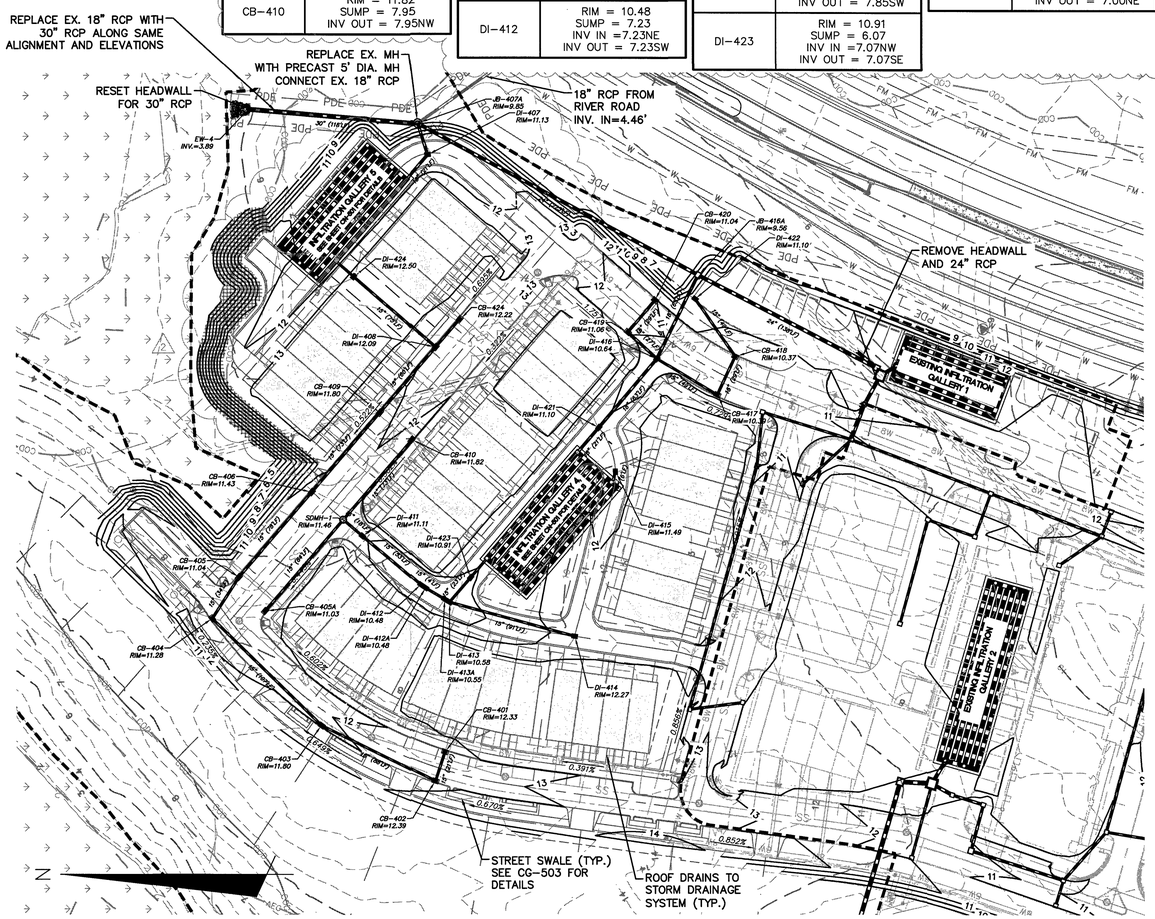

MARINA VILLAGE – PHASE 1B NORTH

SCALE: 1" = 50'

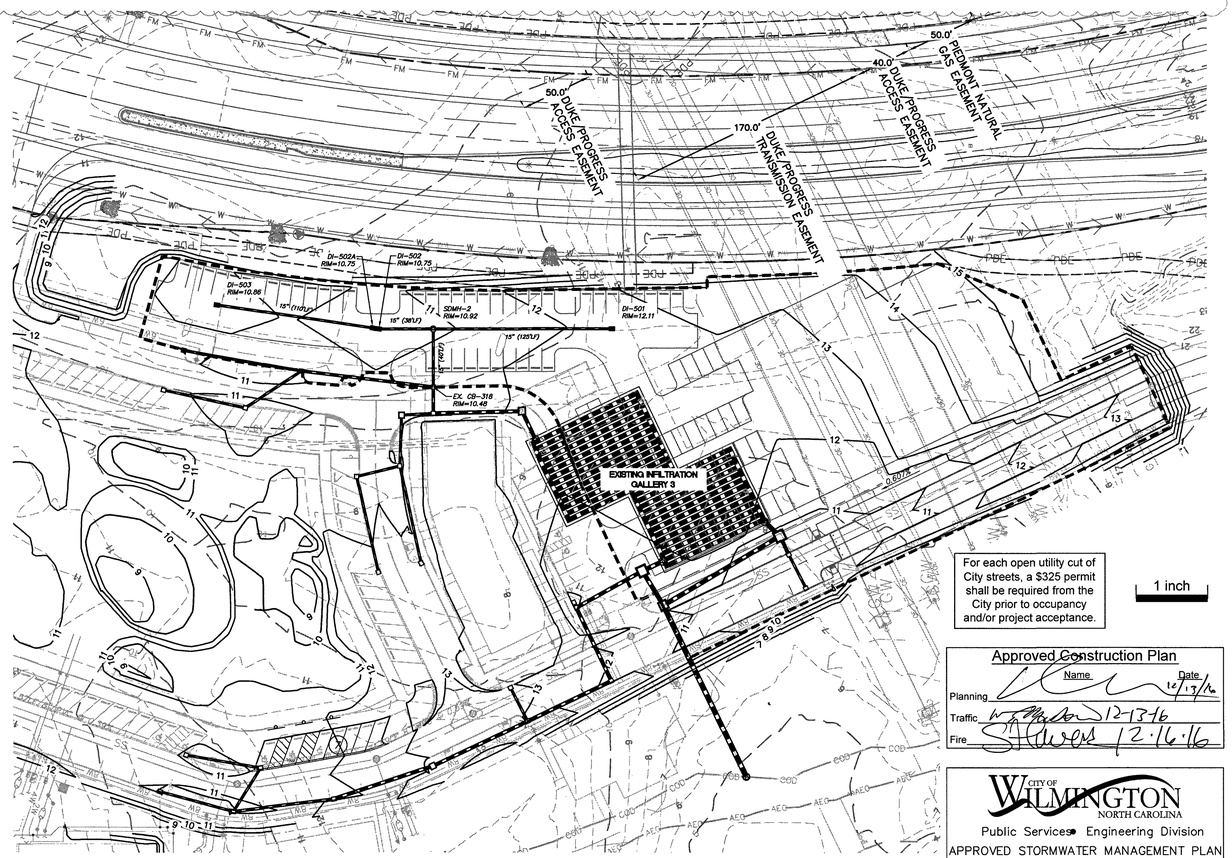

MARINA VILLAGE – PHASE 1B SOUTH

SCALE: 1" = 50'

NOTE:

- CONSTRUCTION AND GRADING WILL NOT DISTURB THE WETLAND/CONSERVATION RESOURCE.

For each open utility cut of City streets, a $325 permit shall be required from the City prior to occupancy and/or project acceptance.

1 inch

Approved Construction Plan

	Name	Date
Planning		12/19/16
Traffic		12-13-16
Fire		12.16.16

CITY OF WILMINGTON NORTH CAROLINA
Public Services • Engineering Division
APPROVED STORMWATER MANAGEMENT PLAN
Date: 12/15/16 Permit # 20150282
Signed:

REV.NO.	DESCRIPTIONS	DATE
	REVISIONS	
4	CITY OF WILMINGTON ENGINEERING COMMENTS	09/21/2016
3	CITY OF WILMINGTON TRC COMMENTS	08/23/2016
2	SITE PLAN AND STORM DRAINAGE REVISIONS	07/19/2016
1	CFPUA COMMENTS	04/11/2016
0	ISSUED FOR CONSTRUCTION	03/17/2016

SEAL

SEAL
NORTH CAROLINA PROFESSIONAL ENGINEER SEAL 035107 NICHOLAS J. LABERTA
9/21/16

McKIM & CREED
243 North Front Street
Wilmington, North Carolina 28401
Phone: (910)343-1048, Fax: (910)251-8282
License: F-1222
www.mckimcreed.com

NORTH AMERICA SEKISUI HOUSE, LLC

RIVERLIGHTS™

RIVERLIGHTS MARINA VILLAGE PHASE 1B

STORM DRAINAGE PLAN

DATE:	17MAR16
MCE PROJ. #	2735-0124
DRAWN	ALM
DESIGNED	NJL
CHECKED	KCBE
PROJ. MGR.	NJL

SCALE: HORIZONTAL: 1"=50' VERTICAL: N/A

M&C FILE NUMBER: CG–103

DRAWING NUMBER: 10

STATUS: FINAL DESIGN
ISSUED FOR CONSTRUCTION

REVISION 3

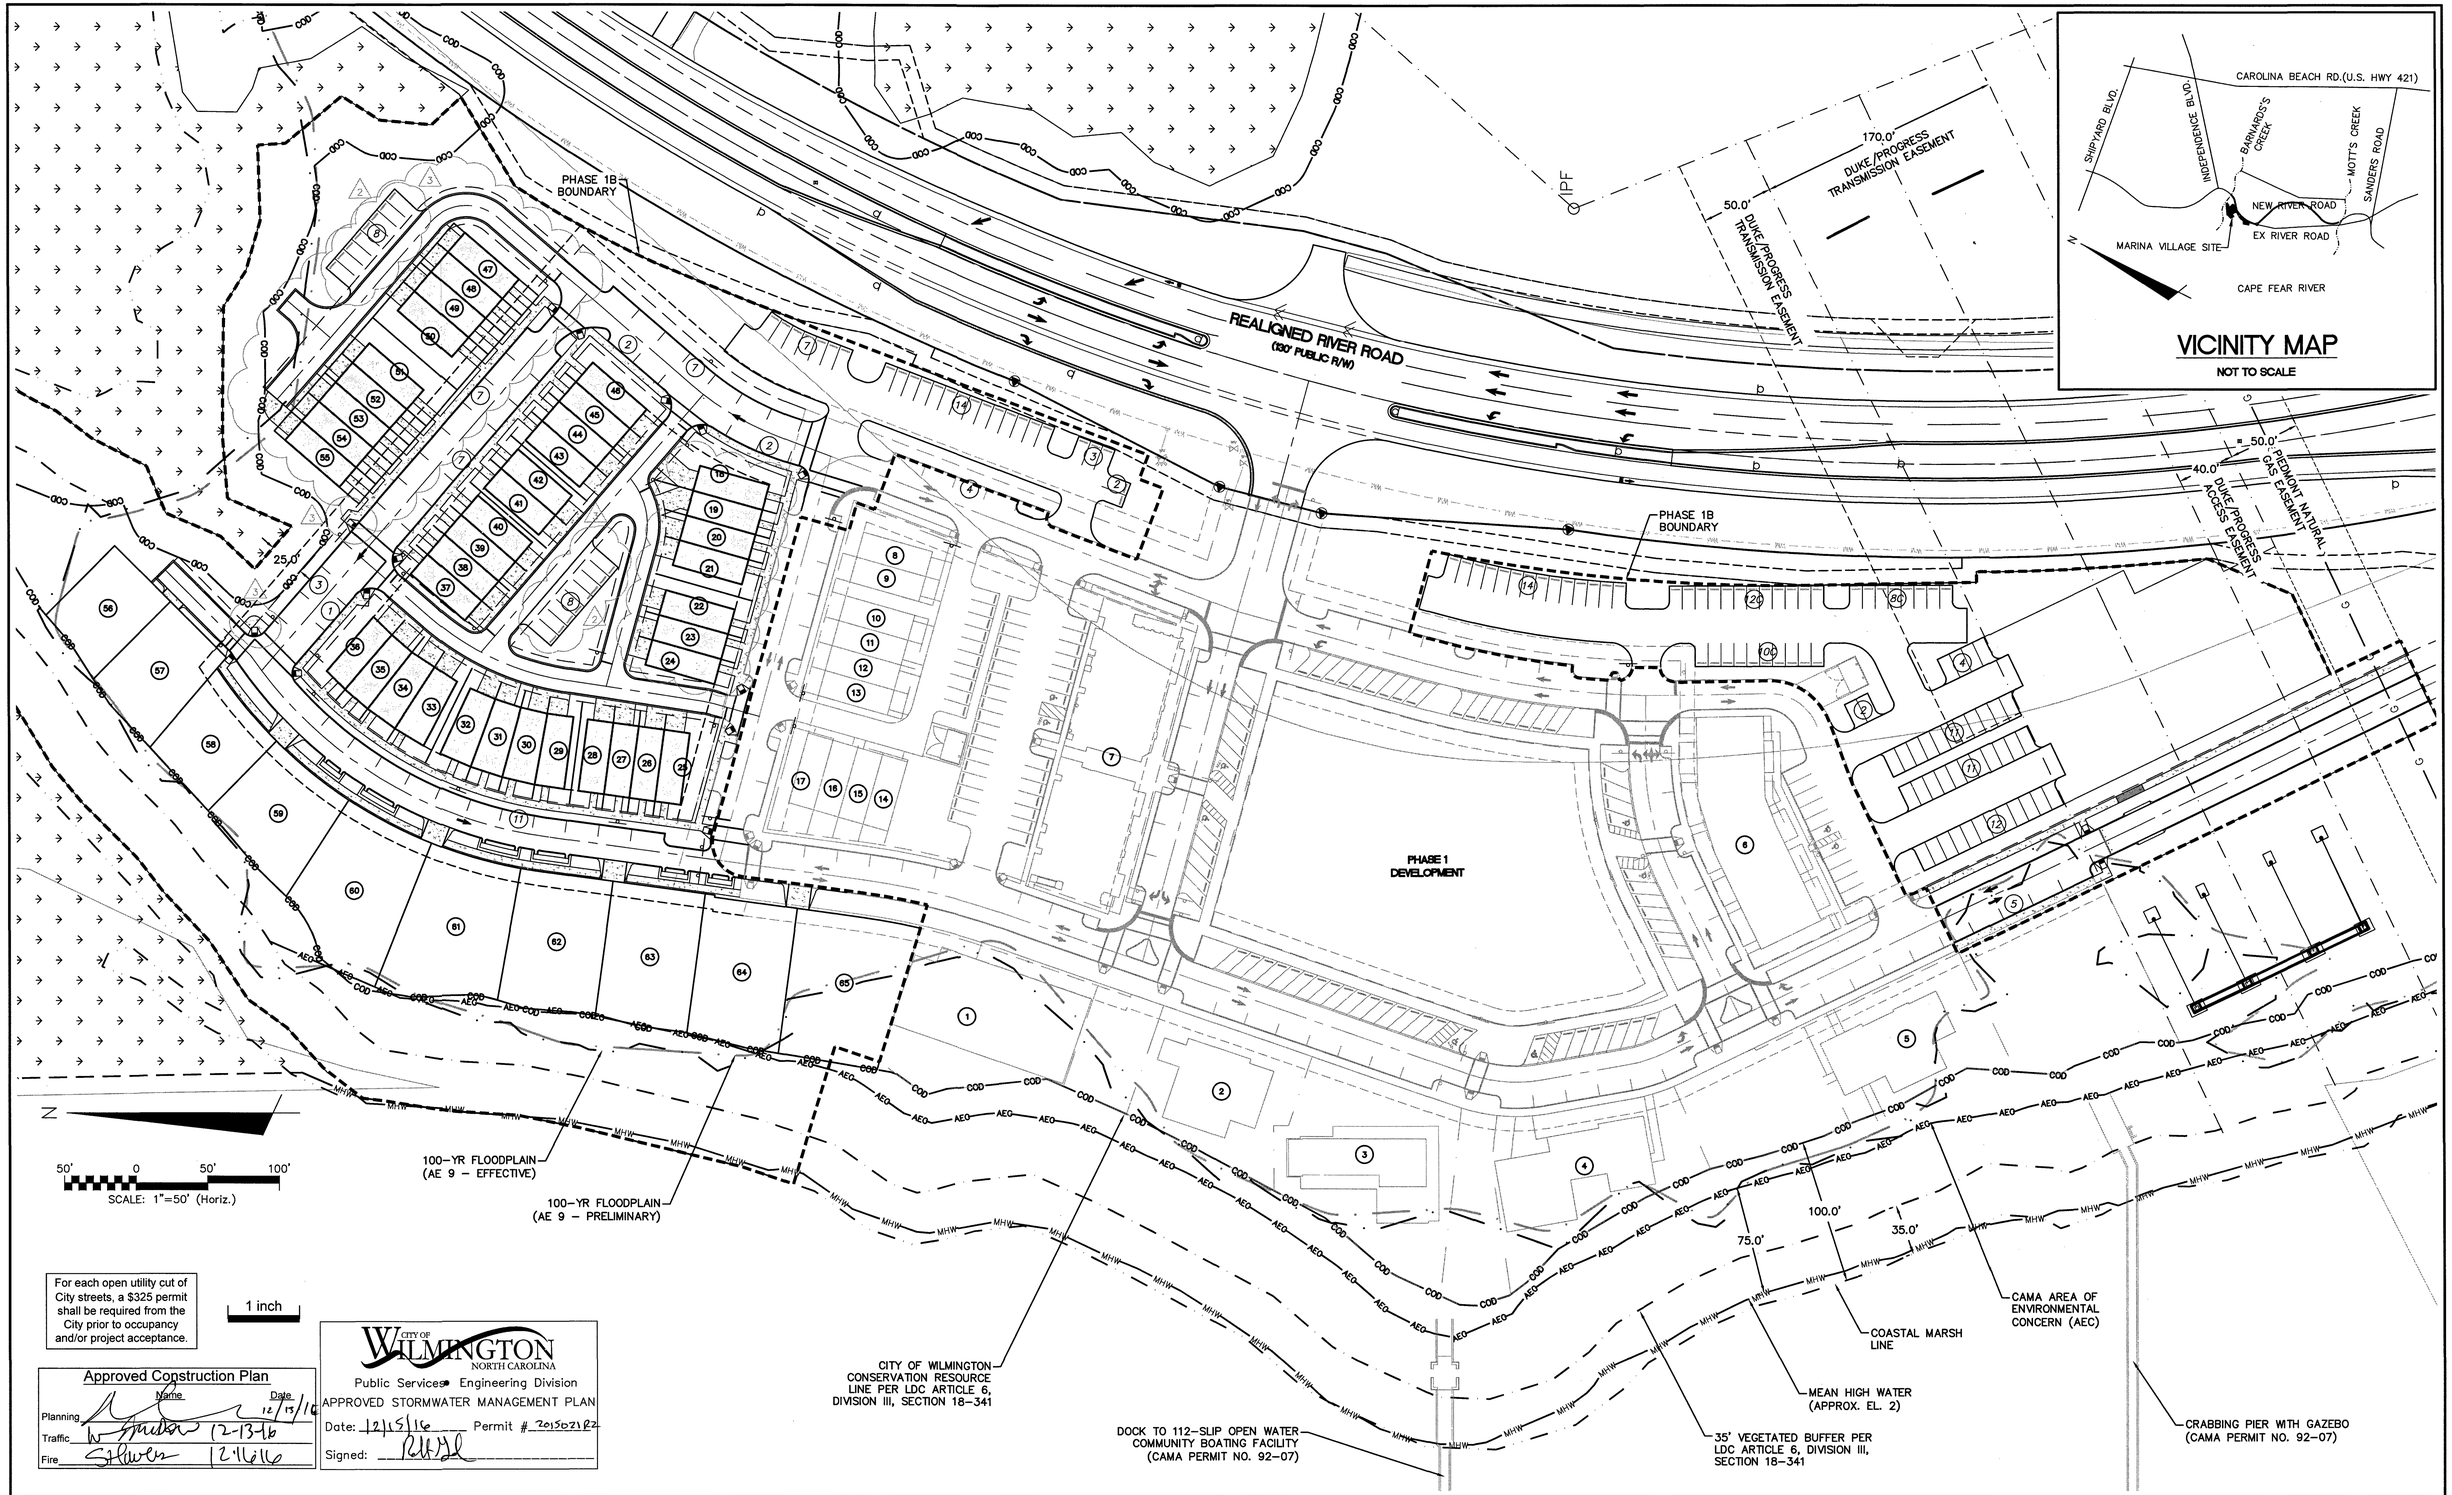

For each open utility cut of City streets, a $325 permit shall be required from the City prior to occupancy and/or project acceptance.

1 inch

Approved Construction Plan

	Name	Date
Planning		12/13/16
Traffic		12-13-16
Fire		12/16/16

CITY OF WILMINGTON NORTH CAROLINA
Public Services • Engineering Division
APPROVED STORMWATER MANAGEMENT PLAN
Date: 12/15/16 Permit # 20150218
Signed:

REV.NO.	DESCRIPTIONS REVISIONS	DATE
6	CITY OF WILMINGTON TRAFFIC COMMENTS	11/29/2016
5	UTILITY REVISION BASED ON PHASE 1 AS-BUILT CONDITIONS	10/04/2016
4	CITY OF WILMINGTON ENGINEERING COMMENTS	09/21/2016
3	CITY OF WILMINGTON TRC COMMENTS	08/23/2016
2	SITE PLAN AND STORM DRAINAGE REVISIONS	07/19/2016
1	CFPUA COMMENTS	04/11/2016
0	ISSUED FOR CONSTRUCTION	03/17/2016

SEAL

SEAL
NORTH CAROLINA PROFESSIONAL ENGINEER SEAL 035107 NICHOLAS J. LAURETTA
11/29/16

McKIM & CREED
243 North Front Street
CITY OF WILMINGTON TRAFFIC COMMENTS
Phone: (910)343-1048, Fax: (910)251-8282
License: F-1222
www.mckimcreed.com

NASH
NORTH AMERICA SEKISUI HOUSE, LLC
RIVERLIGHTS™

RIVERLIGHTS MARINA VILLAGE PHASE 1B

OVERALL SITE PLAN

DATE:	17MAR16
MCE PROJ. #	2735-0124
DRAWN	ALM
DESIGNED	NJL
CHECKED	KCBE
PROJ. MGR.	NJL

SCALE
HORIZONTAL: 1"=50'
VERTICAL: N/A

M&C FILE NUMBER CS-100
DRAWING NUMBER 11

STATUS: FINAL DESIGN
ISSUED FOR CONSTRUCTION
REVISION 3

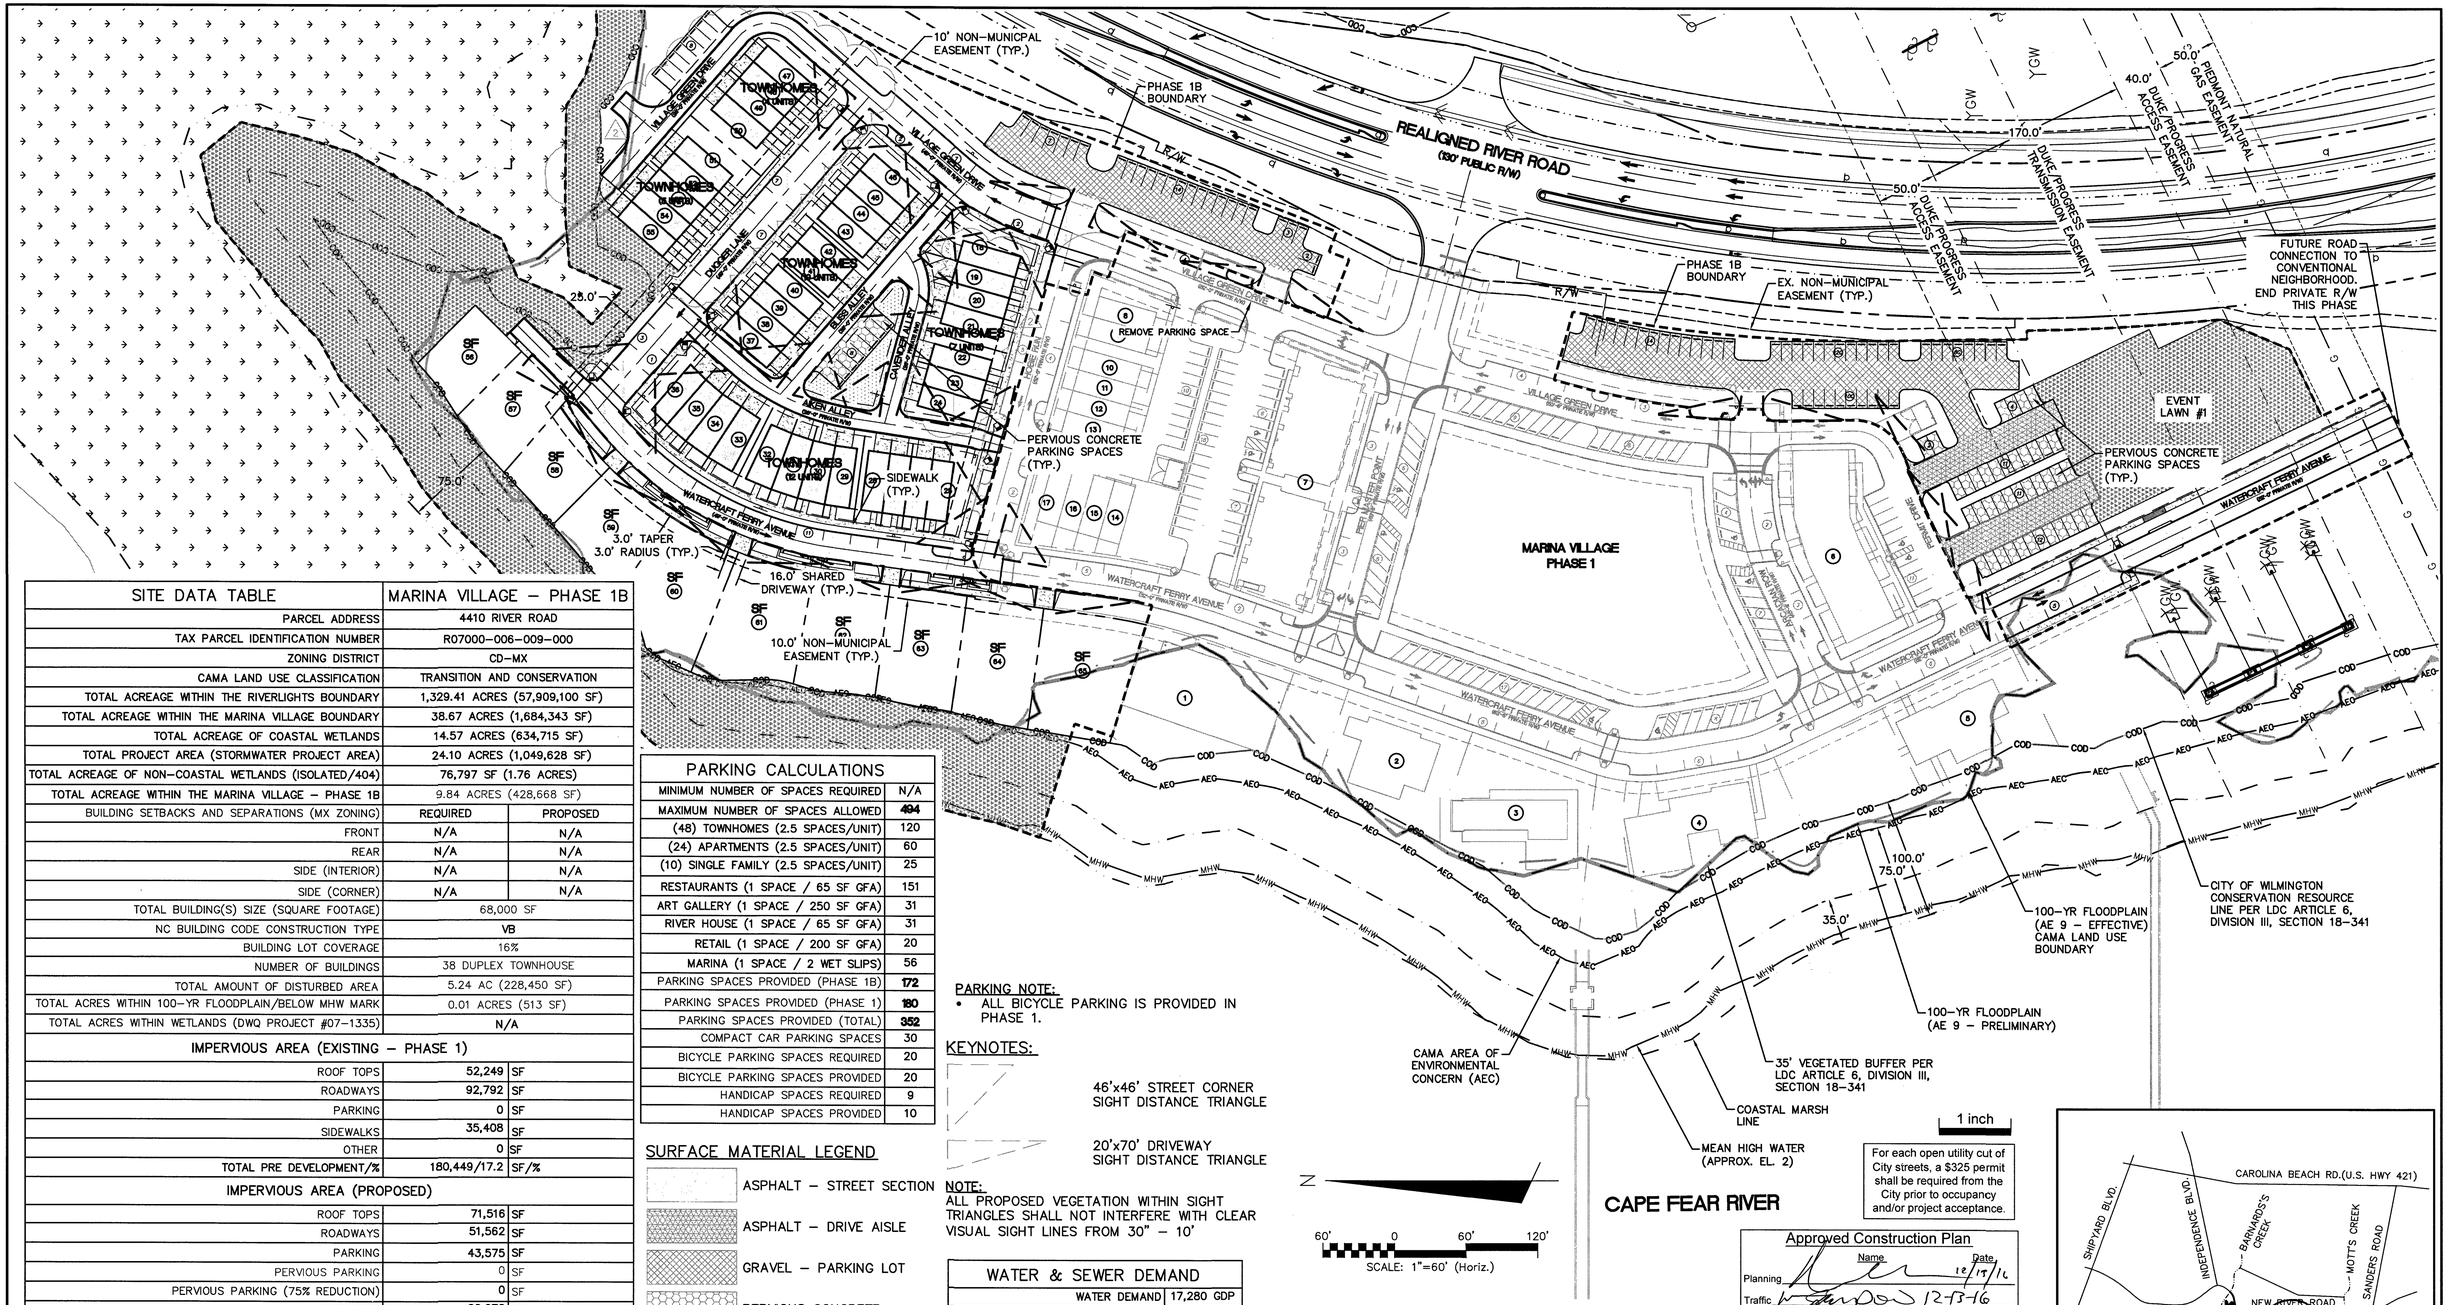

SITE DATA TABLE	MARINA VILLAGE – PHASE 1B	
PARCEL ADDRESS	4410 RIVER ROAD	
TAX PARCEL IDENTIFICATION NUMBER	R07000-006-009-000	
ZONING DISTRICT	CD-MX	
CAMA LAND USE CLASSIFICATION	TRANSITION AND CONSERVATION	
TOTAL ACREAGE WITHIN THE RIVERLIGHTS BOUNDARY	1,329.41 ACRES (57,909,100 SF)	
TOTAL ACREAGE WITHIN THE MARINA VILLAGE BOUNDARY	38.67 ACRES (1,684,343 SF)	
TOTAL ACREAGE OF COASTAL WETLANDS	14.57 ACRES (634,715 SF)	
TOTAL PROJECT AREA (STORMWATER PROJECT AREA)	24.10 ACRES (1,049,628 SF)	
TOTAL ACREAGE OF NON-COASTAL WETLANDS (ISOLATED/404)	76,797 SF (1.76 ACRES)	
TOTAL ACREAGE WITHIN THE MARINA VILLAGE – PHASE 1B	9.84 ACRES (428,668 SF)	
BUILDING SETBACKS AND SEPARATIONS (MX ZONING)	REQUIRED	PROPOSED
FRONT	N/A	N/A
REAR	N/A	N/A
SIDE (INTERIOR)	N/A	N/A
SIDE (CORNER)	N/A	N/A
TOTAL BUILDING(S) SIZE (SQUARE FOOTAGE)	68,000 SF	
NC BUILDING CODE CONSTRUCTION TYPE	VB	
BUILDING LOT COVERAGE	16%	
NUMBER OF BUILDINGS	38 DUPLEX TOWNHOUSE	
TOTAL AMOUNT OF DISTURBED AREA	5.24 AC (228,450 SF)	
TOTAL ACRES WITHIN 100-YR FLOODPLAIN/BELOW MHW MARK	0.01 ACRES (513 SF)	
TOTAL ACRES WITHIN WETLANDS (DWQ PROJECT #07-1335)	N/A	
IMPERVIOUS AREA (EXISTING – PHASE 1)		
ROOF TOPS	52,249	SF
ROADWAYS	92,792	SF
PARKING	0	SF
SIDEWALKS	35,408	SF
OTHER	0	SF
TOTAL PRE DEVELOPMENT/%	180,449/17.2	SF/%
IMPERVIOUS AREA (PROPOSED)		
ROOF TOPS	71,516	SF
ROADWAYS	51,562	SF
PARKING	43,575	SF
PERVIOUS PARKING	0	SF
PERVIOUS PARKING (75% REDUCTION)	0	SF
SIDEWALKS	22,078	SF
PERVIOUS SIDEWALK	0	SF
PERVIOUS SIDEWALK (75% REDUCTION)	0	SF
FUTURE ALLOTMENT	0	SF
OTHER	0	SF
TOTAL S.F. (ONSITE IMPERVIOUS AREA)	188,731	SF
PERCENTAGE (ONSITE IMPERVIOUS AREA/ONSITE AREA)	18.0	%
PERCENTAGE (EXIST. ONSITE IMPERVIOUS AREA/ONSITE AREA)	17.2	%
TOTAL SQUARE FOOTAGE OF IMPERVIOUS SURFACES SHOWN IN THE STREET YARD	0	SF

PARKING CALCULATIONS	
MINIMUM NUMBER OF SPACES REQUIRED	N/A
MAXIMUM NUMBER OF SPACES ALLOWED	494
(48) TOWNHOMES (2.5 SPACES/UNIT)	120
(24) APARTMENTS (2.5 SPACES/UNIT)	60
(10) SINGLE FAMILY (2.5 SPACES/UNIT)	25
RESTAURANTS (1 SPACE / 65 SF GFA)	151
ART GALLERY (1 SPACE / 250 SF GFA)	31
RIVER HOUSE (1 SPACE / 65 SF GFA)	31
RETAIL (1 SPACE / 200 SF GFA)	20
MARINA (1 SPACE / 2 WET SLIPS)	56
PARKING SPACES PROVIDED (PHASE 1B)	172
PARKING SPACES PROVIDED (PHASE 1)	180
PARKING SPACES PROVIDED (TOTAL)	352
COMPACT CAR PARKING SPACES	30
BICYCLE PARKING SPACES REQUIRED	20
BICYCLE PARKING SPACES PROVIDED	20
HANDICAP SPACES REQUIRED	9
HANDICAP SPACES PROVIDED	10

PARKING NOTE:
- ALL BICYCLE PARKING IS PROVIDED IN PHASE 1.

KEYNOTES:

46'x46' STREET CORNER SIGHT DISTANCE TRIANGLE

20'x70' DRIVEWAY SIGHT DISTANCE TRIANGLE

SURFACE MATERIAL LEGEND

- ASPHALT – STREET SECTION
- ASPHALT – DRIVE AISLE
- GRAVEL – PARKING LOT
- PERVIOUS CONCRETE
- ROOFTOP
- SIDEWALK
- COMMON SPACE
- OPEN SPACE

NOTE:
ALL PROPOSED VEGETATION WITHIN SIGHT TRIANGLES SHALL NOT INTERFERE WITH CLEAR VISUAL SIGHT LINES FROM 30" – 10'

WATER & SEWER DEMAND	
WATER DEMAND	17,280 GDP
SANITARY SEWER DEMAND	17,280 GDP

TOTAL ACREAGE OF MARINA VILLAGE – PHASE 1B WITHIN COD: 2.06 ACRES (89,951 SF)

TOTAL ACREAGE OF MARINA VILLAGE – PHASE 1B ENCROACHMENT INTO THE COD: 0 ACRES (0 SF)

COMMON SPACE CALCULATIONS	
TOTAL COMMON SPACE REQUIRED	18.47 ACRES (804,640 SF)*
TOTAL COMMON SPACE PROPOSED	0.08 ACRES (3,634 SF)

OPEN SPACE CALCULATIONS*	
TOTAL OPEN SPACE REQUIRED	46.18 ACRES (2,011,601 SF)*
TOTAL OPEN SPACE PROPOSED	2.82 ACRES (122,991 SF)

*PROPOSED MX-CD CLUSTER FOR ENTIRE RIVER LIGHTS DEVELOPMENT = 184.7 ACRES
OPEN SPACE AND COMMON SPACE ACRES REQUIRED FOR ENTIRE RIVERLIGHTS DEVELOPMENT @ 25% OPEN SPACE AND 10% COMMON SPACE = 46.18 AC (OPEN) AND 18.47 AC (COMMON)

Approved Construction Plan

	Name	Date
Planning		12/15/16
Traffic		12-13-16
Fire		12/16/16

CITY OF WILMINGTON NORTH CAROLINA
Public Services • Engineering Division
APPROVED STORMWATER MANAGEMENT PLAN
Date: 12/15/16 Permit # 20150219.02
Signed:

For each open utility cut of City streets, a $325 permit shall be required from the City prior to occupancy and/or project acceptance.

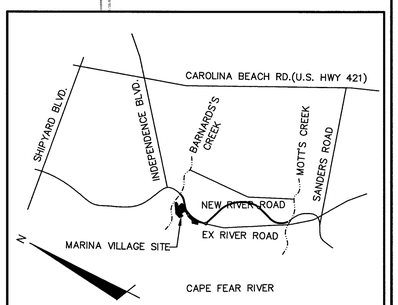

VICINITY MAP
NOT TO SCALE

REV.NO.	DESCRIPTIONS	DATE
	REVISIONS	
6	CITY OF WILMINGTON TRAFFIC COMMENTS	11/29/2016
5	UTILITY REVISION BASED ON PHASE 1 AS-BUILT CONDITIONS	10/04/2016
4	CITY OF WILMINGTON ENGINEERING COMMENTS	09/21/2016
3	CITY OF WILMINGTON TRC COMMENTS	08/23/2016
2	SITE PLAN AND STORM DRAINAGE REVISIONS	07/19/2016
1	CFPUA COMMENTS	04/11/2016
0	ISSUED FOR CONSTRUCTION	03/17/2016

SEAL

SEAL
NORTH CAROLINA PROFESSIONAL ENGINEER SEAL 035107 NICHOLAS J. LAURETTA
11/29/16

McKIM&CREED
243 North Front Street
CITY OF WILMINGTON TRAFFIC COMMENTS
Phone: (910)343-1048, Fax: (910)251-8282
License: F-1222
www.mckimcreed.com

NORTH AMERICA SEKISUI HOUSE, LLC

RIVERLIGHTS™

RIVERLIGHTS MARINA VILLAGE PHASE 1B

SITE PLAN

DATE:	17MAR16
MCE PROJ. #	2735-0124
DRAWN	ALM
DESIGNED	NJL
CHECKED	KOBE
PROJ. MGR.	NJL

SCALE
HORIZONTAL: 1"=60'
VERTICAL: N/A

M&C FILE NUMBER CS-101
DRAWING NUMBER 12

STATUS: FINAL DESIGN
ISSUED FOR CONSTRUCTION
REVISION 3

CITY OF WILMINGTON NOTES:

1. ALL PARKING STALL MARKINGS AND LANE ARROWS WITHIN THE PARKING AREAS SHALL BE WHITE.
2. ALL TRAFFIC CONTROL SIGNS AND MARKINGS OFF THE RIGHT-OF-WAY ARE TO BE MAINTAINED BY THE PROPERTY OWNER IN ACCORDANCE WITH MUTCD STANDARDS.
3. A UTILITY CUT PERMIT IS REQUIRED FOR EACH OPEN CUT OF A CITY STREET. CONTACT 341-5888 FOR MORE DETAILS. IN CERTAIN CASES AN ENTIRE RESURFACING OF THE AREA BEING OPEN CUT MAY BE REQUIRED.
4. A LANDSCAPING PLAN INDICATING THE LOCATION OF REQUIRED STREET TREES SHALL BE SUBMITTED TO THE CITY OF WILMINGTON TRAFFIC ENGINEERING DIVISION AND PARKS AND RECREATION DEPARTMENT FOR REVIEW AND APPROVAL PRIOR TO THE RECORDING OF THE FINAL PLAT.
5. ZERO LOT LINES ARE PERMITTED.
6. BUILDINGS LOCATED ON THE PERIPHERY OF THE MX DISTRICT SHALL BE SET BACK A MINIMUM OF 20 (TWENTY) FEET FROM THE MX DISTRICT BOUNDARY.
7. ZONING AND LAND USE OF ADJACENT PROPERTIES IS AS FOLLOWS:
   - NORTH - FUTURE MX-CD / TRANSITION
   - SOUTH - FUTURE MX-CD / TRANSITION AND CONSERVATION AREA
   - WEST - FUTURE MX-CD / TRANSITION
   - EAST - I-2 / TRANSITION AND CONSERVATION AREA
8. INSTALL REFLECTORS PER CITY AND NCDOT STANDARDS. TRAFFIC ENGINEERING MUST APPROVE OF PAVEMENT MARKING LAYOUT PRIOR TO ACTUAL STRIPING.
9. IT SHALL BE THE RESPONSIBILITY OF THE SUBDIVIDER TO ERECT OFFICIAL STREET NAME SIGNS AT ALL INTERSECTIONS ASSOCIATED WITH THE SUBDIVISION IN ACCORDANCE WITH THE TECHNICAL STANDARDS AND SPECIFICATION MANUAL. THE SUBDIVIDER MAY ACQUIRE AND ERECT OFFICIAL STREET NAME SIGNS OR CHOOSE TO CONTRACT WITH THE CITY TO INSTALL THE STREET SIGNS AND THE SUBDIVIDER SHALL PAY THE COSTS OF SUCH INSTALLATION. CONTACT TRAFFIC ENGINEERING AT 341-7888 TO DISCUSS INSTALLATION OF TRAFFIC AND STREET NAME SIGNS. PROPOSED STREET NAMES MUST BE APPROVED PRIOR TO INSTALLATION OF STREET NAME SIGNS.
10. CONTACT TRAFFIC ENGINEERING AT 341-7888 FORTY-EIGHT HOURS PRIOR TO ANY EXCAVATION IN THE RIGHT OF WAY.
11. IF THESE UNITS ARE SOLD AT ANY POINT, THE BUYER MUST RECEIVE A SUBDIVISION STREET DISCLOSURE STATEMENT.

GENERAL NOTES:

1. FLOODPLAIN INFORMATION WAS OBTAINED FROM NC FLOODPLAIN MAPPING FLOOD RISK INFORMATION SYSTEM PROGRAM. RIVERLIGHTS IS LOCATED WITHIN FIRM MAP 3720312400K, PANEL 3124 AS REVISED JUNE 02, 2006.
2. ITEMS DESIGNATED AS "PROPOSED" ARE PART OF THE RIVER ROAD REALIGNMENT PROJECT THAT IS CURRENTLY UNDER CONSTRUCTION. RIVER ROAD CONSTRUCTION TO BE COMPLETE SPRING 2016.
3. WETLANDS SHOWN IN THIS PORTION OF RIVERLIGHTS WERE DESCRIBED AS BRACKISH/SALT MARSH AND POCOSIN WETLANDS AND CONSERVATION RESOURCE SETBACK LINES WERE GENERATED AS 100' AND 25', RESPECTIVELY, MINIMUM OUTSIDE OF THE RESOURCE.
4. FINISHED FLOOR ELEVATIONS OFF ALL INHABITABLE STRUCTURES WILL BE MIN. 2-FEET ABOVE BASE FLOOD ELEVATION
5. RIVERLIGHTS PHASE 1 MARINA VILLAGE COMMUNITY DOES NOT CONTAIN ANY LOCAL, STATE, OR FEDERALLY RECOGNIZED HISTORIC STRUCTURES OR ARCHEOLOGICAL SITES ON SITE. RIVERLIGHTS WAS ISSUED A NOTICE OF NO FURTHER ACTION LETTER DATED JUNE 2, 2008 FOLLOWING COMPLETION OF AN EA/SEPA DOCUMENT.
6. EXISTING THOROUGHFARES, BIKE ROUTES, PEDESTRIAN SIDEWALKS OR TRAILS AND TRANSITS FACILITIES DO EXIST ON THE ADJACENT MARINA VILLAGE PHASE 1 SITE.

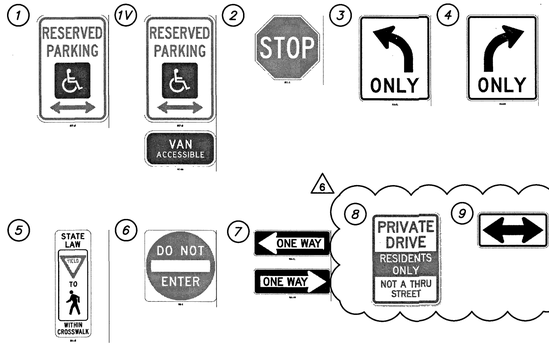

For each open utility cut of City streets, a $325 permit shall be required from the City prior to occupancy and/or project acceptance.

1 inch

Approved Construction Plan

	Name	Date
Planning		12/17/16
Traffic		12-13-16
Fire		12.16.16

CITY OF WILMINGTON NORTH CAROLINA
Public Services • Engineering Division
APPROVED STORMWATER MANAGEMENT PLAN
Date: 12/15/16 Permit # 20150211122
Signed:

SCALE: 1"=30' (Horiz.)

REV.NO.	DESCRIPTIONS	DATE
	REVISIONS	
6	CITY OF WILMINGTON TRAFFIC COMMENTS	11/29/2016
5	UTILITY REVISION BASED ON PHASE 1 AS-BUILT CONDITIONS	10/04/2016
4	CITY OF WILMINGTON ENGINEERING COMMENTS	09/21/2016
3	CITY OF WILMINGTON TRC COMMENTS	08/23/2016
2	SITE PLAN AND STORM DRAINAGE REVISIONS	07/19/2016
1	CPPUA COMMENTS	04/11/2016
0	ISSUED FOR CONSTRUCTION	03/17/2016

SEAL

SEAL
NORTH CAROLINA PROFESSIONAL ENGINEER NICHOLAS J. LAURITTA 035107
11/29/16

McKIM&CREED
243 North Front Street
CITY OF WILMINGTON TRAFFIC COMMENTS
Phone: (910)343-1048, Fax: (910)251-8282
License: F-1222
www.mckimcreed.com

NORTH AMERICA SEKISUI HOUSE, LLC
RIVERLIGHTS™

RIVERLIGHTS MARINA VILLAGE PHASE 1B

SITE PLAN NORTH

DATE:	17MAR16
MCE PROJ. #	2735-0124
DRAWN	ALM
DESIGNED	NJL
CHECKED	KCBE
PROJ. MGR.	NJL

SCALE: HORIZONTAL: 1"=30' VERTICAL: N/A

M&C FILE NUMBER: CS-102
DRAWING NUMBER: 13

STATUS: FINAL DESIGN
ISSUED FOR CONSTRUCTION
REVISION: 6

For each open utility cut of City streets, a $325 permit shall be required from the City prior to occupancy and/or project acceptance.

1 inch

Approved Construction Plan

	Name	Date
Planning		12/13/16
Traffic		12-13-16
Fire		12.16.16

CITY OF WILMINGTON NORTH CAROLINA
Public Services • Engineering Division
APPROVED STORMWATER MANAGEMENT PLAN
Date: 20150212 22 12/15/16 Permit #_____
Signed:

VILLAGE GREEN DRIVE
(63'-6" PRIVATE R/W)

ARCADIA FLOW
(63'-6" PRIVATE R/W)

WATERCRAFT FERRY AVENUE
(52'-0" PRIVATE R/W)

PERMIT DRIVE

DUKE PROGRESS ACCESS EASEMENT

DUKE PROGRESS TRANSMISSION EASEMENT

PIEDMONT NATURAL GAS EASEMENT

ASPHALT FLUSH WITH EVENT LAWN

6" VERTICAL CURB (TYP.)

20' REINFORCED SIDEWALK MARKED "HEAVY VEHICLE CROSSING"

20' SECTION OF SLOPE CURB FOR DUKE VEHICLE EASEMENT ACCESS

TRANSITION TO SLOPE CURB (TYP.)

1 RESERVED PARKING

1V RESERVED PARKING / VAN ACCESSIBLE

2 STOP

3 ONLY

4 ONLY

5 STATE LAW YIELD TO PEDESTRIAN WITHIN CROSSWALK

6 DO NOT ENTER

7 ONE WAY / ONE WAY

N

30' 0 30' 60'

SCALE: 1"=30' (Horiz.)

REV.NO.	DESCRIPTIONS REVISIONS	DATE
6	CITY OF WILMINGTON TRAFFIC COMMENTS	11/29/2016
5	UTILITY REVISON BASED ON PHASE 1 AS-BUILT CONDITIONS	10/04/2016
4	CITY OF WILMINGTON ENGINEERING COMMENTS	09/21/2016
3	CITY OF WILMINGTON TRC COMMENTS	08/23/2016
2	SITE PLAN AND STORM DRAINAGE REVISIONS	07/19/2016
1	CFPUA COMMENTS	04/11/2016
0	ISSUED FOR CONSTRUCTION	03/17/2016

SEAL

SEAL
NORTH CAROLINA PROFESSIONAL CIVIL 035107 ENGINEER NICHOLAS J. LAURETA
11/29/16

McKIM&CREED
243 North Front Street
CITY OF WILMINGTON TRAFFIC COMMENTS
Phone: (910)343-1048, Fax: (910)251-8282
License: F-1222
www.mckimcreed.com

NORTH AMERICA SEKISUI HOUSE, LLC

RIVERLIGHTS™

RIVERLIGHTS MARINA VILLAGE PHASE 1B

SITE PLAN SOUTH

DATE:	17MAR16
MCE PROJ. #	2735-0124
DRAWN	ALM
DESIGNED	NJL
CHECKED	KCBE
PROJ. MGR.	NJL

SCALE: HORIZONTAL: 1"=30' VERTICAL: N/A

M&C FILE NUMBER: CS-103
DRAWING NUMBER: 14

STATUS: FINAL DESIGN
ISSUED FOR CONSTRUCTION
REVISION 0

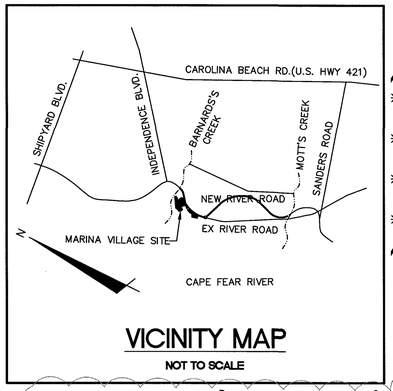

VICINITY MAP

NOT TO SCALE

For each open utility cut of City streets, a $325 permit shall be required from the City prior to occupancy and/or project acceptance.

1 inch

Approved Construction Plan

	Name	Date
Planning		12/13/16
Traffic		12-13-16
Fire		12.16.16

CITY OF WILMINGTON NORTH CAROLINA
Public Services • Engineering Division
APPROVED STORMWATER MANAGEMENT PLAN
Date: 12/15/16 Permit # 20150719Z
Signed:

FIRE HYDRANT ASSEMBLY (TYP.)
6"x6" MJ TEE 6" DIP
(2) 6" MJ 45° EL.
6" GV
MH #MV-25 8" PVC INV OUT = 9.30' RIM = 12.65'
8" PUBLIC GRAVITY SEWER (TYP.)
2" SDR21 PVC WATER MAIN
6"x2" RED.
TOWNHOUSE
REMOVE 2" BLOWOFF INSTALL 8"x6" RED.
EX. FIRE HYDRANT ASSEMBLY
EX. 8" C900 PVC DR18 WATER MAIN (TYP.)
EX. 12" C900 PVC DR18 WATER MAIN (CFPUA)
EX. 10-FT NON-MUNICPAL EASEMENT
EX. PUBLIC DRAINAGE EASEMENT
DUKE PROGRESS ACCESS EASEMENT
DUKE PROGRESS TRANSMISSION EASEMENT
PIEDMONT NATURAL GAS EASEMENT
(5) SHALLOW SERVICES TRANSITION TO 401 PROTECTO LINED DIP OVER CROSSING INCLUDING TOP 45° ELBOW AND TRANSITION FITTING. TRANSITION TO SCH. 40 PVC 1 FT BEFORE COMBINATION.
(2) 1" PE WATER LATERAL
VARIABLE WIDTH UTILITY EASEMENT (MIN. 10')
(2) SIMPLEX GRINDER PUMP STATIONS
(2)2" GV
10' MIN.
(2) 2" 45° EL.
6"x2" RED.
MH #MV-24 8" PVC INV IN = 8.02' 8" PVC INV OUT = 7.97' RIM = 11.38'
SS CLEANOUT (TYP.)
FIRE HYDRANT ASSEMBLY (TYP.)
6"x6" MJ TEE 6" DIP
TYPICAL RES. UTILITY SERVICE 1" PE WATER LATERAL 4" PVC SCH. 40 LATERAL @ 1% MIN. GRADE
SS CLEANOUT (TYP.)
5/8" WATER METER (TYP.)
MH #MV-23 8" PVC INV IN = 7.45' 8" PVC INV OUT = 7.43' RIM = 12.18'
MH #MV-22 8" PVC INV IN = 6.99' 8" PVC INV OUT = 6.99' RIM = 12.80'
(2) 45° BEND EACH SIDE
REMOVE 2" BLOWOFF INSTALL 8"x6" RED.
CONNECT TO EX. PIPE STUB INSTALLED DURING PHASE 1
EX. MH #MV-21 8" PVC INV IN = 6.44' 8" PVC INV IN = 6.39' 8" PVC INV OUT = 6.39' RIM = 13.19'
REMOVE 2" BLOWOFF ASSEMBLY
EX. 8" PUBLIC GRAVITY SEWER (TYP.)
35' VEGETATED BUFFER
CITY OF WILMINGTON CONSERVATION OVERLAY DISTRICT (COD)
100-YR FLOODPLAIN (AE 9 - PRELIMINARY)
100-YR FLOODPLAIN (AE 9 - EFFECTIVE)
MEAN HIGH WATER (APPROX. EL. 2)
COASTAL MARSH LINE
DOCK TO 112-SLIP OPEN WATER COMMUNITY BOATING FACILITY (CAMA PERMIT NO. 92-07)
CRABBING PIER WITH GAZEBO (CAMA PERMIT NO. 92-07)
MATCHLINE - SEE THIS SHEET

△5
- REVISED 6" WATER MAIN ALONG WATERCRAFT FERRY TO CONNECT AT AS-BUILT LOCATION
- REVISED SANITARY SEWER MH INVERTS TO MATCH AS-BUILT CONDITION

△1
- PLACED WATER METERS 5' FROM PROPERTY CORNER
- PLACED CLEANOUTS IN CENTER OF LOT
- ROTATED FIRE HYDRANTS TOWARDS PROPERTY LINE
- REMOVED HORIZONTAL OFFSET ON 2" MAIN ALONG VILLAGE GREEN DRIVE

△2
- CONVERTED 2 SINGLE FAMILY LOTS TO 5 TOWNHOME LOTS
- REMOVED 1 TOWNHOME LOT ON HOBIE RUN

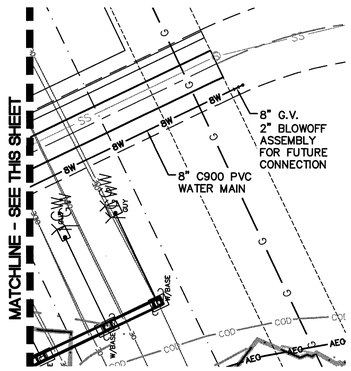

CFPUA STANDARD SEWER NOTES:

1. SEWER GUARDS REQUIRED AT ALL MANHOLES. STAINLESS STEEL SEWER GUARDS REQUIRED AT MANHOLES LOCATED IN TRAFFIC AREAS.
2. WATER AND SEWER SERVICES SHALL BE PERPENDICULAR TO MAIN AND TERMINATE AT RIGHT-OF-WAY LINE. SERVICES IN CUL-DE-SACS ARE REQUIRED TO BE PERPENDICULAR, OR MUST ORIGINATE IN END OF LINE MANHOLE AND TERMINATE AT RIGHT-OF-WAY LINE.
3. ALL SERVICES TYING INTO DUCTILE IRON MAINS SHALL BE CONSTRUCTED OF CLASS 50, DIP, WITH PROTECTO 401 CERAMIC EPOXY LINING.
4. NO FLEXIBLE COUPLINGS SHALL BE USED.
5. ALL STAINLESS STEEL FASTENERS SHALL BE 316.
6. CLEANOUTS SHALL BE LOCATED A MINIMUM OF 12 FEET FROM ALL PROPERTY CORNERS. WATER METER BOXES ARE TO BE A MINIMUM OF 5 FEET FROM THE PROPERTY CORNER.

N

50' 0 50' 100'

SCALE: 1"=50' (Horiz.)

REV.NO.	DESCRIPTIONS	DATE
5	UTILITY REVISION BASED ON PHASE 1 AS-BUILT CONDITIONS	10/04/2016
4	CITY OF WILMINGTON ENGINEERING COMMENTS	09/21/2016
3	CITY OF WILMINGTON TRC COMMENTS	08/23/2016
2	SITE PLAN AND STORM DRAINAGE REVISIONS	07/19/2016
1	CFPUA COMMENTS	04/11/2016
0	ISSUED FOR CONSTRUCTION	03/17/2016

REVISIONS

SEAL

SEAL
NORTH CAROLINA PROFESSIONAL ENGINEER SEAL 035107 NICHOLAS J. LAURETTA CIVIL
10/4/16

McKIM&CREED
243 North Front Street
Wilmington, North Carolina 28401
Phone: (910)343-1048, Fax: (910)251-8282
License: F-1222
www.mckimcreed.com

NORTH AMERICA SEKISUI HOUSE, LLC
RIVERLIGHTS™

RIVERLIGHTS MARINA VILLAGE PHASE 1B

UTILITY PLAN

DATE:	17MAR16
MCE PROJ. #	2735-0124
DRAWN	ALM
DESIGNED	NJL
CHECKED	KCBE
PROJ. MGR.	NJL

SCALE: HORIZONTAL: 1"=50' VERTICAL: N/A

M&C FILE NUMBER CU-101

DRAWING NUMBER 15

STATUS: FINAL DESIGN
ISSUED FOR CONSTRUCTION

REVISION 5

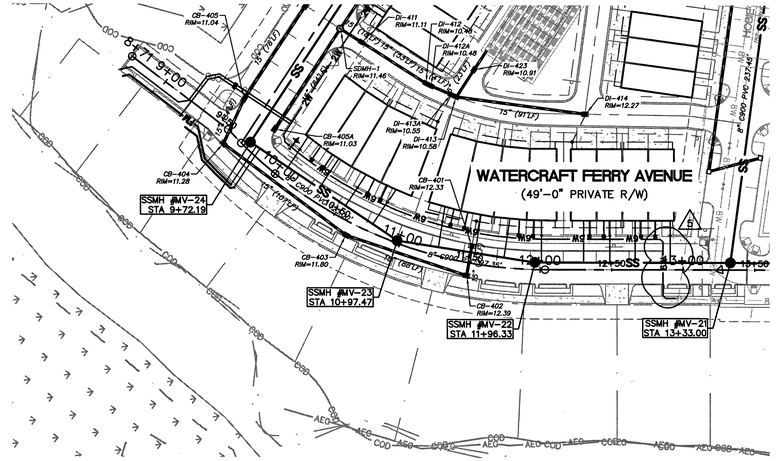
WATERCRAFT FERRY AVENUE
(49'-0" PRIVATE R/W)
SSMH #MV-24
STA 9+72.19
SSMH #MV-23
STA 10+97.47
SSMH #MV-22
STA 11+96.33
SSMH #MV-21
STA 13+33.00
8" C900 PVC 237.46'
15" (391LF)
24" (444LF)
8" C900 PVC 133.00'

CFPUA STANDARD SEWER NOTES:

1. SEWER GUARDS REQUIRED AT ALL MANHOLES. STAINLESS STEEL SEWER GUARDS REQUIRED AT MANHOLES LOCATED IN TRAFFIC AREAS.
2. WATER AND SEWER SERVICES SHALL BE PERPENDICULAR TO MAIN AND TERMINATE AT RIGHT-OF-WAY LINE. SERVICES IN CUL-DE-SACS ARE REQUIRED TO BE PERPENDICULAR, OR MUST ORIGINATE IN END OF LINE MANHOLE AND TERMINATE AT RIGHT-OF-WAY LINE.
3. ALL SERVICES TYING INTO DUCTILE IRON MAINS SHALL BE CONSTRUCTED OF CLASS 50, DIP, WITH PROTECTO 401 CERAMIC EPOXY LINING.
4. NO FLEXIBLE COUPLINGS SHALL BE USED.
5. ALL STAINLESS STEEL FASTENERS SHALL BE 316.
6. CLEANOUTS SHALL BE LOCATED A MINIMUM OF 12 FEET FROM ALL PROPERTY CORNERS. WATER METER BOXES ARE TO BE A MINIMUM OF 5 FEET FROM THE PROPERTY CORNER.

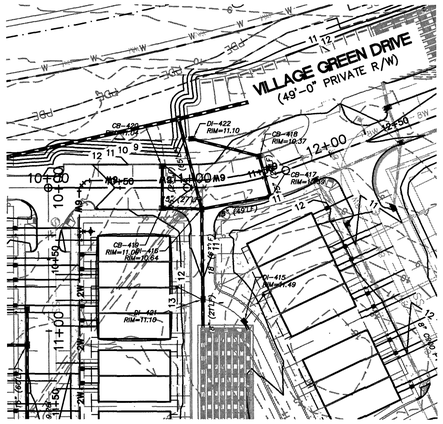

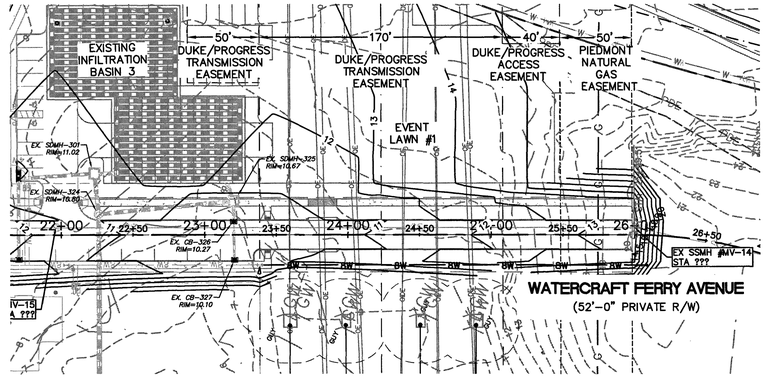

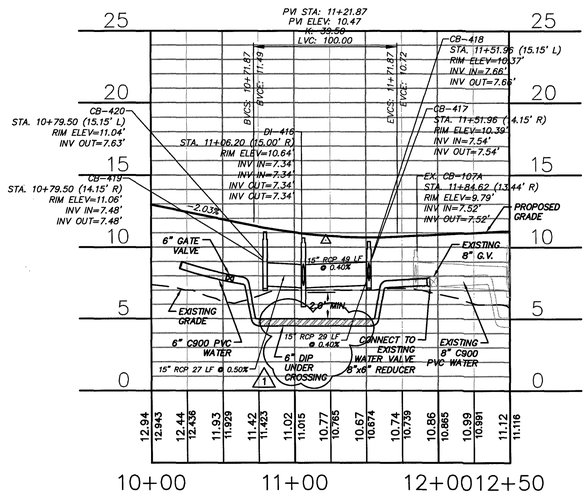

VILLAGE GREEN DRIVE

SCALE: HOR. 1"=50', VERT. 1"=5'

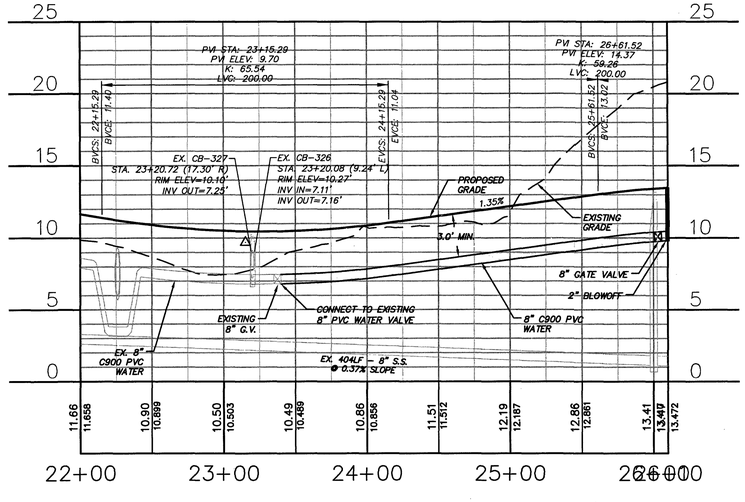

WATERCRAFT FERRY AVENUE

SCALE: HOR. 1"=50', VERT. 1"=5'

For each open utility cut of City streets, a $325 permit shall be required from the City prior to occupancy and/or project acceptance.

1 inch

CITY OF WILMINGTON NORTH CAROLINA
Public Services Engineering Division
APPROVED STORMWATER MANAGEMENT PLAN
Date: 12/15/16 Permit # 20150721R2
Signed:

Approved Construction Plan

	Name	Date
Planning		12/13/16
Traffic		12-13-16
Fire		12-16-16

N

50' 0 50' 100'
SCALE: 1"=50' (Horiz.)

REV.NO.	DESCRIPTIONS	DATE
4	CITY OF WILMINGTON ENGINEERING COMMENTS	09/21/2016
3	CITY OF WILMINGTON TRC COMMENTS	08/23/2016
2	SITE PLAN AND STORM DRAINAGE REVISIONS	07/19/2016
1	CFPUA COMMENTS	06/17/2016
0	ISSUED FOR CONSTRUCTION	03/17/2016

REVISIONS

SEAL

SEAL
09/21/16

McKIM&CREED
243 North Front Street
Wilmington, North Carolina 28401
Phone: (910)343-1048, Fax: (910)251-8282
License: F-1222
www.mckimcreed.com

NORTH AMERICA SEKISUI HOUSE, LLC
RIVERLIGHTS™

RIVERLIGHTS MARINA VILLAGE PHASE 1B

PLAN AND PROFILE

DATE:	17MAR16
MCE PROJ. #	2735-0124
DRAWN	ALM
DESIGNED	NJL
CHECKED	KCBE
PROJ. MGR.	NJL

SCALE
HORIZONTAL: 1"=50'
VERTICAL: 1"=5'

MAC FILE NUMBER CU-702
DRAWING NUMBER 17

STATUS: FINAL DESIGN
ISSUED FOR CONSTRUCTION
REVISION 0

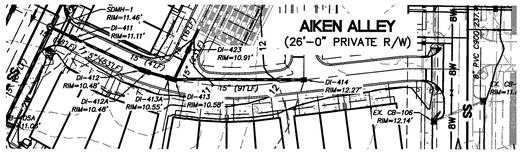

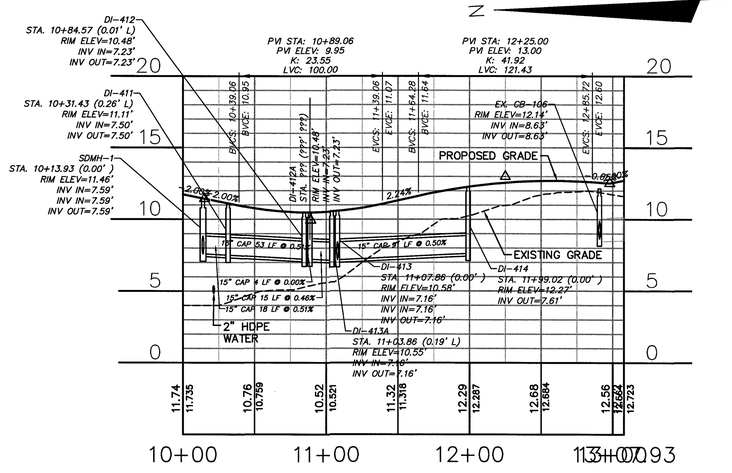

AIKEN ALLEY

HOR. 1"=50', VERT. 1"=5'

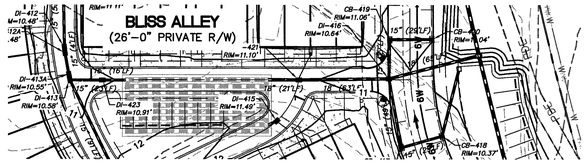

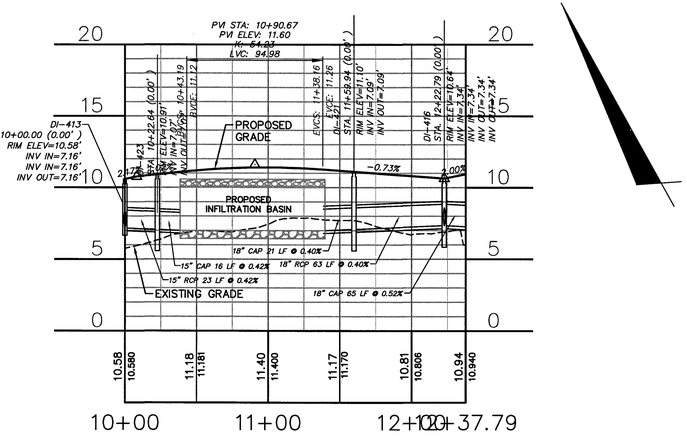

BLISS ALLEY

HOR. 1"=50', VERT. 1"=5'

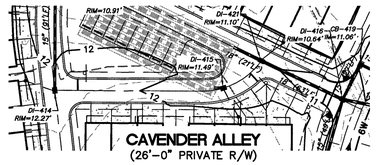

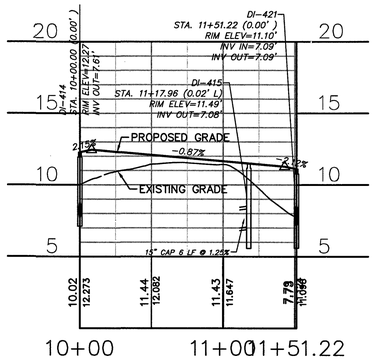

CAVENDER ALLEY

HOR. 1"=50', VERT. 1"=5'

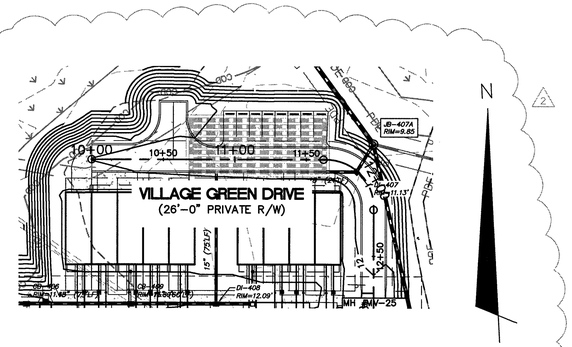

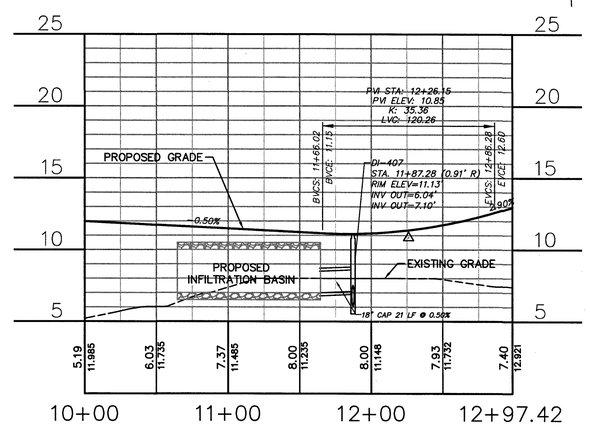

VILLAGE GREEN DRIVE

HOR. 1"=50', VERT. 1"=5'

50' 0 50' 100'

SCALE: 1"=50' (Horiz.)

For each open utility cut of City streets, a $325 permit shall be required from the City prior to occupancy and/or project acceptance.

1 inch

Approved Construction Plan

	Name	Date
Planning		12/19/16
Traffic		12-13-16
Fire		12/6/16

CITY OF WILMINGTON NORTH CAROLINA
Public Services Engineering Division
APPROVED STORMWATER MANAGEMENT PLAN
Date: Exp 12/15/16 Permit # 20150218Z
Signed:

CFPUA STANDARD SEWER NOTES:

1. SEWER GUARDS REQUIRED AT ALL MANHOLES. STAINLESS STEEL SEWER GUARDS REQUIRED AT MANHOLES LOCATED IN TRAFFIC AREAS.
2. WATER AND SEWER SERVICES SHALL BE PERPENDICULAR TO MAIN AND TERMINATE AT RIGHT-OF-WAY LINE. SERVICES IN CUL-DE-SACS ARE REQUIRED TO BE PERPENDICULAR, OR MUST ORIGINATE IN END OF LINE MANHOLE AND TERMINATE AT RIGHT-OF-WAY LINE.
3. ALL SERVICES TYING INTO DUCTILE IRON MAINS SHALL BE CONSTRUCTED OF CLASS 50, DIP, WITH PROTECTO 401 CERAMIC EPOXY LINING.
4. NO FLEXIBLE COUPLINGS SHALL BE USED.
5. ALL STAINLESS STEEL FASTENERS SHALL BE 316.
6. CLEANOUTS SHALL BE LOCATED A MINIMUM OF 12 FEET FROM ALL PROPERTY CORNERS. WATER METER BOXES ARE TO BE A MINIMUM OF 5 FEET FROM THE PROPERTY CORNER.

REV.NO.	DESCRIPTIONS	DATE
	REVISIONS	
4	CITY OF WILMINGTON ENGINEERING COMMENTS	09/21/2016
3	CITY OF WILMINGTON TRC COMMENTS	08/23/2016
2	SITE PLAN AND STORM DRAINAGE REVISIONS	07/19/2016
1	CFPUA COMMENTS	06/17/2016
0	ISSUED FOR CONSTRUCTION	03/17/2016

SEAL

SEAL
NORTH CAROLINA PROFESSIONAL CIVIL 035107 ENGINEER NICHOLAS J. LAURETTA
05/21/16

McKIM & CREED
243 North Front Street
Wilmington, North Carolina 28401
Phone: (910)343-1048, Fax: (910)251-8282
License: F-1222
www.mckimcreed.com

NORTH AMERICA SEKISUI HOUSE, LLC

RIVERLIGHTS™

RIVERLIGHTS MARINA VILLAGE PHASE 1B

PLAN AND PROFILE

DATE:	17MAR16
MCE PROJ. #	2735-0124
DRAWN	ALM
DESIGNED	NJL
CHECKED	KCBE
PROJ. MGR.	NJL

SCALE
HORIZONTAL: 1"=50'
VERTICAL: 1"=5'

M&C FILE NUMBER CU-703
DRAWING NUMBER 18

STATUS: FINAL DESIGN
ISSUED FOR CONSTRUCTION
REVISION 2

PLANTING NOTES

1. EXISTING UTILITIES SHOWN ARE APPROXIMATE AND SHALL BE VERIFIED IN THE FIELD PRIOR TO BEGINNING WORK. CONTRACTOR SHALL CONTACT THE CITY OF WILMINGTON FOR LOCATION OF EXISTING UTILITIES PRIOR TO BEGINNING CONSTRUCTION. THE CONTRACTOR SHALL EXERCISE CAUTION WHEN WORKING AROUND EXISTING UTILITIES TO REMAIN.
2. PLANT LIST IS PROVIDED FOR CONVENIENCE ONLY. IN THE CASE OF DISCREPANCIES BETWEEN THE PLAN AND PLANT LIST QUANTITIES, THE PLAN SHALL TAKE PRECEDENCE.
3. AFTER THE SITE IS STABILIZED AND FREE OF SEDIMENTATION, THE CONTRACTOR SHALL REMOVE ALL TEMPORARY EROSION CONTROL DEVICES, SILT, RIP RAP AND TEMPORARY STONE STAGING AREAS FOR REPLACEMENT WITH PLANTING SOIL. PROVIDE PLANTING ACCORDING TO THE LANDSCAPE PLAN.
4. TEMPORARY EROSION CONTROL SEED MUST BE FULLY REMOVED PRIOR TO PREPARATION OF PERMANENT SEED, SOD OR LANDSCAPE BEDS.
5. UNLESS OTHERWISE NOTED IN THE PLANT LIST, THE CONTRACTOR SHALL OBTAIN AND INSTALL ONLY PLANT MATERIAL THAT IS GROWN ON ITS OWN ROOT - GRAFTED OR BUDDED PLANT MATERIAL WILL BE REJECTED.
6. ALL TREES SHALL BE OBTAINED FROM THE NURSERY WITH EXPOSED ROOT CROWNS. B&B MATERIAL DELIVERED TO SITE WITH BURIED OR RECENTLY BURIED ROOT CROWNS WILL BE REJECTED.
7. CONTRACTOR SHALL NOTIFY LANDSCAPE ARCHITECT OF PLANT SUBSTITUTIONS IN ANY MEASUREMENT OR SPECIES INDICATED.
8. DO NOT PLANT IN STORM WATER CONVEYANCE SWALES OR PROVIDE FINE GRADING THAT DISRUPTS FLOW OR CHANGES LONGITUDINAL SLOPES.
9. PLANT THE OUTER EDGES OF EACH PLANTING GROUP FOLLOWING THE BED OUTLINE ACCORDING TO THE PLAN. ONCE A SATISFACTORY MATCHED OUTER SHAPE IS OBTAINED, FILL THE CENTER OF EACH AREA WITH PLANTS ACCORDING TO THE PLAN AND SPACING NOTES.
10. THE PLANTING LAYOUT WITHIN PLANTING BEDS SHOULD BE SHIFTED TO MINIMIZE CONFLICTS WITH EXISTING TREE ROOTS.
11. THE CONTRACTOR SHALL SOD ALL DISTURBED AREAS INCLUDING CONSTRUCTION ACCESS OUTSIDE PROJECT LIMITS.
12. DRAWING L-160 IS SHOWN TO EXHIBIT THE OVERALL SCOPE OF THE MARINA VILLAGE PHASE 1B PLAN; REFER TO SHEET L-161 AND L-162 FOR ALL PLANTING INFORMATION.
13. ANY VEGETATION WITHIN SIGHT TRIANGLES SHALL NOT INTERFERE WITH CLEAR VISUAL SIGHT LINES FROM 30' TO 10'

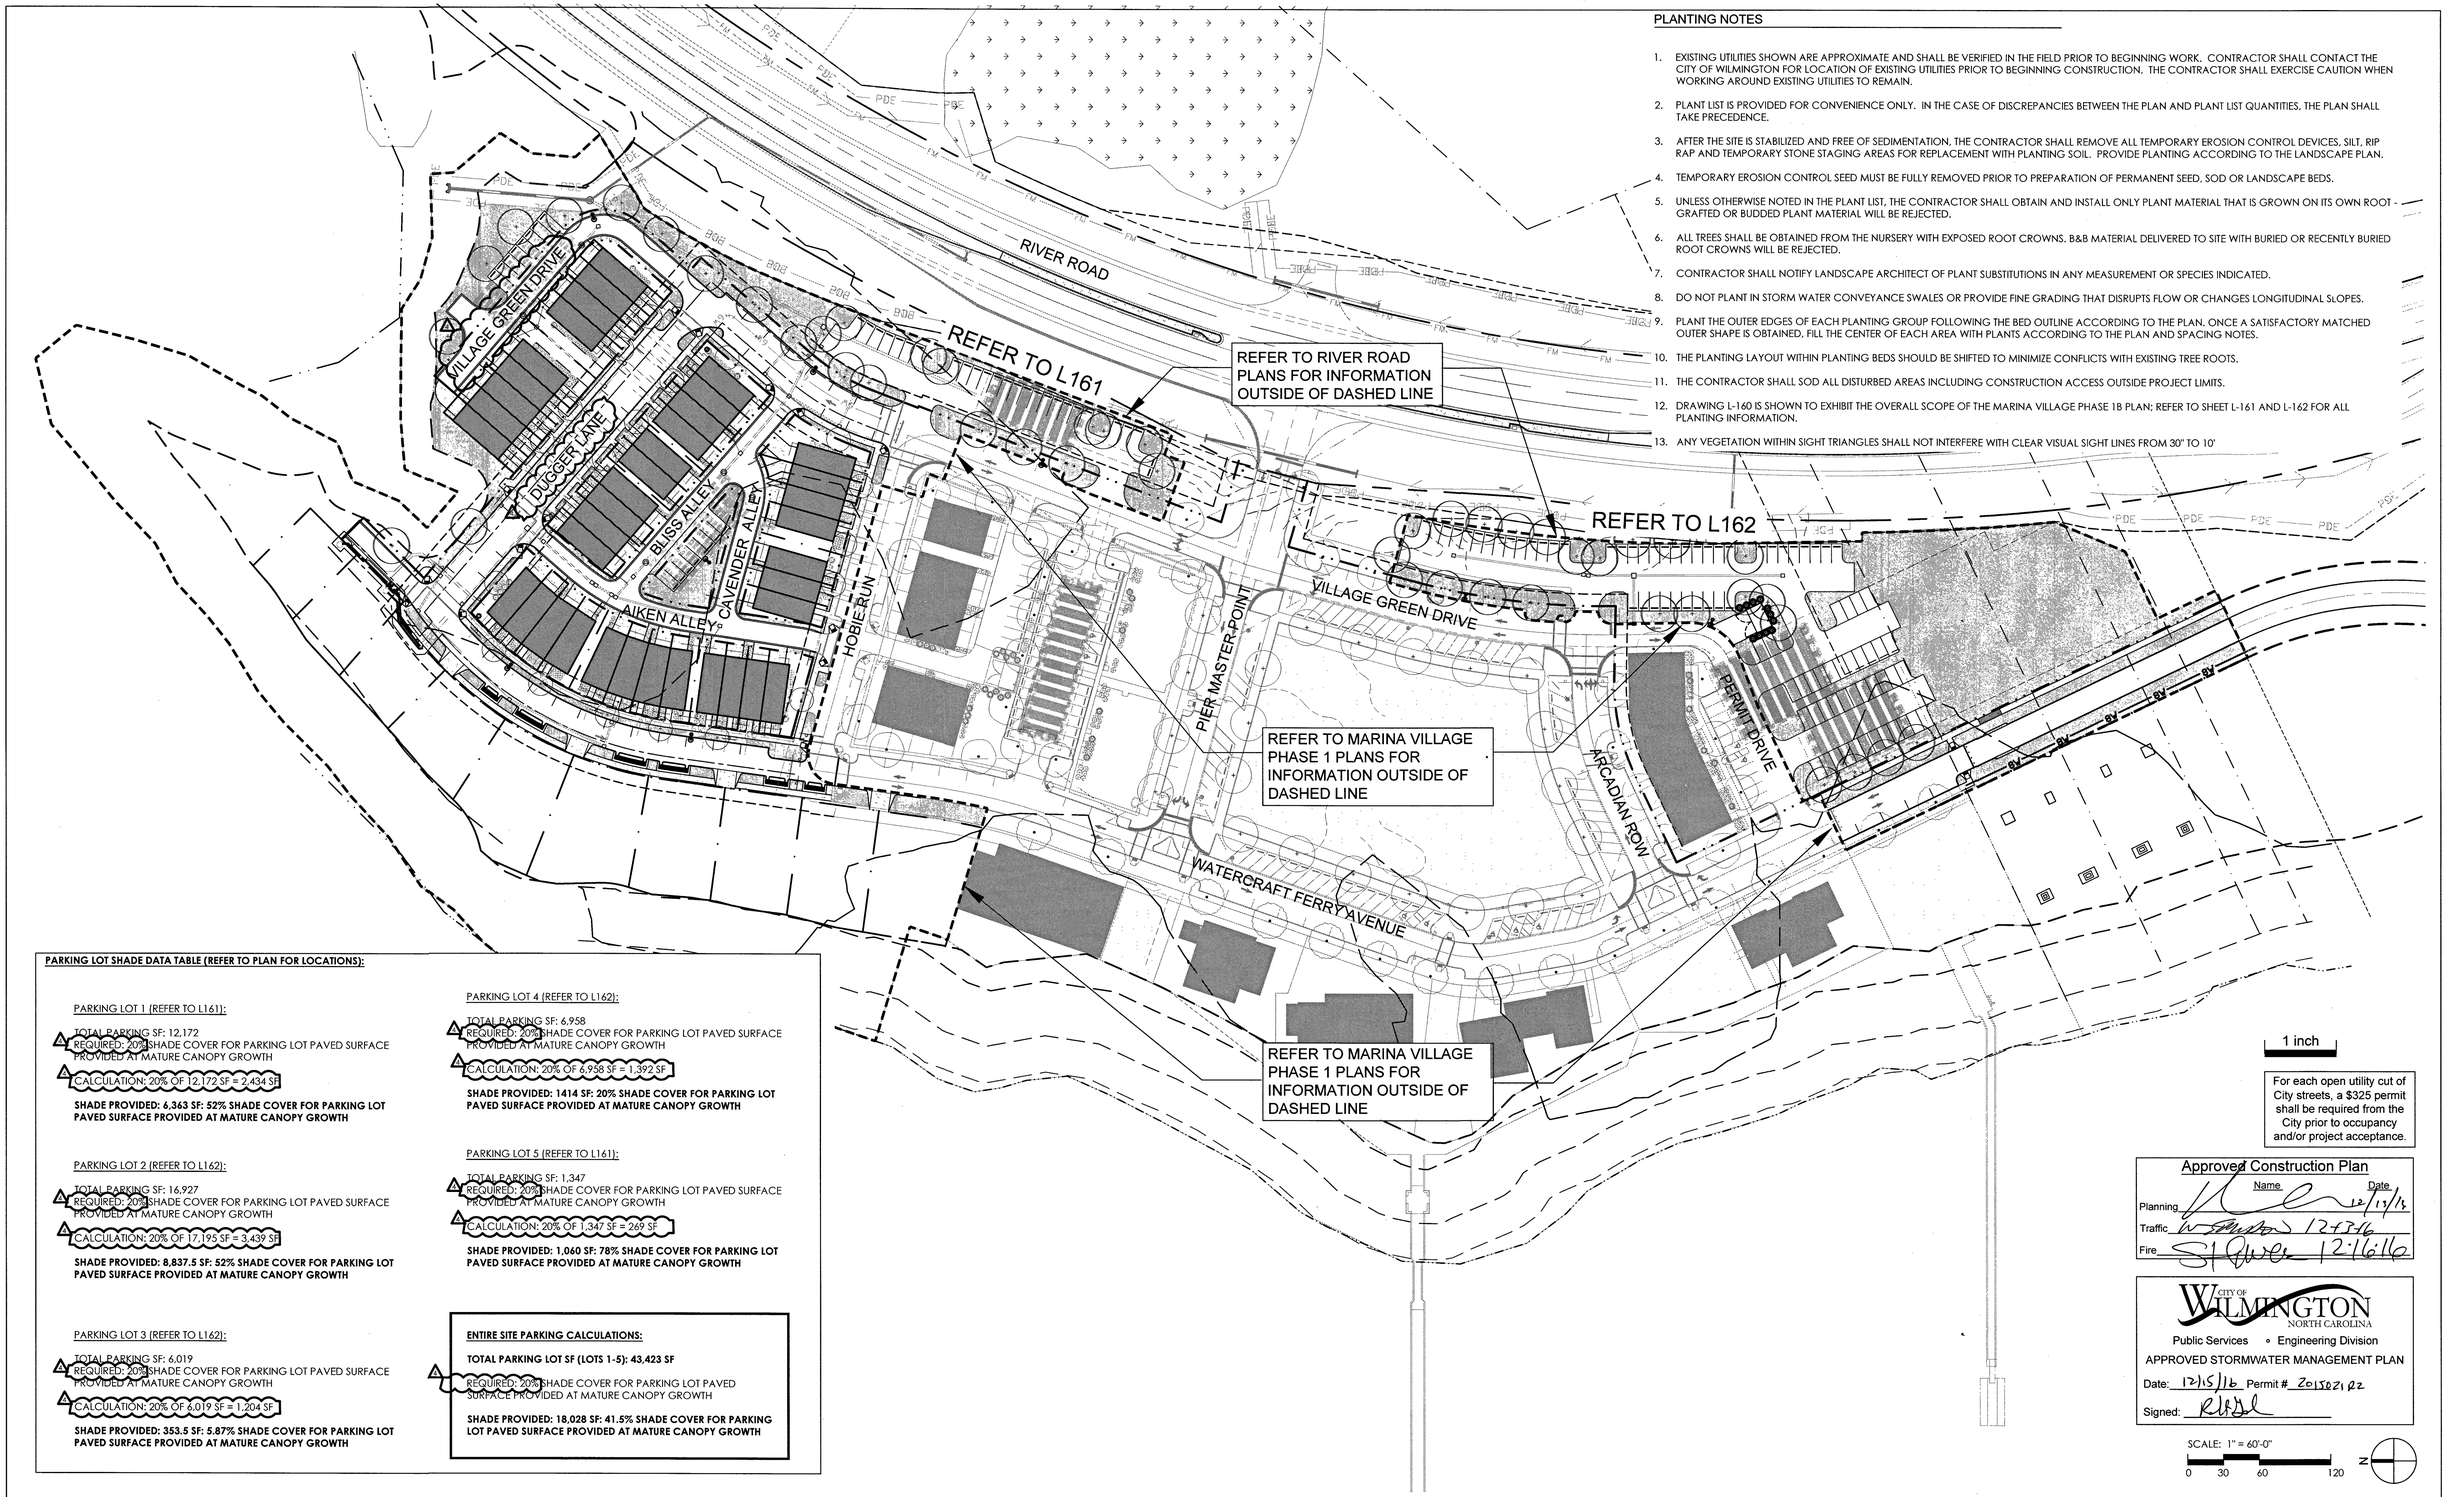

PARKING LOT SHADE DATA TABLE (REFER TO PLAN FOR LOCATIONS):

PARKING LOT 1 (REFER TO L161):

TOTAL PARKING SF: 12,172
REQUIRED: 20% SHADE COVER FOR PARKING LOT PAVED SURFACE PROVIDED AT MATURE CANOPY GROWTH
CALCULATION: 20% OF 12,172 SF = 2,434 SF

SHADE PROVIDED: 6,363 SF: 52% SHADE COVER FOR PARKING LOT PAVED SURFACE PROVIDED AT MATURE CANOPY GROWTH

PARKING LOT 2 (REFER TO L162):

TOTAL PARKING SF: 16,927
REQUIRED: 20% SHADE COVER FOR PARKING LOT PAVED SURFACE PROVIDED AT MATURE CANOPY GROWTH
CALCULATION: 20% OF 17,195 SF = 3,439 SF

SHADE PROVIDED: 8,837.5 SF: 52% SHADE COVER FOR PARKING LOT PAVED SURFACE PROVIDED AT MATURE CANOPY GROWTH

PARKING LOT 3 (REFER TO L162):

TOTAL PARKING SF: 6,019
REQUIRED: 20% SHADE COVER FOR PARKING LOT PAVED SURFACE PROVIDED AT MATURE CANOPY GROWTH
CALCULATION: 20% OF 6,019 SF = 1,204 SF

SHADE PROVIDED: 353.5 SF: 5.87% SHADE COVER FOR PARKING LOT PAVED SURFACE PROVIDED AT MATURE CANOPY GROWTH

PARKING LOT 4 (REFER TO L162):

TOTAL PARKING SF: 6,958
REQUIRED: 20% SHADE COVER FOR PARKING LOT PAVED SURFACE PROVIDED AT MATURE CANOPY GROWTH
CALCULATION: 20% OF 6,958 SF = 1,392 SF

SHADE PROVIDED: 1414 SF: 20% SHADE COVER FOR PARKING LOT PAVED SURFACE PROVIDED AT MATURE CANOPY GROWTH

PARKING LOT 5 (REFER TO L161):

TOTAL PARKING SF: 1,347
REQUIRED: 20% SHADE COVER FOR PARKING LOT PAVED SURFACE PROVIDED AT MATURE CANOPY GROWTH
CALCULATION: 20% OF 1,347 SF = 269 SF

SHADE PROVIDED: 1,060 SF: 78% SHADE COVER FOR PARKING LOT PAVED SURFACE PROVIDED AT MATURE CANOPY GROWTH

ENTIRE SITE PARKING CALCULATIONS:

TOTAL PARKING LOT SF (LOTS 1-5): 43,423 SF

REQUIRED: 20% SHADE COVER FOR PARKING LOT PAVED SURFACE PROVIDED AT MATURE CANOPY GROWTH

SHADE PROVIDED: 18,028 SF: 41.5% SHADE COVER FOR PARKING LOT PAVED SURFACE PROVIDED AT MATURE CANOPY GROWTH

1 inch

For each open utility cut of City streets, a $325 permit shall be required from the City prior to occupancy and/or project acceptance.

Approved Construction Plan

	Name	Date
Planning		12/13/16
Traffic		12-13-16
Fire		12/16/16

CITY OF WILMINGTON NORTH CAROLINA
Public Services ◦ Engineering Division
APPROVED STORMWATER MANAGEMENT PLAN
Date: 12/15/16 Permit # 20150202
Signed:

SCALE: 1" = 60'-0"
0 30 60 120 N

REV.NO	DESCRIPTIONS	DATE
	REVISIONS	
4	REVISION 4	09/25/2016
3	REVISION 3	08/24/2016
2	REVISION 2	07/20/2016
0	ISSUED FOR CONSTRUCTION	03/02/2016

NORTH CAROLINA REGISTERED LANDSCAPE ARCHITECTURAL CORPORATION C-098 SURFACE 678, P.A.

SEAL NORTH CAROLINA 1330 REGISTERED LANDSCAPE ARCHITECT MATTHEW ERIC DAVIS 09/26/2016

McKIM & CREED
License: F-1222
www.mckimcreed.com

NORTH AMERICA SCOTIA HOUSE, LLC
RIVERLIGHTS by Newland COMMUNITIES
Surface
Surface 678, P.A.
215 Morris Street, Suite 100
Durham, NC 27701
www.surface678.com
p: 919-419-1109
f: 919-419-1959

OVERALL PLANTING PLAN SHEET REFERENCE

MARINA VILLAGE PHASE 1B

DATE	11/03/2015
PROJECT	
DRAWN	JI
DESIGNED	JC, ED
CHECKED	JC, ED
PROJ. MGR.	JC

SCALE: AS NOTED

DRAWING NUMBER: L160

CONSTRUCTION DOCUMENTS

PARKING LOT 5 SHADE REQUIREMENT DATA TABLE :

TOTAL PARKING SF: 1,347

REQUIRED: 20% SHADE COVER FOR PARKING LOT PAVED SURFACE PROVIDED AT MATURE CANOPY GROWTH

CALCULATION: 20% OF 1,347 SF = 269 SF

SHADE PROVIDED - 1,060 SF; 78% SHADE COVER FOR PARKING LOT PAVED SURFACE PROVIDED AT MATURE CANOPY GROWTH

PARKING LOT 1 SHADE REQUIREMENT DATA TABLE :

TOTAL PARKING SF: 12,172

REQUIRED: 20% SHADE COVER FOR PARKING LOT PAVED SURFACE PROVIDED AT MATURE CANOPY GROWTH

CALCULATION: 20% OF 12,172 SF = 2,434 SF

SHADE PROVIDED - 6,363 SF; 52% SHADE COVER FOR PARKING LOT PAVED SURFACE PROVIDED AT MATURE CANOPY GROWTH

UNDERGROUND UTILITY; REFER TO CIVIL

FOUNDATION PLANTINGS

(41) OF
(94) SR
(61) CO
(39) RR
(67) IV

RAISED SHRUB PLANTING; TYP. (B2 / L501)

(115) PV ORNAMENTAL GRASSES 24" O.C. 2' HT. 2.5' WITH BLOOMS

(28) OS
(19) UP

SIDEWALK; TYP. REFER TO CIVIL

C1 / L501 RAISED TREE PLANTING; TYP.

C3 / L501 LIGHT POLE; TYP.

3,233 SF SHADE AT MATURE TREE GROWTH

FIRE HYDRANT; TYP. REFER TO CIVIL

32,000 SF SOD

UTILITIES SHOWN FOR REFERENCE ONLY; REFER TO CIVIL

REFER TO RIVER ROAD PLANTING PLANS FOR PLANT TYPE AND QUANTITY OUTSIDE OF DASHED LINE

12,172 SF PARKING LOT 1

UNDERGROUND UTILITIES SHOWN FOR REFERENCE ONLY; REFER TO CIVIL

NON-MUNICIPLE EASEMENT; TYP. REFER TO CIVIL

ROW; TYP. REFER TO CIVIL

REFER TO MARINA VILLAGE PHASE 1 PLANTING PLANS FOR PLANT TYPE AND QUANTITY OUTSIDE OF DASHED LINE

100 YR. FLOOD; TYP. REFER TO CIVIL

PIER MASTER POINT

VILLAGE GREEN DRIVE

DUGGER LANE

BLISS ALLEY

CAVENDER ALLEY

HOBIE RUN

AIKEN ALLEY

WATERCRAFT FERRY AVENUE

SIGHT TRIANGLE; TYP. REFER TO CIVIL

10.00' MIN. TYP.

PROPERTY LINE; TYP. REFER TO CIVIL

STREET TREES SHALL NOT BE CLOSER THAN 10'-0" FROM ANY SIGN; TYP.

50.00' 72.00' 90.00' 49.75' 144.66' 90.66'

LEGEND

	PARKING LOT SHADE REQUIREMENT
	SOD; 419 TIFWAY BERMUDA; SAND BASED SOD
TREES	
+	QUERCUS SHUMARDII
⊙	ULMUS PARVIFOLIA 'EVERCLEAR'
SHRUBS	
④	SERENOA REPENS
⊛	CHAMAECYPARIS OBTUSA 'NANA' GRACILLIS
⊕	ILEX VOMITORIA OBTUSA 'NANA'
⊛	ROSA 'RADRAZZ'
◉	OSMANTHUS FORTUNEI
SIGHT LIGTHING	
⚲	LIGHT POLE; TYP. REFER TO DETAIL C3 / L501

1 inch

For each open utility cut of City streets, a $325 permit shall be required from the City prior to occupancy and/or project acceptance.

Approved Construction Plan

	Name	Date
Planning		12/13/16
Traffic		12-13-16
Fire		12/16/16

CITY OF WILMINGTON NORTH CAROLINA
Public Services ◦ Engineering Division
APPROVED STORMWATER MANAGEMENT PLAN
Date: 12/15/16 Permit # 20156211Z
Signed:

SCALE: 1" = 30'-0"
0 15 30 60

N

REV.NO	DESCRIPTIONS	DATE
4	REVISION 4	09/26/2016
3	REVISION 3	08/24/2016
2	REVISION 2	07/20/2016
0	ISSUED FOR CONSTRUCTION	03/02/2016

REVISIONS

SEAL NORTH CAROLINA REGISTERED LANDSCAPE ARCHITECT C-098 SURFACE 678, P.A.

SEAL NORTH CAROLINA REGISTERED LANDSCAPE ARCHITECT 1330 09/26/2016 MATTHEW ERIC DAVIS

McKIM & CREED
License: F-1222
www.mckimcreed.com

RIVERLIGHTS by Newland COMMUNITIES
North America Scottish House, LLC

Surface
Surface 678, P.A.
310 Morris Street, Suite 100
Durham, NC 27701
www.surface678.com
p: 919-416-1188
f: 919-416-1669

PLANTING PLAN NORTH

MARINA VILLAGE PHASE 1B

DATE	11/03/2015
PROJECT	
DRAWN	JI
DESIGNED	JC, ED
CHECKED	JC, ED
PROJ. MGR.	JC

SCALE: AS NOTED

DRAWING NUMBER: L161

CONSTRUCTION DOCUMENTS

PLANTING SCHEDULE; MARINA VILLAGE PHASE 1B

SYM	QTY	BOTANICAL NAME	COMMON NAME	CAL/RT	MIN. HT.	MIN. SPR.	REMARKS
STREET TREES							
QS	74	QUERCUS SHUMARDII	SHUMARD OAK	3"	----	----	STRONG CENTRAL LEADER; NO INCLUDED BARK
UP	19	ULMUS PARVIFOLIA 'EVERCLEAR'	LACEBARK ELM	3"	----	----	STRONG CENTRAL LEADER; NO INCLUDED BARK
DECIDUOUS SHRUBS							
RR	40	ROSA 'RADRAZZ'	KNOCKOUT ROSE	CONT	12"	12"	FULL DENSE
EVERGREEN SHRUBS							
CO	61	CHAMAECYPARIS OBTUSA 'NANA' GRACILLIS	DWARF HINOKI CYPRESS	CONT	12"	12"	FULL DENSE
IV	67	ILEX VOMITORIA 'NANA'	DWARF YAUPON HOLLY	CONT	12"	12"	FULL DENSE
OF	41	OSMANTHUS FORTUNEI	TEA OLIVE	CONT	12"	12"	FULL DENSE
SR	94	SERENOA REPENS	SAW PALMETTO	CONT	12"	12"	FULL DENSE
ORNAMENTAL GRASEES							
PV	115	PANICUM VIRGATUM 'CAPE BREEZE' PP24895	CAPE BREEZE DWARF SWITCHGRASS	----	----	----	----
SOD							
							419 TIFWAY BERMUDA SAND BASED SOD

PARKING LOT 2 SHADE REQUIREMENT DATA TABLE :

TOTAL PARKING SF: 16,927

1 REQUIRED: 20% SHADE COVER FOR PARKING LOT PAVED SURFACE PROVIDED AT MATURE CANOPY GROWTH

1 CALCULATION: 20% OF 17,195 SF = 3,439 SF

SHADE PROVIDED - 8,837.5 SF; 52% SHADE COVER FOR PARKING LOT PAVED SURFACE PROVIDED AT MATURE CANOPY GROWTH

REFER TO RIVER ROAD PALNTING PLANS FOR PLANT TYPE AND QUANTITY OUTSIDE OF DASHED LINE

4,231 SF SHADE AT MATURE GROWTH

(29) QS

C1 L501 RAISED TREE PLANTING; TYP.

C3 L501 LIGHT POLE; TYP.

(11) OF

SOD

EVENT LAWN #1

POWER EASEMENT; TYP. REFER TO CIVIL

EASEMENT; TYP. REFER TO CIVIL

NONMUNICIPAL EASEMENT; TYP. REFER TO CIVIL

16,927 SF PARKING LOT 2

VILLAGE GREEN DRIVE

OVERHEAD UTILITIES; REFER TO CIVIL DRAWINGS

EASEMENT; REFER TO CIVIL DRAWINGS

OVERHEAD UTILITIES; REFER TO CIVIL DRAWINGS

REFER TO MARINA VILLAGE PHASE 1 PLANTING PLANS FOR PLANT TYPE AND QUANTITY OUTSIDE OF DASHED LINE

6,019 SF PARKING LOT 3

SIGHT TRIANGLE; TYP. REFER TO CIVIL

UNDERGROUND BMP; REFER TO CIVIL PLANS MARINA VILLAGE PHASE 1

EASEMENT; REFER TO CIVIL DRAWINGS

6,958 SF PARKING LOT 4

WATERCRAFT FERRY AVENUE

100 YR. FLOOD; TYP. REFER TO CIVIL

700 SF SHADE AT MATURE GROWTH

ARCADIAN ROW

PERMIT DRIVE

PARKING LOT 4 SHADE REQUIREMENT DATA TABLE :

TOTAL PARKING SF: 6,958

REQUIRED: 20% SHADE COVER FOR PARKING LOT PAVED SURFACE PROVIDED AT MATURE CANOPY GROWTH

CALCULATION: 20% OF 6,958 SF = 1,392 SF

SHADE PROVIDED - 1414 SF; 20% SHADE COVER FOR PARKING LOT PAVED SURFACE PROVIDED AT MATURE CANOPY GROWTH

PARKING LOT 3 SHADE REQUIREMENT DATA TABLE :

TOTAL PARKING SF: 6,019

REQUIRED: 20% SHADE COVER FOR PARKING LOT PAVED SURFACE PROVIDED AT MATURE CANOPY GROWTH

CALCULATION: 20% OF 6,019 SF = 1,204 SF

SHADE PROVIDED - 353.5 SF; 5.87% SHADE COVER FOR PARKING LOT PAVED SURFACE PROVIDED AT MATURE CANOPY GROWTH

LEGEND

- PARKING LOT SHADE REQUIREMENT
- SOD; 419 TIFWAY BERMUDA; SAND BASED SOD

TREES

- QUERCUS SHUMARDII
- ULMUS PARVIFOLIA 'EVERCLEAR'

SHRUBS

- SERENOA REPENS
- CHAMAECYPARIS OBTUSA 'NANA' GRACILLIS
- ILEX VOMITORIA OBTUSA 'NANA'
- ROSA 'RADRAZZ'
- OSMANTHUS FORTUNEI

SIGHT LIGTHING

- LIGHT POLE; TYP.. REFER TO DETAIL C3 / L501

1 inch

For each open utility cut of City streets a $325 permit shall be required from the City prior to occupancy and/or project acceptance.

Approved Construction Plan

	Name	Date
Planning		12/1/16
Traffic		12-13-16
Fire		12/16/16

CITY OF WILMINGTON NORTH CAROLINA

Public Services • Engineering Division

APPROVED STORMWATER MANAGEMENT PLAN

Date: 12/15/16 Permit # 20151221122

Signed:

SCALE: 1" = 30'-0"

0 15 30 60

N

REV.NO.	DESCRIPTIONS	DATE
4	REVISION 4	09/26/2016
3	REVISION 3	08/24/2016
2	REVISION 2	07/20/2016
0	ISSUED FOR CONSTRUCTION	03/02/2016

REVISIONS

SEAL NORTH CAROLINA REGISTERED LANDSCAPE ARCHITECT C-098 SURFACE 678, P.A.

SEAL NORTH CAROLINA REGISTERED LANDSCAPE ARCHITECT 1330 09/26/2016 MATTHEW ERIC DAVIS

McKIM & CREED

License: F-1222

www.mckimcreed.com

RIVERLIGHTS by Newland COMMUNITIES

North America Serenoa Rogue, LLC

Surface

Surface 678, P.A.
215 Morris Street, Suite 150
Durham, NC 27701
www.surface678.com
p: 919-419-1199
f: 919-419-1699

PLANTING PLAN SOUTH

MARINA VILLAGE PHASE 1B

DATE	11/03/2015
PROJECT	
DRAWN	JI
DESIGNED	JC, ED
CHECKED	JC, ED
PROJ. MGR.	JC

SCALE: AS NOTED

DRAWING NUMBER: L162

CONSTRUCTION DOCUMENTS

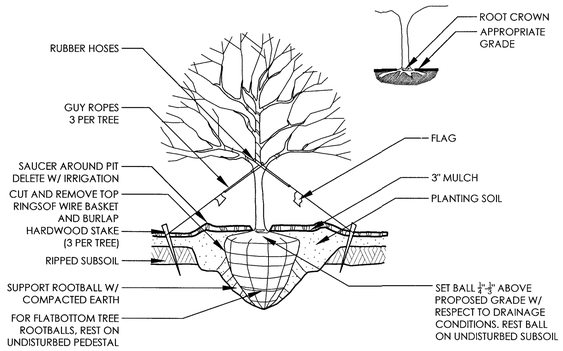

C1 RAISED TREE PLANTING

SCALE: NTS

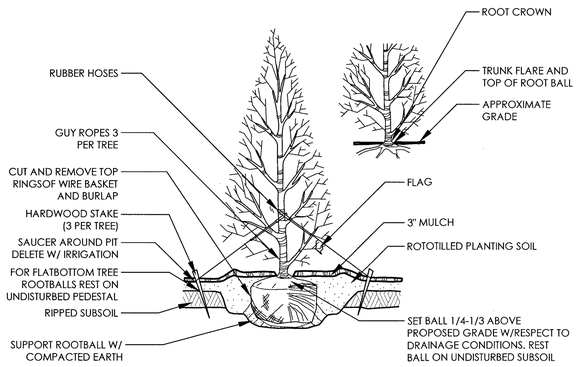

B1 EVERGREEN TREE PLANTING

SCALE: NTS

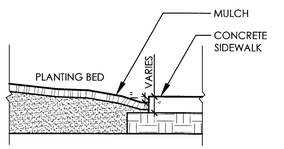

SECTION

A1 CONCRETE/PLANT BED EDGE

0 1' 2'

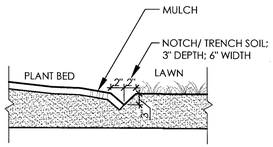

SECTION

D1 LAWN/PLANT BED EDGE

0 1' 2'

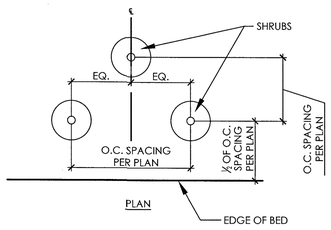

PLAN

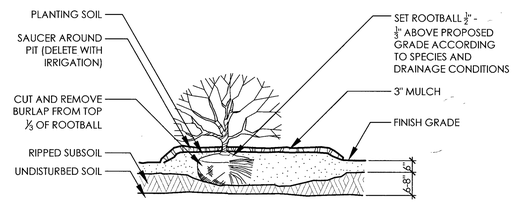

B2 RAISED SHRUB PLANTING

SCALE: NTS

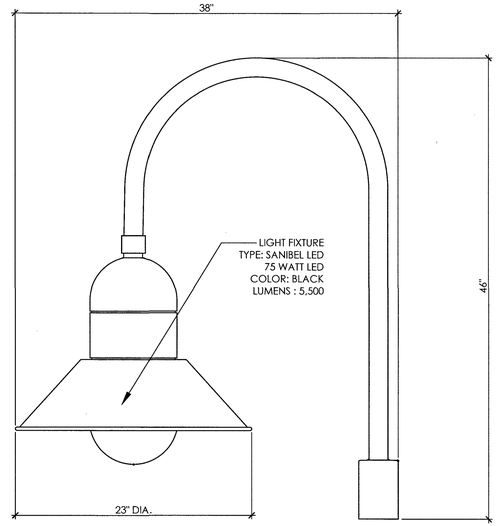

NON STANDARD LIGHT FIXTURE DETAIL

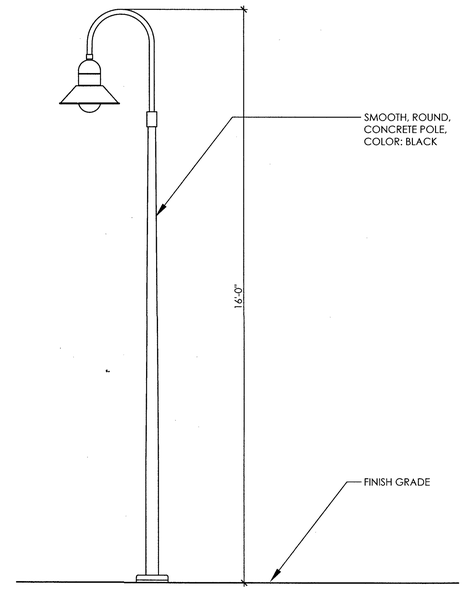

LIGHT FIXTURE POLE ELEVATION

C3 LIGHT POLE

* LIGHT POLE SHOWN FOR REFERENCE ONLY.

* LIGHT POLE TO BE SIMILAR IN STYLE, COLOR, TYPE.

* FINAL LAYOUT AND FOOT CANDLE STUDIES SHALL BE PROVIDED BY THE POWER COMPANY.

0 1' 2'

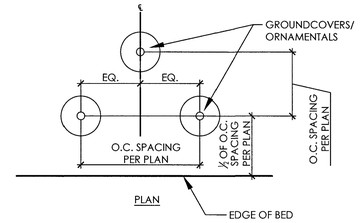

PLAN

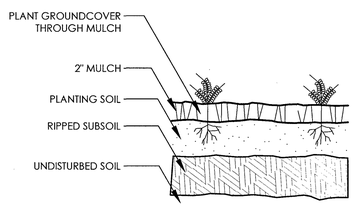

A3 GROUNDCOVER PLANTING

SCALE: NTS

1 inch

For each open utility cut of City streets, a $325 permit shall be required from the City prior to occupancy and/or project acceptance.

Approved Construction Plan

	Name	Date
Planning		12/7/16
Traffic		12-13-16
Fire		12-16-16

CITY OF WILMINGTON NORTH CAROLINA

Public Services ◦ Engineering Division

APPROVED STORMWATER MANAGEMENT PLAN

Date: 12/15/16 Permit # 20150216E2

Signed:

REV.NO.	DESCRIPTIONS	DATE
	REVISIONS	
4	REVISION 4	09/26/2016
3	REVISION 3	08/24/2016
2	REVISION 2	07/20/2016
0	ISSUED FOR CONSTRUCTION	03/02/2016

SEAL — NORTH CAROLINA LANDSCAPE ARCHITECT C-098 SURFACE 678, P.A.

SEAL — NORTH CAROLINA REGISTERED LANDSCAPE ARCHITECT 1330 09/26/2016 MATTHEW ERIC DAVIS

McKIM&CREED

License: F-1222

www.mckimcreed.com

NORTH AMERICA SCENIC HOUSE, LLC

RIVERLIGHTS by Newland COMMUNITIES

Surface

Surface 678, P.A.
215 Morris Street, Suite 150
Durham, NC 27701

www.surface678.com
p 919-419-1196
f 919-419-1869

LANDSCAPE DETAILS

MARINA VILLAGE PHASE 1B

DATE	11/03/2015
PROJECT	
DRAWN	JI
DESIGNED	JC, ED
CHECKED	JC, ED
PROJ. MGR.	JC

SCALE: AS NOTED

DRAWING NUMBER: L501

CONSTRUCTION DOCUMENTS

INFILTRATION GALLERY 4

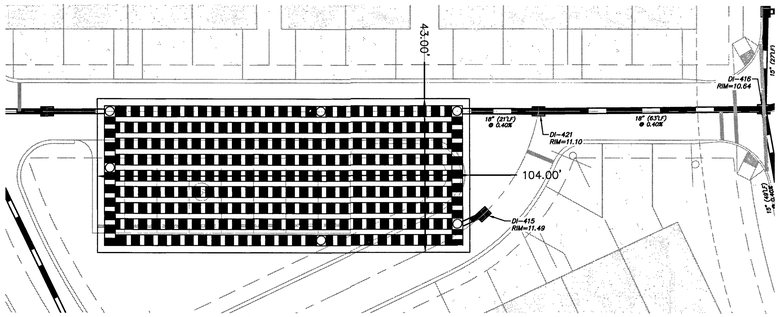

INFILTRATION GALLERY 4
DA= 1.88 AC
WQV STORAGE REQD.= 5,062 CF
STORAGE PROV.= 10,972 CF

PLAN VIEW
SCALE: 1" = 20'

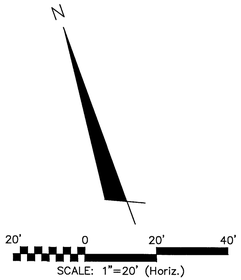

SCALE: 1"=20' (Horiz.)

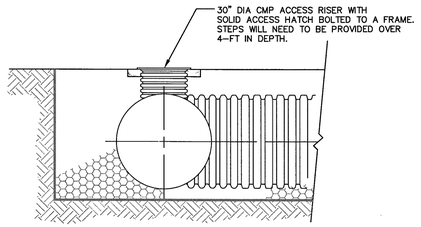

TYP. CMP ACCESS RISER
NOT TO SCALE

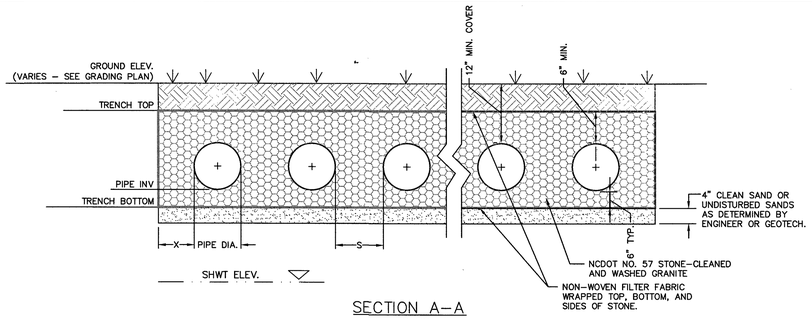

SECTION A-A
NOT TO SCALE

INFILTRATION GALLERY 5

INFILTRATION GALLERY 5
DA= 2.11 AC
WQV STORAGE REQD.= 5,407 CF
STORAGE PROV.= 10,544 CF

PLAN VIEW
SCALE: 1" = 20'

SPLITTER /BYPASS STRUCTURE TABLE		
DESIGN	DI-416	DI-407
RIM ELEVATION	10.64'	11.11'
WEIR ELEVATION	9.00'	9.25'
SUMP ELEVATION	6.34'	6.04'
OUTFALL PIPE INVERT	7.34'	7.10'

INFILTRATION TRENCH SYSTEM TABLE		
DESIGN	INFILTRATION GALLERY 4	INFILTRATION GALLERY 5
# OF RUNS	9	9
LENGTH PER RUN	100'	96'
PIPE DIAMETER (IN)	36"CAP	36"CAP
MIN. X (IN)	2'	2'
MIN. S (IN)	1/2 DIA. OF PIPE	1/2 DIA. OF PIPE
TRENCH WIDTH (FT)	43'	43'
TRENCH LENGTH (FT)	104'	100'
SHWT ELEVATION	4.50'	4.50'
TRENCH BOTTOM ELEVATION	6.50'	6.50'
PIPE TRENCH INVERT	7.00'	7.00'
TRENCH TOP ELEVATION	10.50'	10.50'
10-YR WSEL	9.25'	9.35'

NOTES:
1. SHWT AND HIGH RIVER ELEVATIONS TAKEN FROM SITE & SOILS EVALUATION REPORT BY ECS CAROLINAS, LLP DATED FEBRUARY 18, 2015 FOR NEWLAND COMMUNITIES, LLC.
2. EXISTING ELEVATIONS TAKEN FROM COMBINATION OF FIELD MEASUREMENTS AND TOPOGRAPHY SURVEY BY MCKIM & CREED, INC.

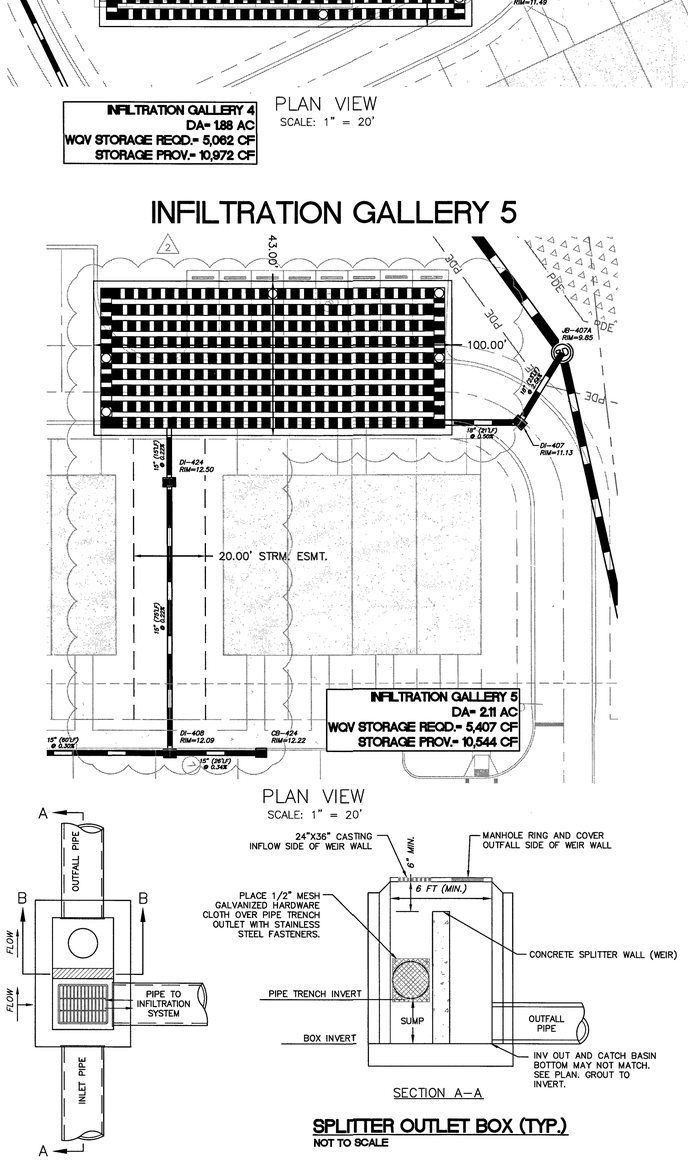

PLAN

SECTION A-A

SECTION B-B

SPLITTER OUTLET BOX (TYP.)
NOT TO SCALE

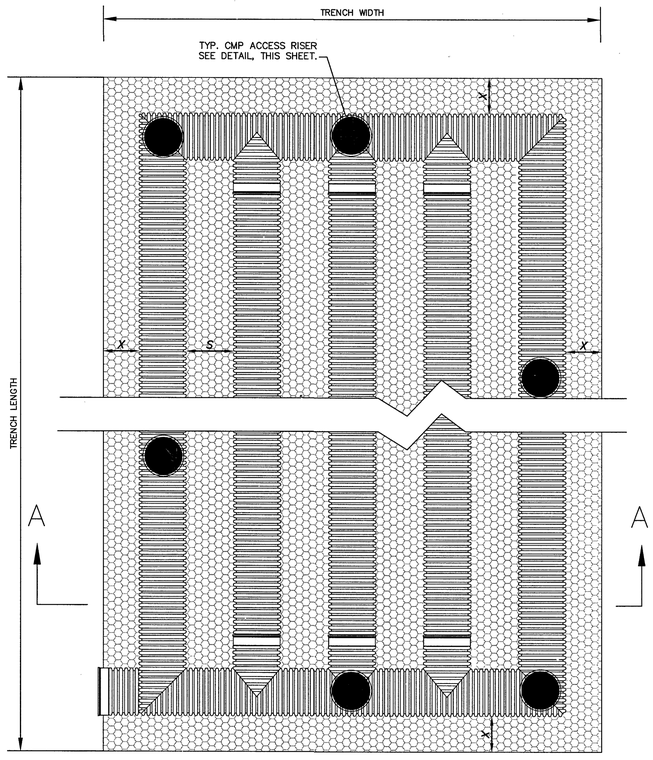

PLAN VIEW
NOT TO SCALE

NOTES:
1. INFILTRATION TRENCH PIPE SHALL BE CONTECH PERFORATED ALUMINIZED OR ALUMINUM CMP PIPE MEETING AASHTO M-36, CLASS 2 PERFORATIONS (3/8" DIA); OR PERFORATED HDPE MEETING AASHTO CLASS 2, TYPE S PERFORATIONS. CONTRACTOR TO SUBMIT INFILTRATION TRENCH SPECIFICATION FOR ENGINEER APPROVAL.
2. CMP OR HDPE PIPE TO BE INSTALLED PER ASTM & MANUFACTURER'S RECOMMENDATIONS. PIPE JOINTS TO BE PER MANUFACTURER'S RECOMMENDATIONS AS AN UNDERGROUND INFILTRATION SYSTEM.
3. SEE TABLE FOR NUMBER OF PIPE RUNS AND DIMENSIONS.
4. IT IS IMPORTANT THAT FILL MATERIAL FOR THE INFILTRATION TRENCHES SHALL BE SAME MATERIAL AS EXISTING SOILS UNDERLYING THE TRENCH. BE SURE NOT TO COMPACT THE SAND UNDER THE TRENCH SO THAT PROPER INFILTRATION RATES CAN OCCUR BELOW THE TRENCHES.

TYP. INFILTRATION TRENCH SYSTEM
NOT TO SCALE

For each open utility cut of City streets, a $325 permit shall be required from the City prior to occupancy and/or project acceptance.

1 inch

Approved Construction Plan

	Name	Date
Planning		12/13/16
Traffic	W Simpson	12-13-16
Fire		12/16/16

CITY OF WILMINGTON NORTH CAROLINA
Public Services Engineering Division
APPROVED STORMWATER MANAGEMENT PLAN
Date: 12/15/16 Permit # 20150283
Signed:

REV.NO.	DESCRIPTIONS	DATE
4	CITY OF WILMINGTON ENGINEERING COMMENTS	09/21/2016
3	CITY OF WILMINGTON TRC COMMENTS	08/23/2016
2	SITE PLAN AND STORM DRAINAGE REVISIONS	07/15/2016
1	CPWA COMMENTS	04/11/2016
0	ISSUED FOR CONSTRUCTION	03/17/2016

REVISIONS

SEAL

SEAL
NORTH CAROLINA PROFESSIONAL ENGINEER SEAL 035107 CIVIL
NICHOLAS J. LAURETTA
12/21/16

McKIM & CREED
243 North Front Street
Wilmington, North Carolina 28401
Phone: (910)343-1048, Fax: (910)251-8282
License: F-1222
www.mckimcreed.com

NORTH AMERICA SEKISUI HOUSE, LLC

RIVERLIGHTS™

RIVERLIGHTS MARINA VILLAGE PHASE 1B

STORMWATER MANAGEMENT DETAILS

DATE:	17MAR16
MCE PROJ. #	2735-0124
DRAWN	ALM
DESIGNED	NJL
CHECKED	KCBE
PROJ. MGR.	NJL

SCALE
HORIZONTAL: 1"=20'
VERTICAL: N/A

M&C FILE NUMBER CN-501
DRAWING NUMBER 23

STATUS: **FINAL DESIGN**
ISSUED FOR CONSTRUCTION
REVISION 2

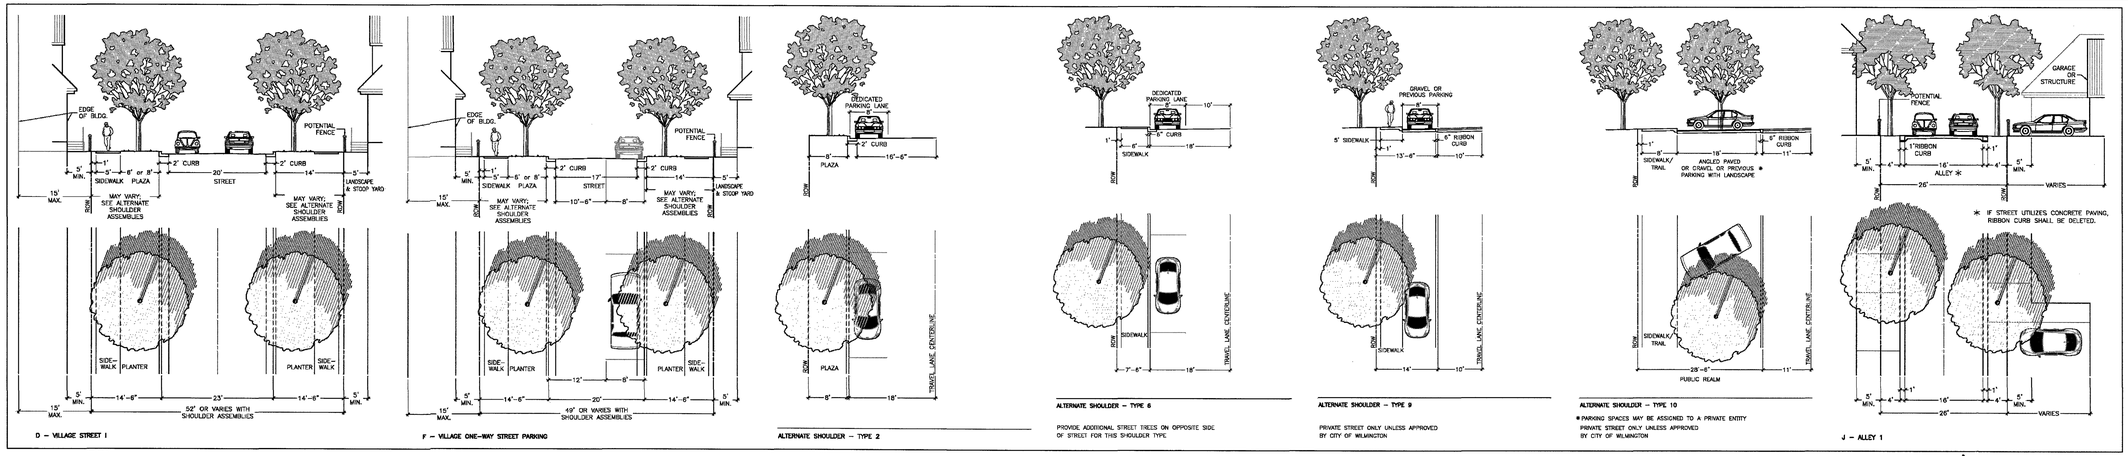

ILLUSTRATIVE STREET SECTIONS FROM DEVELOPMENT AGREEMENT

For each open utility cut of City streets, a $325 permit shall be required from the City prior to occupancy and/or project acceptance.

1 inch

Approved Construction Plan

	Name	Date
Planning		12/12/16
Traffic		12-13-16
Fire		12/16/16

CITY OF WILMINGTON NORTH CAROLINA
Public Services • Engineering Division
APPROVED STORMWATER MANAGEMENT PLAN
Date: 12/15/16 Permit # 20150212
Signed:

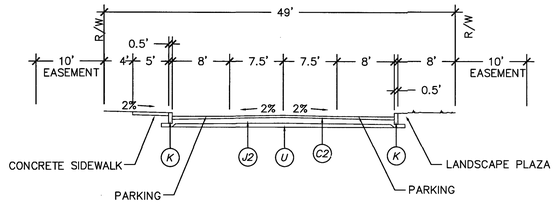

UNDIVIDED TYPICAL SECTION
VILLAGE ONE WAY STREET PARKING
49' PUBLIC R/W
VILLAGE GREEN DRIVE
NOT TO SCALE

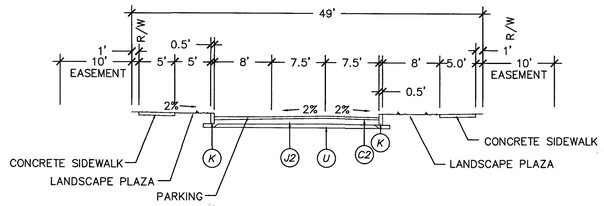

UNDIVIDED TYPICAL SECTION
VILLAGE ONE WAY STREET PARKING
49' PUBLIC R/W
WATERCRAFT FERRY AVENUE
NOT TO SCALE

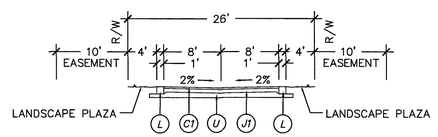

ALLEY TYPICAL SECTION
26' PUBLIC R/W
NOT TO SCALE

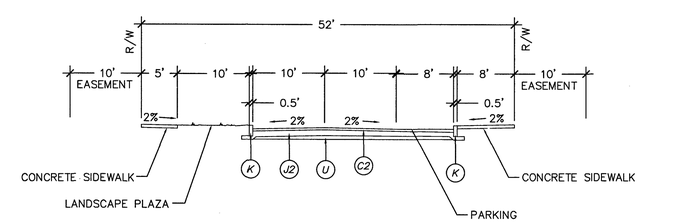

UNDIVIDED TYPICAL SECTION
VILLAGE STREET 1 W/ALTERNATE SHOULDER 4 + 6
52' PRIVATE R/W
NOT TO SCALE

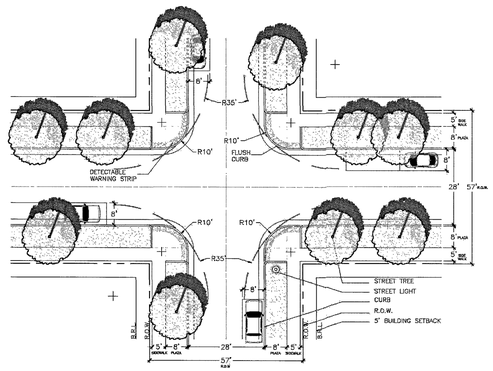

INTERSECTION DIAGRAM
VILLAGE STREET AND
VILLAGE STREET

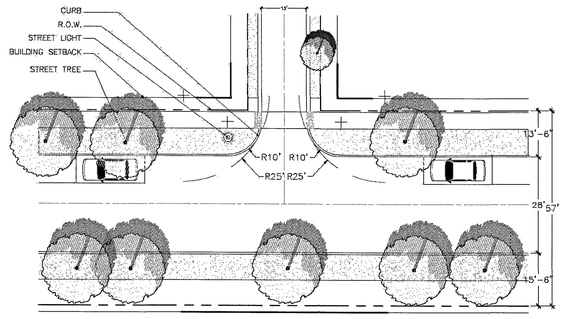

INTERSECTION DIAGRAM
VILLAGE (RESIDENTIAL)
AND ALLEY II

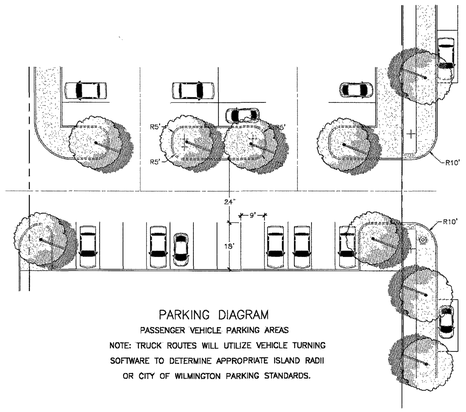

PARKING DIAGRAM
PASSENGER VEHICLE PARKING AREAS
NOTE: TRUCK ROUTES WILL UTILIZE VEHICLE TURNING SOFTWARE TO DETERMINE APPROPRIATE ISLAND RADII OR CITY OF WILMINGTON PARKING STANDARDS.

	PAVEMENT SCHEDULE
C1	2" ASPHALT CONCRETE SURFACE COARSE, TYPE SF9.5A AT AN AVERAGE RATE OF 224 LBS. PER SQ. YD.
C2	3" ASPHALT CONCRETE SURFACE COARSE, TYPE S9.5B AT AN AVERAGE RATE OF 336 LBS. PER SQ. YD.
J1	6.0" COMPACTED ABC STONE BASE COURSE
J2	8.0" COMPACTED ABC STONE BASE COURSE
K	6.0" VERTICAL CURB
L	12.0" RIBBON CURB
U	COMPACTED SUBGRADE

* SEE SHEET CS-501 (14) FOR ADDITIONAL DETAILS AND SECTIONS FOR CURBING, PAVEMENT, STONE, AND SUBGRADE.

ILLUSTRATIVE INTERSECTION DIAGRAMS FROM DEVELOPMENT AGREEMENT

REV.NO.	DESCRIPTIONS	DATE
	REVISIONS	
4	CITY OF WILMINGTON ENGINEERING COMMENTS	09/21/2016
3	CITY OF WILMINGTON TRC COMMENTS	08/23/2016
2	SITE PLAN AND STORM DRAINAGE REVISIONS	07/19/2016
1	CP&L COMMENTS	04/11/2016
0	ISSUED FOR CONSTRUCTION	03/17/2016

SEAL

SEAL
NORTH CAROLINA PROFESSIONAL CIVIL 035107 ENGINEER NICHOLAS J. LARETTA
12/21/16

McKIM&CREED
243 North Front Street
Wilmington, North Carolina 28401
Phone: (910)343-1048, Fax: (910)251-8282
License: F-1222
www.mckimcreed.com

NORTH AMERICA SEKISUI HOUSE, LLC
RIVERLIGHTS™

RIVERLIGHTS MARINA VILLAGE
PHASE 1B

ROADWAY SECTIONS

DATE:	17MAR16
MCE PROJ. #	2735-0124
DRAWN	ALM
DESIGNED	NJL
CHECKED	KCBE
PROJ. MGR.	NJL

SCALE: HORIZONTAL: 1"=50' VERTICAL: N/A

MAC FILE NUMBER: CT-301
DRAWING NUMBER: 24

STATUS: FINAL DESIGN
ISSUED FOR CONSTRUCTION
REVISION: 0

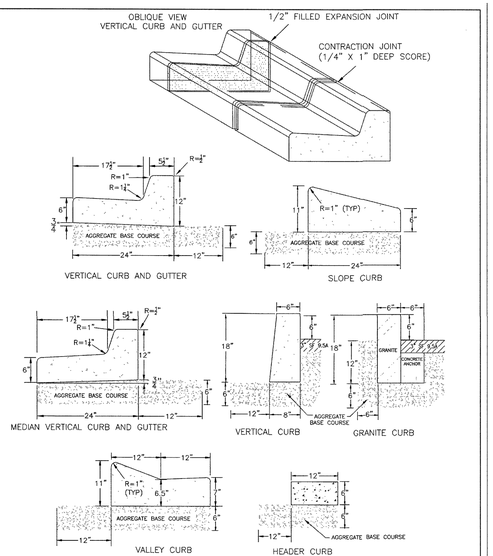

NOTES: 1. EXPANSION JOINT MATERIAL TO COMPLY WITH CURRENT NCDOT STANDARDS
2. 50' MAX EXPANSION JOINT SPACING, 10' MAX CONTRACTION JOINT SPACING
3. MINIMUM INSTALLATION LENGTH IS 5 FT.
4. CONCRETE TO BE 3000 PSI MIN
5. VERTICAL CURB AND GUTTER BASE CAN BE SLOPED 3/4" OR USE A FLAT BASE

STANDARD DETAIL		
DATE: AUGUST, 2011	CURBING	CITY OF WILMINGTON NORTH CAROLINA CITY OF WILMINGTON ENGINEERING PO BOX 1810 WILMINGTON N.C. 28402 (910) 341-7807
DRAWN: PB/JSR		
CHECKED: DEC		
SCALE NOT TO SCALE		SD 3-11

DUKE EASEMENT CROSSING ONLY

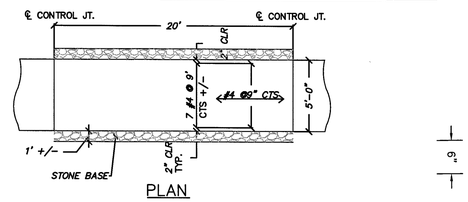

PLAN

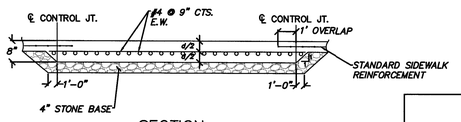

SECTION

- SIDEWALK SECTION IS BASED ON COMPACTED SUBGRADE WITH CBR>8.
- PROVIDE 4" MIN STONE BASE UNDER HEAVY DUTY SIDEWALK SECTION.
- EXTEND STONE BASE 1' MIN BEYOND FOOTPRINT OF HEAVY DUTY SIDEWALK.
- SIDEWALK TO BE MIN 3500 PSI CONCRETE.
- REINFORCING STEEL TO BE PLACED AT CENTER OF SLAB.
- STENCIL "HEAVY EQUIPMENT CROSSING" WITH WHITE POLYUREA PAINT

HEAVY DUTY SIDEWALK DETAIL

NOT TO SCALE

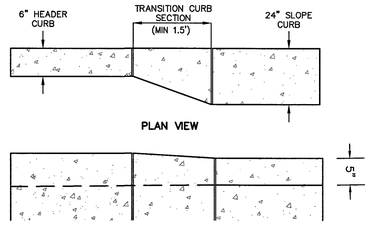

TRANSITION TO SLOPE CURB

NOT TO SCALE

PERMEABLE PAVEMENT NOTES:

- PERMEABLE PAVEMENT WILL BE INSTALLED AT THE END OF THE CONSTRUCTION TIMELINE
- CONSTRUCTION ACCESS TO OTHER PORTIONS OF THE SITE MUST BE ESTABLISHED SO THAT NO CONSTRUCTION TRAFFIC PASSES THROUGH THE PERMEABLE PAVEMENT SITE DURING AND AFTER INSTALLATION. INSTALL BARRIERS OR FENCES AS NEEDED.
- BEFORE CONSTRUCTION OF PERMEABLE PAVEMENT, MAKE SURE:
  a. IMPERVIOUS AREA THAT WILL DRAIN TO THE PERMEABLE PAVEMENT MUST BE COMPLETED AND GRADED SO THAT THEY DO NOT DISCHARGE TO THE PERMEABLE PAVEMENT
  b. AREAS OF THE SITE ADJACENT TO OR DRAINING TOWARDS THE PERMEABLE PAVEMENT MUST BE STABILIZED WITH VEGETATION, MULCH, STRAW, SEED, SOD, FIBER BLANKETS, OR OTHER APPROPRIATE COVER IN ORDER TO PREVENT EROSION AND POSSIBLE CONTAMINATION WITH SEDIMENT.
  c. THE FORECAST SHOULD BE FOR A WINDOW OF DRY WEATHER TO PREVENT EXCESS COMPACTION OR SMEARING OF THE SUBGRADE WHILE IT IS EXPOSED.
- IN ORDER TO PRESERVE SUBGRADE INFILTRATION RATES:
  a. DO NOT ALLOW EQUIPMENT TO CROSS THE PAVEMENT AREA
  b. USE EQUIPMENT WITH TRACKS RATHER THAN TIRES TO MINIMIZE SOIL COMPACTION
- THE FINAL SUBGRADE SLOPE SHALL NOT EXCEED 0.5%
- INSPECT ALL #57 STONE TO INSURE THAT IT IS CLEAN, FREE OF FINES, AND CONFORMS TO THE SPECIFICATIONS IN THE DESIGN PLANS. IF AGGREGATED BECOME CONTAMINATED WITH SEDIMENT, THEN IT SHALL BE REPLACED WITH CLEAN MATERIALS.
- IF THE EXCAVATED SUBGRADE SURFACE IS SUBJECTED TO RAINFALL BEFORE THE PLACEMENT OF THE AGGREGATE BASE, THE RESULTING SURFACE CRUST MUST BE SCARIFIED BREAK UP THE CRUST
- ALL AGGREGATE SHOULD BE SPREAD, NOT DUMPED, BY A FRONT END LOADER

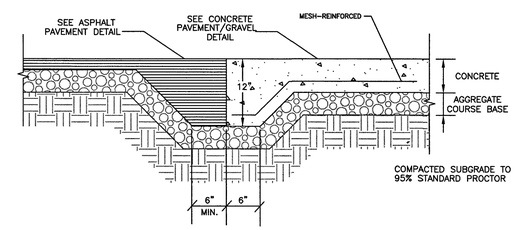

ASPHALT TO CONCRETE/GRAVEL TRANSITION

NOT TO SCALE

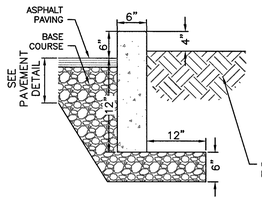

(K) CONCRETE VERTICAL CURB DETAIL

NOT TO SCALE

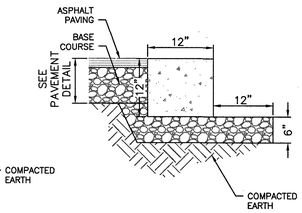

(L) 12" RIBBON CURB DETAIL

NOT TO SCALE

NOTES:

1. **CURB TO BE CONSTRUCTED IN 10 FT. LENGTHS.**
2. **1/2" EXPANSION JOINTS SHALL BE PROVIDED AT INTERVALS NOT TO EXCEED 50 FEET, AT THE ENDS AND MID-POINT OF RETURNS AND AT ANY OTHER POINT WHERE THE NEW CURB AND GUTTER ABUTS OTHER CONCRETE SURFACES.**

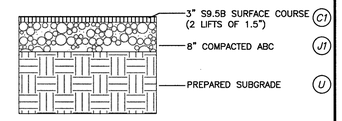

ASPHALT PAVEMENT SECTION (STREET SECTION)

NOT TO SCALE

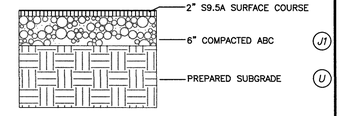

ASPHALT PAVEMENT SECTION (ALLEY/PARKING LOT)

NOT TO SCALE

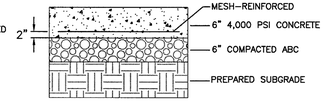

PAVEMENT SHALL BE CONSTRUCTED OF 4,000 PSI CONCRETE. REINFORCEMENT SHALL BE WELDED WIRE FABRIC SPACED 6' O. C. BOTH DIRECTIONS, AS INDICATED BELOW. SURFACE FINISHES AND JOINTS SHALL BE AS INDICATED IN SPECIFICATIONS.

CONCRETE PAVEMENT SECTION (DUMPSTER PAD)

NOT TO SCALE

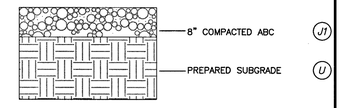

GRAVEL PARKING SECTION (PARKING LOT)

NOT TO SCALE

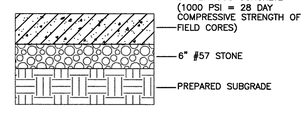

PERVIOUS PAVEMENT SECTION (PARKING STALLS)

NOT TO SCALE

**** COMPACTED ABC NOTE-1:**
COMPACTED ABC MUST MEET THE NCDOT STANDARD SPECIFICATION GRADATION. REFER TO NCDOT STD SPECS (JAN 2012 EDITION) SECTION 520, AND SECTIONS 1005, 1006, AND 1010 FOR ALL OF THE MATERIAL GRADATION AND SPECIFICATIONS.

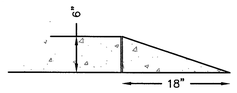

CURB TAPER

NOT TO SCALE

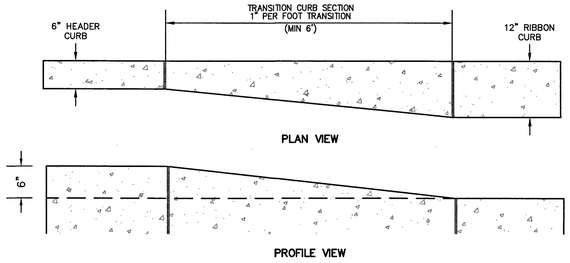

TRANSITION CURB

NOT TO SCALE

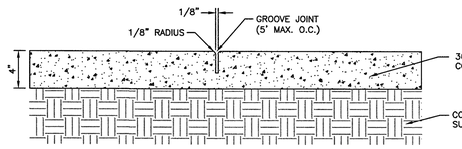

CONCRETE SIDEWALK DETAIL

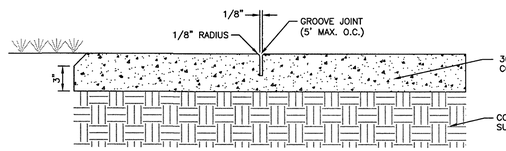

SIDEWALK ADJACENT TO GRASSED AREAS AND PLANTERS

GENERAL NOTES:

1. **A GROOVE JOINT 1" DEEP WITH 1/8" RADII SHALL BE REQUIRED IN THE CONCRETE SIDEWALK AT 5' INTERVALS.**
2. **ONE 1/2" EXPANSION JOINT WILL BE REQUIRED AT 45' INTERVALS.**
3. **A 1/2" EXPANSION JOINT WILL BE REQUIRED WHERE THE SIDEWALK ABUTS ANY CURB AND GUTTER AND ANY RIGID STRUCTURES.**
4. **IN SIDEWALKS AND PLAZA AREAS EXPANSION JOINTS ARE REQUIRED AT NO GREATER THAN 30' INTERVALS.**
5. **CONCRETE SHALL BE 3600 PSI. IN 28 DAYS.**

CONCRETE SIDEWALK DETAIL

NOT TO SCALE

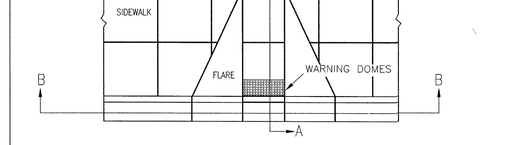

MIN. LANDING WIDTH = RAMP WIDTH
MAX SLOPE 2% IN ANY DIRECTION

SECTION A-A

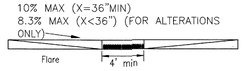

SECTION B-B

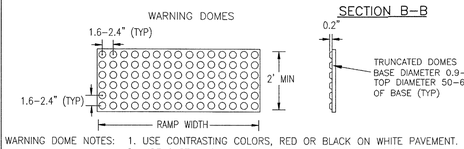

WARNING DOME NOTES: 1. USE CONTRASTING COLORS, RED OR BLACK ON WHITE PAVEMENT.
2. USE CAST IN PLACE PAVERS FOR NEW CONSTRUCTION.
3. RUBBER MATS ARE PERMITTED FOR RETROFITS.
4. LANDING AND RAMP WIDTH MAY BE REDUCED TO 3' WHERE SPACE IS LIMITED AND DESIGN IS APPROVED BY THE CITY ENGINEER.

STANDARD DETAIL		
DATE: DECEMBER, 2010	PERPENDICULAR CURB RAMP ADJACENT TO WALKING SURFACE	CITY OF WILMINGTON NORTH CAROLINA CITY OF WILMINGTON ENGINEERING PO BOX 1810 WILMINGTON N.C. 28402 (910) 341-7807
DRAWN: PB/JSR		
CHECKED: DEC		
SCALE NOT TO SCALE		SD 3-07

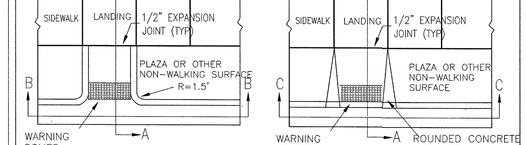

MIN. LANDING WIDTH = RAMP WIDTH
MAX SLOPE 2% IN ANY DIRECTION

SECTION A-A

SECTION B-B

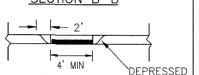

SECTION C-C

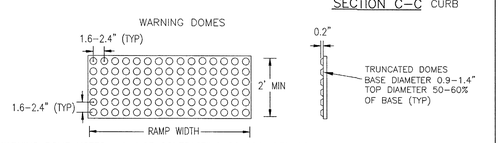

WARNING DOME NOTES: 1. USE CONTRASTING COLORS, RED OR BLACK ON WHITE PAVEMENT.
2. USE CAST IN PLACE PAVERS FOR NEW CONSTRUCTION.
3. RUBBER MATS ARE PERMITTED FOR RETROFITS.
4. LANDING AND RAMP WIDTH MAY BE REDUCED TO 3' WHERE SPACE IS LIMITED AND DESIGN IS APPROVED BY THE CITY ENGINEER.

STANDARD DETAIL		
DATE: DECEMBER, 2010	PERPENDICULAR CURB RAMP ADJACENT TO PLAZA	CITY OF WILMINGTON NORTH CAROLINA CITY OF WILMINGTON ENGINEERING PO BOX 1810 WILMINGTON N.C. 28402 (910) 341-7807
DRAWN: PB/JSR		
CHECKED: DEC		
SCALE NOT TO SCALE		SD3-08

For each open utility cut of City streets, a $325 permit shall be required from the City prior to occupancy and/or project acceptance.

1 inch

Approved Construction Plan

	Name	Date
Planning		12/17/16
Traffic		12-13-16
Fire		12/16/16

CITY OF WILMINGTON NORTH CAROLINA
Public Services - Engineering Division
APPROVED STORMWATER MANAGEMENT PLAN
Date: 12/15/16 Permit # 20150218v2
Signed:

REV.NO.	DESCRIPTIONS	DATE
4	CITY OF WILMINGTON ENGINEERING COMMENTS	09/21/2016
3	CITY OF WILMINGTON TRC COMMENTS	08/23/2016
2	SITE PLAN AND STORM DRAINAGE REVISIONS	07/19/2016
1	CP1A COMMENTS	04/11/2016
0	ISSUED FOR CONSTRUCTION	03/17/2016

REVISIONS

SEAL

SEAL
NORTH CAROLINA PROFESSIONAL ENGINEER SEAL 035107 CIVIL
NICHOLAS J. LAURETTA
09/21/16

McKIM&CREED
243 North Front Street
Wilmington, North Carolina 28401
Phone: (910)343-1048, Fax: (910)251-8282
License: F-1222
www.mckimcreed.com

NORTH AMERICA SEKISUI HOUSE, LLC

RIVERLIGHTS™

RIVERLIGHTS MARINA VILLAGE PHASE 1B

SITE DETAILS

DATE:	17MAR16
MCE PROJ. #	2735-0124
DRAWN	ALM
DESIGNED	NJL
CHECKED	KCBE
PROJ. MGR.	NJL

SCALE: HORIZONTAL: N/A VERTICAL: N/A

M&C FILE NUMBER: CS-501
DRAWING NUMBER: 27

STATUS: **FINAL DESIGN** ISSUED FOR CONSTRUCTION
REVISION 0

LANE LINE OFFSET DETAIL

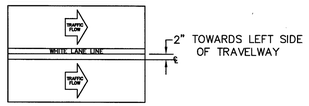

EDGE LINE OFFSET DETAIL

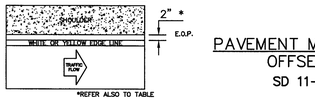

CENTER LINE OFFSET DETAIL

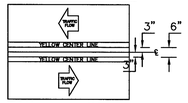

PAVEMENT MARKINGS OFFSETS
SD 11–02

TABLE 1
EDGE LINE OFFSETS FOR 2–LANE, 2–WAY ROADWAYS WITH UN–PAVED SHOULDERS

WIDTH OF TRAVEL PAVEMENT	MAX. EDGE LINE OFFSET FROM E. O. P.	MINIMUM LANE WIDTH
16' – 20'	2"	8' – 10'
22'	2"	11'
24'	1'	11'
26'	2'	11'
28'	2'	12'
30'	3'	12'
32'	4'	12'

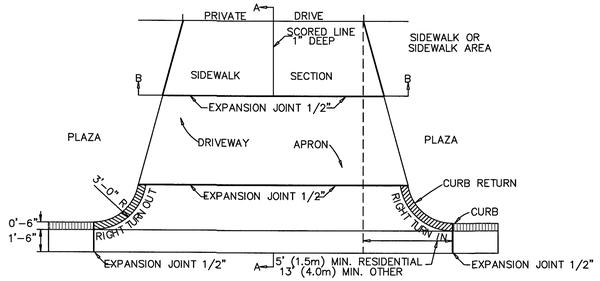

PAVEMENT PLAN

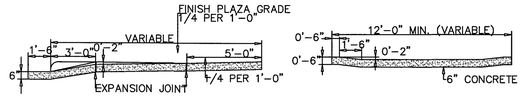

SECTION A–A SECTION B–B

STANDARD DRIVEWAY DETAIL
SD 8–02
NOT TO SCALE

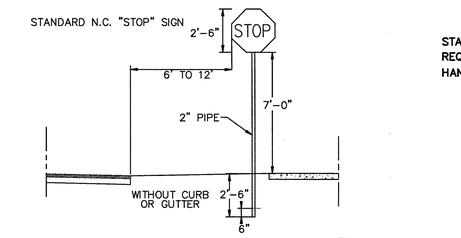

NOTES:
1. STREET NAME SIGNS SHALL BE A MINIMUM OF 6" EXTRUDED ALUMINUM BLADES USING A MINUMUM OF 4" C SERIES LETTERING IN REFLECTIVE SILVER & REFLECTIVE GREEN BACKGROUND.
2. ALL REFLECTIVE SIGNS SHALL BE MADE OF ENGINEERING GRADE OR HIGH INTENSITY GRADE REFLECTIVE SHEETING OR APPROVED EQUIVALENT.
3. ALL SIGNS PLACED IN RIGHT–OF–WAY WILL BE APPROVED BY TRAFFIC ENGINEERING DIVISION.
4. ALL FOOTINGS TYPICAL FOR ALL SIGNS, WHICH NEED TO BE ANCHORED IN CONCRETE.

STANDARD SIGN INSTALLATION LOCATION
SD 15–04
NOT TO SCALE

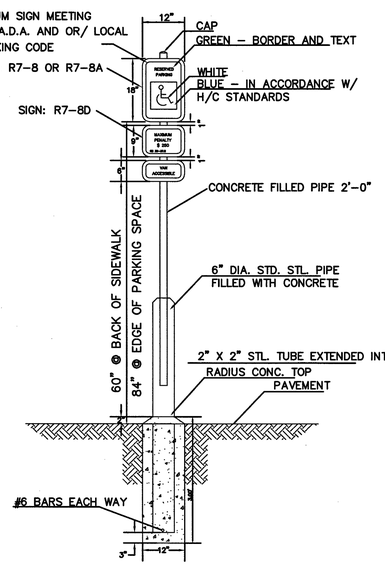

HANDICAP PARKING SIGN
NOT TO SCALE

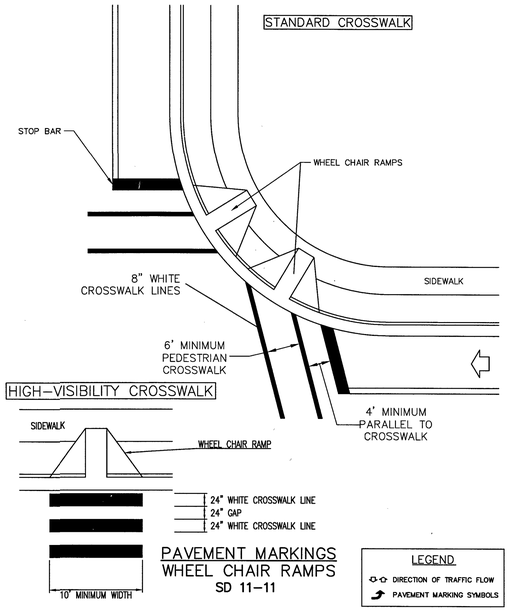

PAVEMENT MARKINGS WHEEL CHAIR RAMPS
SD 11–11

LEGEND
DIRECTION OF TRAFFIC FLOW
PAVEMENT MARKING SYMBOLS

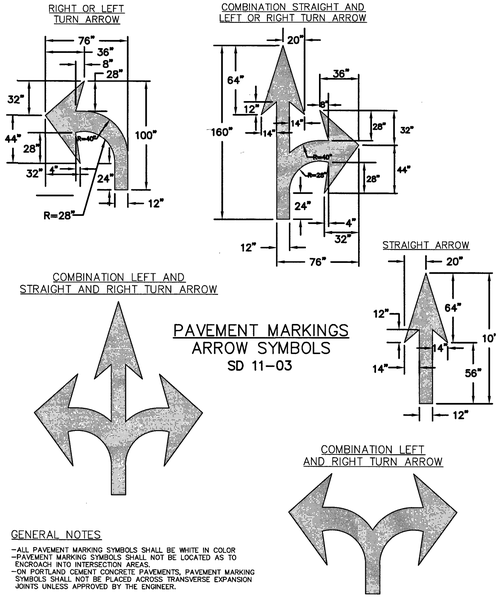

PAVEMENT MARKINGS ARROW SYMBOLS
SD 11–03

GENERAL NOTES
–ALL PAVEMENT MARKING SYMBOLS SHALL BE WHITE IN COLOR
–PAVEMENT MARKING SYMBOLS SHALL NOT BE LOCATED AS TO ENCROACH INTO INTERSECTION AREAS.
–ON PORTLAND CEMENT CONCRETE PAVEMENTS, PAVEMENT MARKING SYMBOLS SHALL NOT BE PLACED ACROSS TRANSVERSE EXPANSION JOINTS UNLESS APPROVED BY THE ENGINEER.

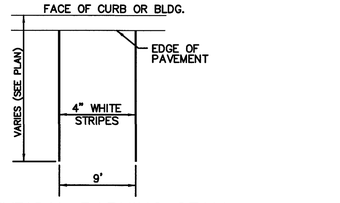

TYPICAL PARKING STALL
NOT TO SCALE

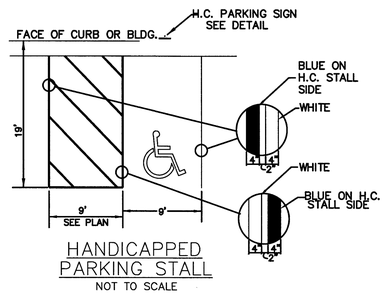

HANDICAPPED PARKING STALL
NOT TO SCALE

GENERAL NOTES

1. IN ACCORDANCE WITH N.C.G.S. 136–44.14, ALL STREET CURBS BEING CONSTRUCTED OR RECONSTRUCTED SHALL PROVIDE WHEELCHAIR RAMPS FOR THE PHYSICALLY HANDICAPPED ON EACH SIDE OF ANY STREET OR ROAD, WHERE CURBS AND SIDEWALKS ARE PROVIDED AND AT OTHER MAJOR POINTS OF PEDESTRIAN FLOW.
2. WHEELCHAIR RAMPS SHALL BE LOCATED AS INDICATED IN DETAIL DRAWINGS; HOWEVER, EXISTING LIGHT POLES, FIRE HYDRANTS, DROP INLETS, ETC. MAY AFFECT PLACEMENT.
3. CURB RAMPS SHALL HAVE DETECTABLE WARNINGS EXTENDING THE FULL WIDTH OF THE RAMP AND A MINIMUM OF 2–FT. IN LENGTH.

CONSTRUCTION NOTES

1. CONSTRUCTION SHALL CONFORM WITH CONSTRUCTION STANDARDS OF THE GOVERNING BODY WHICH HAS JURISDICTION OF THE PARTICULAR STREET.
2. WHEELCHAIR RAMPS SHALL BE CONSTRUCTED OF CLASS "A" CONCRETE WITH THE SURFACE HAVING A ROUGH, NON–SKID TYPE FINISH.
3. A ½–IN. EXPANSION JOINT SHALL BE REQUIRED WHERE THE CONCRETE WHEELCHAIR RAMP JOINS ANY RIGID PAVEMENT OR STRUCTURE.
4. IN NO CASE SHALL THE WIDTH OF A CURB RAMP OR CURB CUT BE LESS THAN 40–IN. (3–FT, 4–IN.), NOT INCLUDING THE FLARED SIDES.
5. TRANSITIONS FROM RAMPS TO WALKS, GUTTERS OR STREETS SHALL BE FLUSH AND FREE OF ABRUPT CHANGES.
6. THE MAXIMUM SLOPE ON THE CURB RAMP RUN IS 1:12.
7. THE MAXIMUM CROSS SLOPE OF THE CURB RAMP IS 1:50.
8. MAXIMUM SLOPES OF ADJOINING GUTTERS, ROAD SURFACE IMMEDIATELY ADJACENT TO THE CURB RAMP, OR ACCESSIBLE ROUTE SHALL NOT EXCEED 1:20.
9. ANY RAISED ISLANDS IN CROSSINGS SHALL BE CUT THROUGH LEVEL WITH THE STREET OR HAVE CURB RAMPS AT BOTH SIDES AND A LEVEL AREA AT LEAST 48–IN. LONG BETWEEN THE CURB RAMPS.
10. DETECTABLE WARNINGS SHALL CONSIST OF RAISED TRUNCATED DOMES WITH A DIAMETER OF NOMINAL 0.9–IN., A HEIGHT OF NOMINAL 0.2–IN. AND A CENTER–TO–CENTER SPACING OF NOMINAL 2.35–IN. AND SHALL CONTRAST VISUALLY WITH ADJOINING SURFACES, EITHER LIGHT–ON–DARK, OR DARK–ON–LIGHT.

ADDITIONAL NOTES

1. STOP BARS SHALL BE USED WHERE IT IS IMPORTANT TO INDICATE THE POINT BEHIND WHICH VEHICLES ARE REQUIRED TO STOP IN COMPLIANCE WITH A TRAFFIC SIGNAL, STOP SIGN OR OTHER LEGAL REQUIREMENT.
2. PARKING SHALL BE ELIMINATED A MINIMUM OF 20 FEET BACK OF THE PEDESTRIAN CROSSWALK.
3. ALL PAVEMENT MARKINGS SHALL BE IN ACCORDANCE WITH THE LATEST EDITION OF THE MANUAL OF UNIFORM TRAFFIC CONTROL DEVICES, PUBLISHED BY THE FEDERAL HIGHWAY ADMINISTRATION. THIS DOCUMENT IS AVAILABLE FROM THE SUPERINTENDENT OF DOCUMENTS, U.S. GOVERNMENT PRINTING OFFICE, WASHINGTON, D.C. 20402.
4. CURB RAMPS AT MARKED CROSSINGS SHALL BE WHOLLY CONTAINED WITHIN THE MARKINGS, EXCLUDING ANY FLARED SIDES.
5. THE BOTTOM OF DIAGONAL (CORNER TYPE) CURB RAMPS AT MARKED CROSSINGS SHALL HAVE 48–IN. MINIMUM CLEAR SPACE WITHIN THE MARKINGS.
6. IF DIAGONAL CURB RAMPS HAVE FLARED SIDES, THEY SHALL HAVE AT LEAST A 24–IN. LONG SEGMENT OF STRAIGHT CURB LOCATED ON EACH SIDE OF THE CURB RAMP AND WITHIN THE MARKED CROSSING.

SD 8–09

For each open utility cut of City streets, a $325 permit shall be required from the City prior to occupancy and/or project acceptance.

1 inch

Approved Construction Plan

	Name	Date
Planning		12/13/16
Traffic		12-13-16
Fire		12/14/16

CITY OF WILMINGTON NORTH CAROLINA
Public Services • Engineering Division
APPROVED STORMWATER MANAGEMENT PLAN
Date: 12/15/16 Permit # 20150221B2
Signed:

REV.NO.	DESCRIPTIONS	DATE
4	CITY OF WILMINGTON ENGINEERING COMMENTS	09/21/2016
3	CITY OF WILMINGTON TRC COMMENTS	08/23/2016
2	SITE PLAN AND STORM DRAINAGE REVISIONS	07/19/2016
1	CPUA COMMENTS	04/11/2016
0	ISSUED FOR CONSTRUCTION	03/17/2016

REVISIONS

SEAL

SEAL
NORTH CAROLINA PROFESSIONAL ENGINEER SEAL 035107 CIVIL NICHOLAS J. LAURETTI 09/21/16

McKIM&CREED
243 North Front Street
Wilmington, North Carolina 28401
Phone: (910)343–1048, Fax: (910)251–8282
License: F–1222
www.mckimcreed.com

NORTH AMERICA SEKISUI HOUSE, LLC

RIVERLIGHTS™

RIVERLIGHTS MARINA VILLAGE PHASE 1B

SITE DETAILS

DATE:	17MAR16
MCE PROJ. #	2735–0124
DRAWN	ALM
DESIGNED	NJL
CHECKED	KCBE
PROJ. MGR.	NJL

SCALE
HORIZONTAL: N/A
VERTICAL: N/A

MAC FILE NUMBER CS–502
DRAWING NUMBER 28

STATUS: FINAL DESIGN
ISSUED FOR CONSTRUCTION
REVISION 0

STATE OF NORTH CAROLINA DEPT. OF TRANSPORTATION DIVISION OF HIGHWAYS RALEIGH, N.C.

1-12

ENGLISH STANDARD DRAWING FOR **CONCRETE CATCH BASIN** 12" THRU 54" PIPE

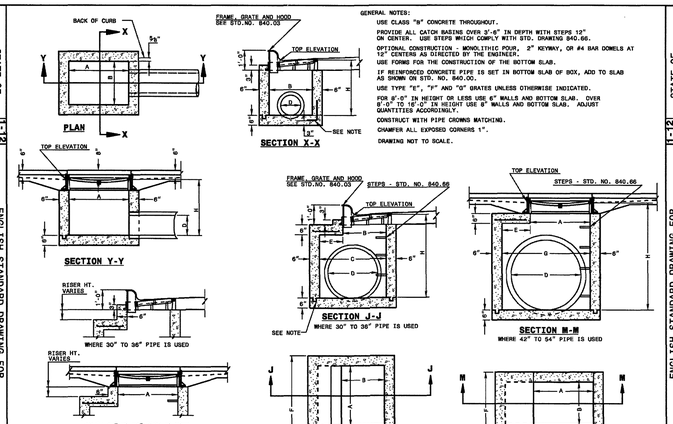

GENERAL NOTES:

USE CLASS "B" CONCRETE THROUGHOUT.

PROVIDE ALL CATCH BASINS OVER 3'-8" IN DEPTH WITH STEPS 12" ON CENTER. USE STEPS WHICH COMPLY WITH STD. DRAWING 840.66.

OPTIONAL CONSTRUCTION - MONOLITHIC POUR, 2" KEYWAY, OR #4 BAR DOWELS AT 12" CENTERS AS DIRECTED BY THE ENGINEER.

USE FORMS FOR THE CONSTRUCTION OF THE BOTTOM SLAB.

IF REINFORCED CONCRETE PIPE IS SET IN BOTTOM SLAB OF BOX, ADD TO SLAB AS SHOWN ON STD. NO. 840.00.

USE TYPE "E", "F" AND "G" GRATES UNLESS OTHERWISE INDICATED.

FOR 8'-0" IN HEIGHT OR LESS USE 6" WALLS AND BOTTOM SLAB. OVER 8'-0" TO 16'-0" IN HEIGHT USE 8" WALLS AND BOTTOM SLAB. ADJUST QUANTITIES ACCORDINGLY.

CONSTRUCT WITH PIPE CROWNS MATCHING.

CHAMFER ALL EXPOSED CORNERS 1".

DRAWING NOT TO SCALE.

SHEET 1 OF 2
840.02

STATE OF NORTH CAROLINA DEPT. OF TRANSPORTATION DIVISION OF HIGHWAYS RALEIGH, N.C.

1-12

ENGLISH STANDARD DRAWING FOR **CONCRETE CATCH BASIN** 12" THRU 54" PIPE

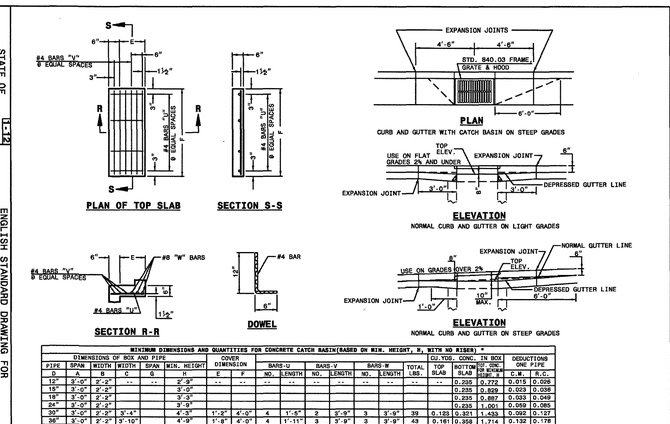

MINIMUM DIMENSIONS AND QUANTITIES FOR CONCRETE CATCH BASIN(BASED ON MIN. HEIGHT, H, WITH NO RISER) *

DIMENSIONS OF BOX AND PIPE							COVER DIMENSION		BARS-U		BARS-V		BARS-W			CU.YDS. CONC. IN BOX		DEDUCTIONS ONE PIPE	
PIPE DIA.	SPAN A	WIDTH B	WIDTH C	SPAN E	MIN. HEIGHT H		E	F	NO.	LENGTH	NO.	LENGTH	NO.	LENGTH	TOTAL LBS.	TOP SLAB	BOTTOM SLAB	OUT SIDE OF BOX SEC. #	C.M.
12"	3'-0"	2'-2"	--	--	2'-9"		--	--	--	--	--	--	--	--	--	0.235	0.772	0.015	0.006
15"	3'-0"	2'-2"			3'-0"											0.235	0.829	0.033	0.008
18"	3'-0"	2'-2"			3'-3"											0.235	0.887	0.033	0.049
24"	3'-0"	2'-2"			3'-9"											0.235	1.001	0.059	0.085
30"	3'-0"	2'-3"	3'-4"		4'-3"		1'-8"	4'-0"	4	1'-5"	2	3'-9"	3	3'-9"	39	0.123	0.321	1.433	0.092	0.127
36"	3'-0"	2'-3"	3'-10"		4'-9"		1'-8"	4'-0"	4	1'-11"	3	3'-9"	3	3'-9"	43	0.161	0.358	1.714	0.132	0.178
42"	3'-0"	2'-3"		4'-5"	5'-3"		1'-8"	3'-3"	4	1'-8"	2	2'-11"	3	2'-11"	32	0.119	0.318	1.738	0.180	0.243
48"	3'-0"	2'-3"		5'-0"	5'-9"		2'-0"	3'-3"	4	2'-3"	3	2'-11"	3	2'-11"	35	0.145	0.352	2.052	0.235	0.317
54"	3'-0"	2'-3"		5'-7"	6'-3"		2'-1"	3'-3"	4	2'-10"	5	2'-11"	3	2'-11"	41	0.180	0.386	2.397	0.297	0.401

* RISER HAS .228 CUBIC YARDS OF CONCRETE PER FOOT HEIGHT

SHEET 2 OF 2
840.02

STATE OF NORTH CAROLINA DEPT. OF TRANSPORTATION DIVISION OF HIGHWAYS RALEIGH, N.C.

1-12

ENGLISH STANDARD DRAWING FOR **TRAFFIC BEARING PRECAST DRAINAGE STRUCTURE**

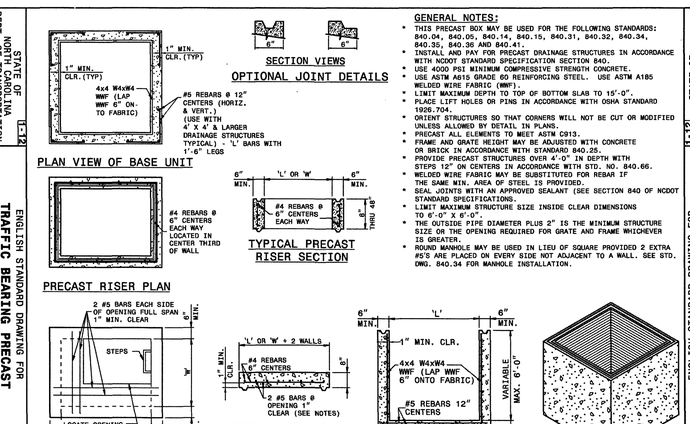

GENERAL NOTES:

- THIS PRECAST BOX MAY BE USED FOR THE FOLLOWING STANDARDS: 840.04, 840.05, 840.14, 840.15, 840.31, 840.32, 840.34, 840.35, 840.36 AND 840.41.
- INSTALL AND PAY FOR PRECAST DRAINAGE STRUCTURES IN ACCORDANCE WITH NCDOT STANDARD SPECIFICATION SECTION 840.
- USE 4000 PSI MINIMUM COMPRESSIVE STRENGTH CONCRETE.
- USE ASTM A615 GRADE 60 REINFORCING STEEL. USE ASTM A185 WELDED WIRE FABRIC (WWF).
- LIMIT MAXIMUM DEPTH TO TOP OF BOTTOM SLAB TO 15'-0".
- PLACE LIFT HOLES OR PINS IN ACCORDANCE WITH OSHA STANDARD 1926.704.
- ORIENT STRUCTURES SO THAT CORNERS WILL NOT BE CUT OR MODIFIED UNLESS ALLOWED BY DETAIL IN PLANS.
- PRECAST ALL ELEMENTS TO MEET ASTM C913.
- FRAME AND GRATE HEIGHT MAY BE ADJUSTED WITH CONCRETE OR BRICK IN ACCORDANCE WITH STANDARD 840.25.
- PROVIDE PRECAST STRUCTURES OVER 4'-0" IN DEPTH WITH STEPS 12" ON CENTERS IN ACCORDANCE WITH STD. NO. 840.66.
- WELDED WIRE FABRIC MAY BE SUBSTITUTED FOR REBAR IF THE SAME WIN. AREA OF STEEL IS PROVIDED.
- SEAL JOINTS WITH AN APPROVED SEALANT (SEE SECTION 840 OF NCDOT STANDARD SPECIFICATIONS.
- LIMIT MAXIMUM STRUCTURE SIZE INSIDE CLEAR DIMENSIONS TO 6'-0" X 6'-0".
- THE OUTSIDE PIPE DIAMETER PLUS 2" IS THE MINIMUM STRUCTURE SIZE OR THE OPENING REQUIRED FOR GRATE AND FRAME WHICHEVER IS GREATER.
- ROUND MANHOLE MAY BE USED IN LIEU OF SQUARE PROVIDED 2 EXTRA #5'S ARE PLACED ON EVERY SIDE NOT ADJACENT TO A WALL. SEE STD. DWG. 840.34 FOR MANHOLE INSTALLATION.

SHEET 1 OF 1
840.46

STATE OF NORTH CAROLINA DEPT. OF TRANSPORTATION DIVISION OF HIGHWAYS RALEIGH, N.C.

1-12

ENGLISH STANDARD DRAWING FOR **FRAME, GRATES, AND HOOD** FOR USE ON STANDARD CATCH BASIN

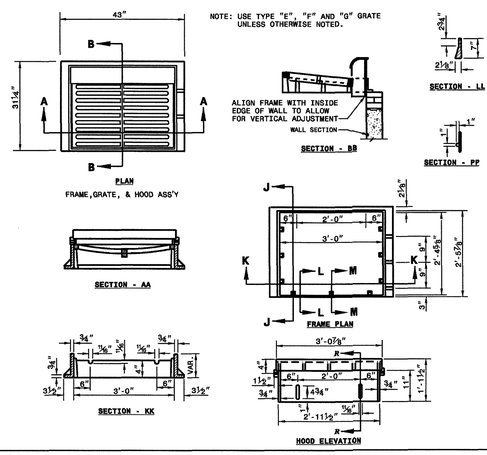

SHEET 1 OF 2
840.03

STATE OF NORTH CAROLINA DEPT. OF TRANSPORTATION DIVISION OF HIGHWAYS RALEIGH, N.C.

1-12

ENGLISH STANDARD DRAWING FOR **FRAME, GRATES, AND HOOD** FOR USE ON STANDARD CATCH BASIN

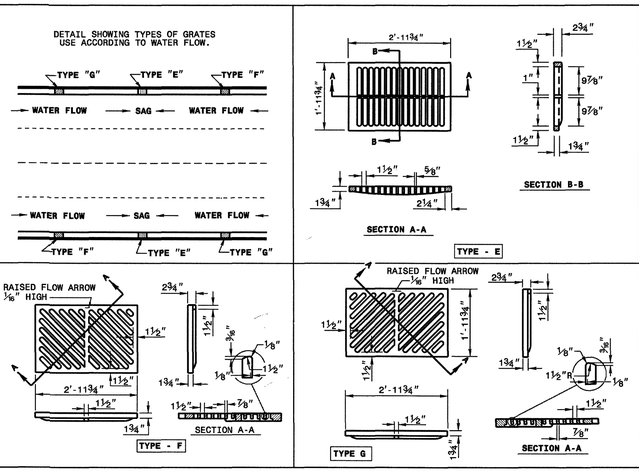

SHEET 2 OF 2
840.03

STATE OF NORTH CAROLINA DEPT. OF TRANSPORTATION DIVISION OF HIGHWAYS RALEIGH, N.C.

1-12

ENGLISH STANDARD DRAWING FOR **MEDIAN CURB FOR CATCH BASIN** (FOR USE WITH 1'-6" CURB AND GUTTER)

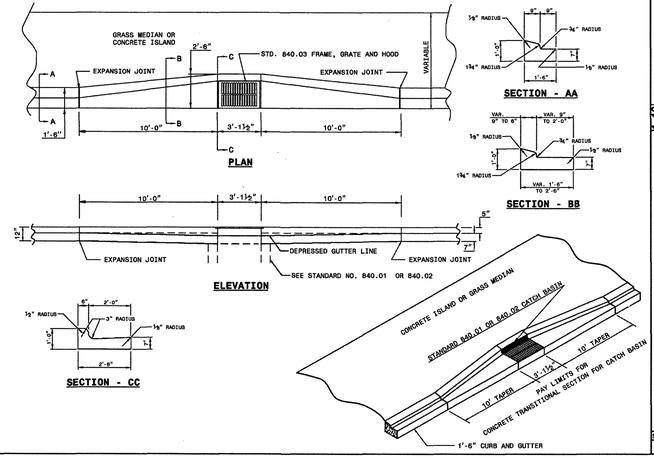

SHEET 1 OF 1
852.05

STATE OF NORTH CAROLINA DEPT. OF TRANSPORTATION DIVISION OF HIGHWAYS RALEIGH, N.C.

1-12

ENGLISH STANDARD DRAWING FOR **DRAINAGE STRUCTURE STEPS**

NOTES:
INSTALL ALL STEPS PROTRUDING 4" FROM INSIDE FACE OF STRUCTURE WALL.
STEPS DIFFERING IN DIMENSIONS, CONFIGURATION, OR MATERIALS FROM THOSE SHOWN MAY ALSO BE USED PROVIDED THE CONTRACTOR HAS FURNISHED THE ENGINEER WITH DETAILS OF THE PROPOSED STEPS AND HAS RECEIVED WRITTEN APPROVAL FROM THE ENGINEER FOR THE USE OF SUCH STEPS.

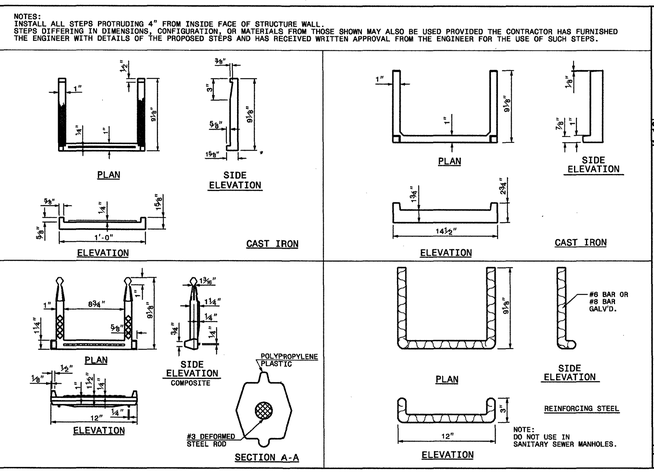

SHEET 1 OF 1
840.66

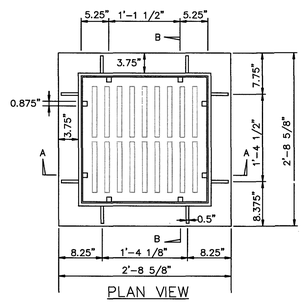

GRILL BASIN CASTINGS
SD 14-04
NOT TO SCALE

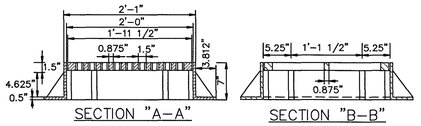

MINIMUM AVERAGE WEIGHT
FRAME 195 LBS.
GRATE 145 LBS.

For each open utility cut of City streets, a $325 permit shall be required from the City prior to occupancy and/or project acceptance.

1 inch

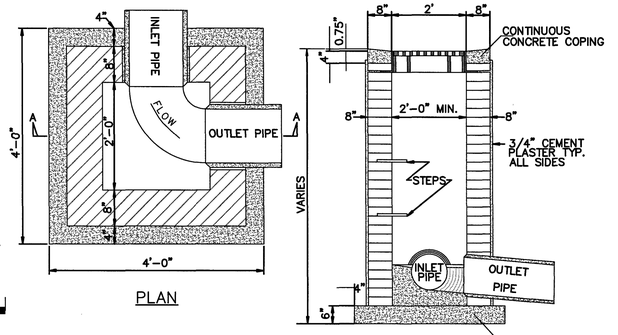

NOTE:
FRAME AND GRATE TO BE STANDARD CITY OF WILMINGTON CAST IRON FRAME AND GRATE PER SD 14-04

GRILL BASIN
SD 2-02
NOT TO SCALE

CITY OF WILMINGTON NORTH CAROLINA
Public Services Engineering Division
APPROVED STORMWATER MANAGEMENT PLAN
Date: 12/15/16 Permit # 3205021822
Signed: BHDL

Approved Construction Plan

	Name	Date
Planning		12/13/16
Traffic		12-13-16
Fire		12/16/16

REV.NO.	DESCRIPTIONS REVISIONS	DATE
4	CITY OF WILMINGTON ENGINEERING COMMENTS	09/21/2016
3	CITY OF WILMINGTON TRC COMMENTS	08/23/2016
2	SITE PLAN AND STORM DRAINAGE REVISIONS	07/19/2016
1	CFPUA COMMENTS	04/11/2016
0	ISSUED FOR CONSTRUCTION	03/17/2016

SEAL

SEAL
NORTH CAROLINA PROFESSIONAL ENGINEER SEAL 035107 NICHOLAS J. LABRETTA
09/21/16

McKIM & CREED
243 North Front Street
Wilmington, North Carolina 28401
Phone: (910)343-1048, Fax: (910)251-8282
License: F-1222
www.mckimcreed.com

NORTH AMERICA SEKISUI HOUSE, LLC

RIVERLIGHTS™

RIVERLIGHTS MARINA VILLAGE PHASE 1B

STORMWATER DRAINAGE DETAILS

DATE:	17MAR16
MCE PROJ. #	2735-0124
DRAWN	ALM
DESIGNED	NJL
CHECKED	KCBE
PROJ. MGR.	NJL

SCALE
HORIZONTAL: N/A
VERTICAL: N/A

MAC FILE NUMBER CG-501
DRAWING NUMBER 29

STATUS: FINAL DESIGN
ISSUED FOR CONSTRUCTION
REVISION 0

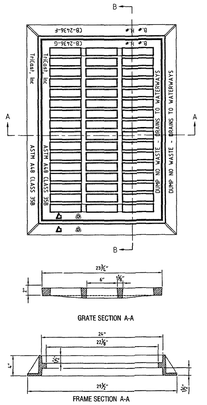

24"x36" CASTING (2DI)
NOT TO SCALE

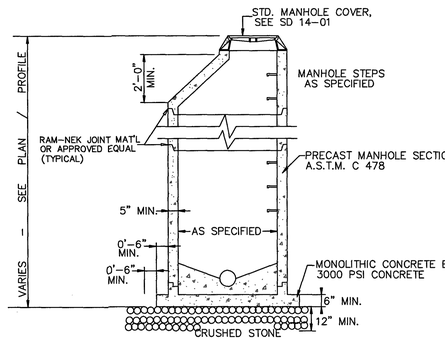

NOTE:
EXTENDED BASE MAY NOT BE REQUIRED WHERE MANHOLES ARE GREATER THAN 4 FEET INSIDE DIAMETER

PRECAST MANHOLE
SD 14-11
NOT TO SCALE

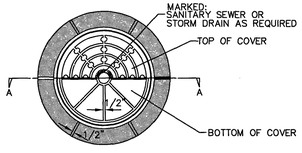

PLAN

NOTE:
RING & COVER CONTACT SURFACES SHALL BE MACHINED SO AS TO INSURE EVEN BEARING OF COVER ON RING

MINIMUM WEIGHTS:
RING 190 LBS.
COVER 120 LBS.

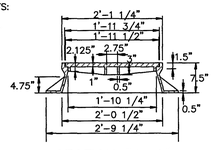

SECTION "A-A"

STANDARD MANHOLE RING AND COVER
SD 14-01
NOT TO SCALE

For each open utility cut of City streets, a $325 permit shall be required from the City prior to occupancy and/or project acceptance.

1 inch

Approved Construction Plan

	Name	Date
Planning		12/13/16
Traffic		12-13-16
Fire		12/16/16

CITY OF WILMINGTON NORTH CAROLINA
Public Services Engineering Division
APPROVED STORMWATER MANAGEMENT PLAN
Date: 12/15/16 Permit # 20150219R2
Signed:

REV.NO.	DESCRIPTIONS REVISIONS	DATE
4	CITY OF WILMINGTON ENGINEERING COMMENTS	09/21/2016
3	CITY OF WILMINGTON TRC COMMENTS	08/23/2016
2	SITE PLAN AND STORM DRAINAGE REVISIONS	07/19/2016
1	CPUA COMMENTS	04/11/2016
0	ISSUED FOR CONSTRUCTION	03/17/2016

SEAL

SEAL
NORTH CAROLINA PROFESSIONAL ENGINEER SEAL 035107 NICHOLAS J. LAURETTA
9/21/16

McKIM&CREED
243 North Front Street
Wilmington, North Carolina 28401
Phone: (910)343-1048, Fax: (910)251-8282
License: F-1222
www.mckimcreed.com

NASH — NORTH AMERICA SEKISUI HOUSE, LLC

RIVERLIGHTS™

RIVERLIGHTS MARINA VILLAGE PHASE 1B

STORMWATER DRAINAGE DETAILS

DATE:	17MAR16
MCE PROJ. #	2735-0124
DRAWN	ALM
DESIGNED	NJL
CHECKED	KCBE
PROJ. MGR.	NJL

SCALE: HORIZONTAL: N/A; VERTICAL: N/A

M&C FILE NUMBER: CG-502
DRAWING NUMBER: 30

STATUS: FINAL DESIGN — ISSUED FOR CONSTRUCTION
REVISION: 0

STATE OF NORTH CAROLINA DEPT. OF TRANSPORTATION DIVISION OF HIGHWAYS RALEIGH, N.C.

L-12

ENGLISH STANDARD DRAWING FOR
CONCRETE ENDWALL FOR SINGLE AND DOUBLE PIPE CULVERTS
15" THRU 48" PIPE - 90° SKEW

SHEET 1 OF 3
838.01

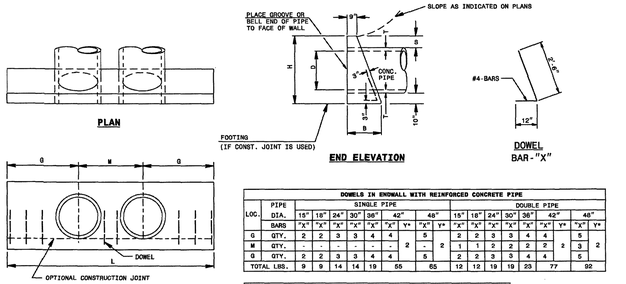

DOWELS IN ENDWALL WITH REINFORCED CONCRETE PIPE

LOC.	PIPE DIA.	SINGLE PIPE 15"	18"	24"	30"	36"	42"	48"	DOUBLE PIPE 15"	18"	24"	30"	36"	42"	48"
	BARS	"X"	"X"	"X"	"X"	"X"	"X" Y*	"X" Y*	"X"	"X"	"X"	"X"	"X"	"X" Y*	"X" Y*
G	QTY.	2	2	3	3	4	4	5	2	2	3	3	4	4	5
M	QTY.	-	-	-	-	-	2	2	1	1	2	2	2	2	3
G	QTY.	2	2	3	3	4	4	5	2	2	3	3	4	4	5
TOTAL LBS.		9	9	14	14	19	55	65	12	12	19	19	23	77	92

DIMENSIONS AND CONCRETE QUANTITIES

USING CONCRETE PIPE										
		COMMON DIMENSIONS				SINGLE PIPE		DOUBLE PIPE		
D	H	B	G	T	S	L	YD³	M	L	YD³
15"	3'-3"	1'-8"	2'-9"	5¼"	9½"	5'-6"	0.7	2'-3"	7'-6"	1.0
18"	3'-7"	1'-10"	3'-2"	5½"	10"	6'-4"	1.0	2'-7"	8'-11"	1.3
24"	4'-2"	2'-1"	4'-0"	3"	10"	8'-0"	1.5	3'-5"	11'-5"	2.0
30"	5'-0"	2'-6"	4'-7"	4¼"	11½"	9'-2"	2.3	4'-3"	13'-5"	3.1
36"	5'-8"	2'-8"	5'-6"	4¾"	11½"	11'-0"	3.4	5'-0"	16'-0"	4.5
42"	6'-2"	3'-1"	6'-4"	5¼"	11½"	12'-8"	4.5	5'-10"	18'-6"	6.0
48"	6'-9"	3'-5"	7'-2"	5¾"	11½"	14'-4"	6.0	6'-8"	21'-0"	8.0

*SEE SHEET 3

STATE OF NORTH CAROLINA DEPT. OF TRANSPORTATION DIVISION OF HIGHWAYS RALEIGH, N.C.

L-12

ENGLISH STANDARD DRAWING FOR
CONCRETE ENDWALL FOR SINGLE AND DOUBLE PIPE CULVERTS
15" THRU 48" PIPE - 90° SKEW

SHEET 2 OF 3
838.01

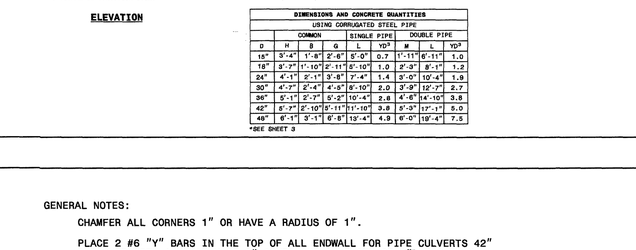

DOWELS IN ENDWALL WITH C. S. PIPE

LOC.	PIPE DIA.	SINGLE PIPE 15"	18"	24"	30"	36"	42"	48"	DOUBLE PIPE 15"	18"	24"	30"	36"	42"	48"
	BARS	"X"	"X"	"X"	"X"	"X"	"X" Y*	"X" Y*	"X"	"X"	"X"	"X"	"X"	"X" Y*	"X" Y*
G	QTY.	2	2	3	3	4	4	5	2	2	3	3	4	4	5
M	QTY.	-	-	-	-	-	2	2	1	1	1	2	2	2	2
G	QTY.	2	2	3	3	4	4	5	2	2	2	3	3	4	5
TOTAL LBS.		9	9	14	14	19	53	62	12	12	16	19	23	73	85

DIMENSIONS AND CONCRETE QUANTITIES

USING CORRUGATED STEEL PIPE								
	COMMON			SINGLE PIPE		DOUBLE PIPE		
D	H	B	G	L	YD³	M	L	YD³
15"	3'-4"	1'-8"	2'-6"	5'-0"	0.7	1'-11"	6'-11"	1.0
18"	3'-7"	1'-10"	2'-11"	5'-10"	1.0	2'-3"	8'-1"	1.2
24"	4'-1"	2'-1"	3'-8"	7'-4"	1.4	3'-0"	10'-4"	1.8
30"	4'-7"	2'-4"	4'-5"	8'-10"	2.0	3'-9"	12'-7"	2.7
36"	5'-1"	2'-7"	5'-2"	10'-4"	2.8	4'-6"	14'-10"	3.8
42"	5'-7"	2'-10"	5'-11"	11'-10"	3.8	5'-3"	17'-1"	5.0
48"	6'-1"	3'-1"	6'-8"	13'-4"	4.9	6'-0"	19'-4"	7.5

*SEE SHEET 3

STATE OF NORTH CAROLINA DEPT. OF TRANSPORTATION DIVISION OF HIGHWAYS RALEIGH, N.C.

L-12

ENGLISH STANDARD DRAWING FOR
CONCRETE ENDWALL FOR SINGLE AND DOUBLE PIPE CULVERTS
15" THRU 48" PIPE - 90° SKEW

SHEET 3 OF 3
838.01

GENERAL NOTES:

CHAMFER ALL CORNERS 1" OR HAVE A RADIUS OF 1".

PLACE 2 #6 "Y" BARS IN THE TOP OF ALL ENDWALL FOR PIPE CULVERTS 42" AND OVER WITH A MINIMUM OF 3" COVER AND A LENGTH OF 6" LESS THAN ENDWALL LENGTH.

CONSTRUCT BOTTOM SLAB WITH FORMS.

DO NOT INTERPRET WALL THICKNESS (T) SHOWN FOR THE THICKNESS ACCEPTABLE, BUT IS USED IN COMPUTING ENDWALL QUANTITIES.

WHEN THE CONTRACTOR ELECTS TO USE A CONSTRUCTION JOINT AT THE BOTTOM OF THE PIPE, PLACE BAR "X" DOWELS IN THE BASE AS SHOWN ON PLANS. SPACE BARS APPROXIMATELY ON 12" CENTERS UNLESS OTHERWISE DIRECTED BY THE ENGINEER.

WHEN THE CONTRACTOR ELECTS TO USE A CONSTRUCTION JOINT AT THE BOTTOM OF THE PIPE AND POUR THE BASE SEPARATELY LEAVE THE POUR ROUGH.

USE CLASS "B" CONCRETE.

STATE OF NORTH CAROLINA DEPT. OF TRANSPORTATION DIVISION OF HIGHWAYS RALEIGH, N.C.

L-12

ENGLISH STANDARD DRAWING FOR
TRAFFIC BEARING GRATED DROP INLET
FOR CAST IRON DOUBLE FRAME AND GRATES

SHEET 1 OF 2
840.35

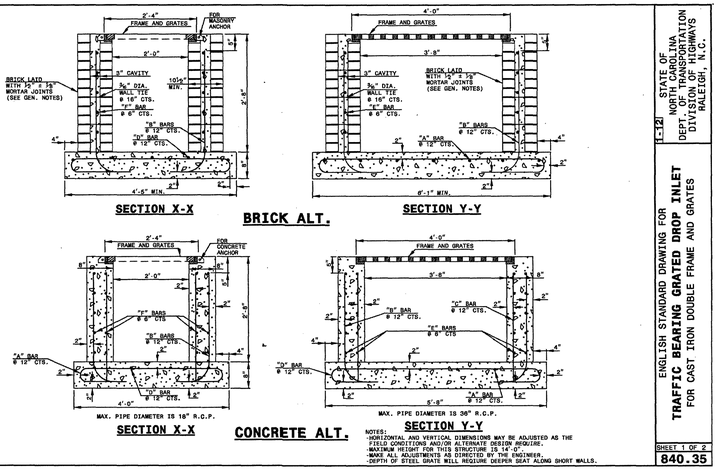

NOTES:
-HORIZONTAL AND VERTICAL DIMENSIONS MAY BE ADJUSTED AS THE FIELD CONDITIONS AND/OR ALTERNATE DESIGN REQUIRE.
-MAXIMUM HEIGHT FOR THIS STRUCTURE IS 14'-0".
-WALL AND FOOTING MAY BE EXTENDED BY THE ENGINEER.
-DEPTH OF STEEL GRATE WILL REQUIRE DEEPER SEAT ALONG SHORT WALLS.

STATE OF NORTH CAROLINA DEPT. OF TRANSPORTATION DIVISION OF HIGHWAYS RALEIGH, N.C.

L-12

ENGLISH STANDARD DRAWING FOR
TRAFFIC BEARING GRATED DROP INLET
FOR CAST IRON DOUBLE FRAME AND GRATES

SHEET 2 OF 2
840.35

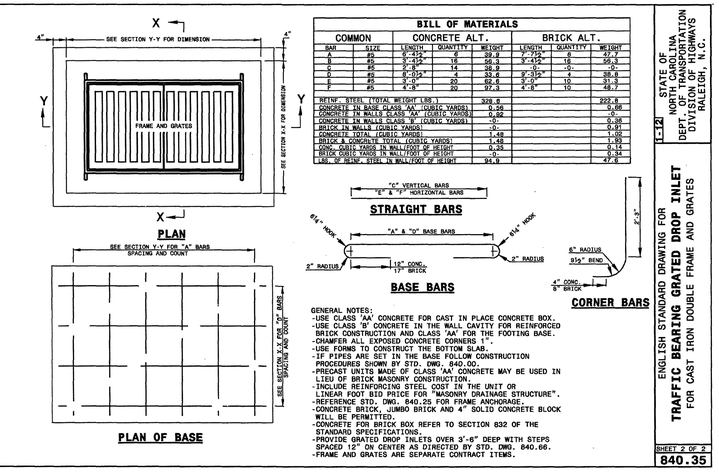

BILL OF MATERIALS

COMMON		CONCRETE ALT.			BRICK ALT.		
BAR	SIZE	LENGTH	QUANTITY	WEIGHT	LENGTH	QUANTITY	WEIGHT
A	#5	6'-4½"	6	39.9	5'-7½"	6	47.7
B	#5	3'-4½"	6	20.9	3'-4½"	6	20.9
C	#5	5'-0"	14	36.9	-0-	-0-	-0-
D	#5	5'-10½"	6	30.6	5'-10½"	6	30.6
E	#5	4'-8"	20	62.6	4'-8"	10	31.3
F	#5	4'-8"	20	97.5	4'-8"	10	48.7
REINF. STEEL (TOTAL WEIGHT LBS.)				328.6			229.8
CONCRETE IN BASE CLASS "AA" (CUBIC YARDS)				0.96			0.68
CONCRETE IN WALLS CLASS "AA" (CUBIC YARDS)				0.92			-0-
CONCRETE IN WALLS CLASS "B" (CUBIC YARDS)				-0-			0.36
BRICK IN WALLS (CUBIC YARDS)				-0-			0.91
CONCRETE TOTAL (CUBIC YARDS)				1.48			1.05
BRICK & CONCRETE TOTAL (CUBIC YARDS)				1.48			1.93
CONC. CUBIC YARDS IN WALL/FOOT OF HEIGHT				0.35			0.15
BRICK CUBIC YARDS IN WALL/FOOT OF HEIGHT				-0-			0.34
LBS. OF REINF. STEEL IN WALL/FOOT OF HEIGHT				94.9			47.6

GENERAL NOTES:
-USE CLASS 'AA' CONCRETE FOR CAST IN PLACE CONCRETE BOX.
-USE CLASS 'B' CONCRETE IN THE WALL CAVITY FOR REINFORCED BRICK CONSTRUCTION AND CLASS 'AA' FOR THE FOOTING BASE.
-CHAMFER ALL EXPOSED CONCRETE CORNERS 1".
-USE FORMS TO CONSTRUCT THE BOTTOM SLAB.
-IF PIPES ARE SET IN THE BASE FOLLOW CONSTRUCTION PROCEDURES SHOWN BY STD. DWG. 840.00.
-PRECAST UNITS MADE OF CLASS 'AA' CONCRETE MAY BE USED IN LIEU OF BRICK MASONRY CONSTRUCTION.
-INCLUDE REINFORCING STEEL COST IN THE UNIT OR LINEAR FOOT BID PRICE FOR "MASONRY DRAINAGE STRUCTURE".
-REFERENCE STD. DWG. 840.25 FOR FRAME ANCHORAGE.
-CONCRETE BRICK, JUMBO BRICK AND 4" SOLID CONCRETE BLOCK WILL BE PERMITTED.
-CONCRETE FOR BRICK BOX REFER TO SECTION 832 OF THE STANDARD SPECIFICATIONS.
-PROVIDE GRATED DROP INLETS OVER 3'-6" DEEP WITH STEPS SPACED 12" ON CENTER AS DIRECTED BY STD. DWG. 840.66.
-FRAME AND GRATES ARE SEPARATE CONTRACT ITEMS.

STATE OF NORTH CAROLINA DEPT. OF TRANSPORTATION DIVISION OF HIGHWAYS RALEIGH, N.C.

L-12

ENGLISH STANDARD DRAWING FOR
ANCHORAGE FOR FRAMES
BRICK/CONCRETE/PRECAST CONCRETE

SHEET 1 OF 1
840.25

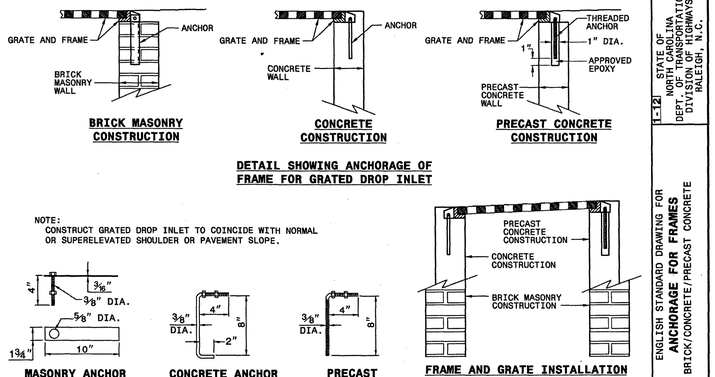

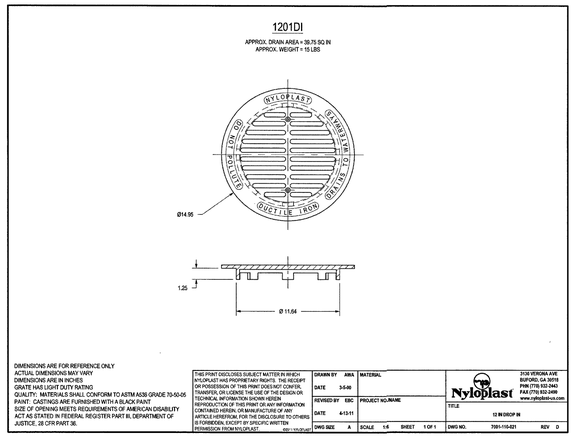

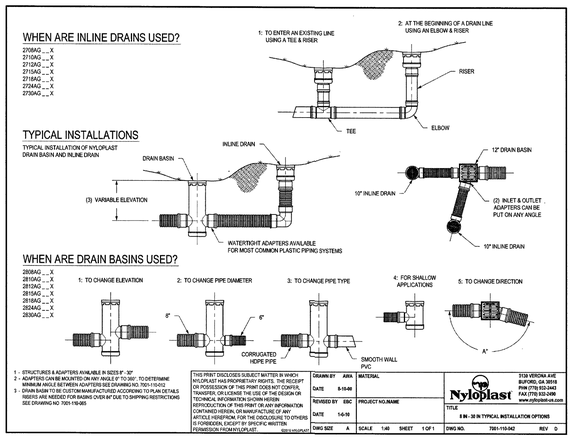

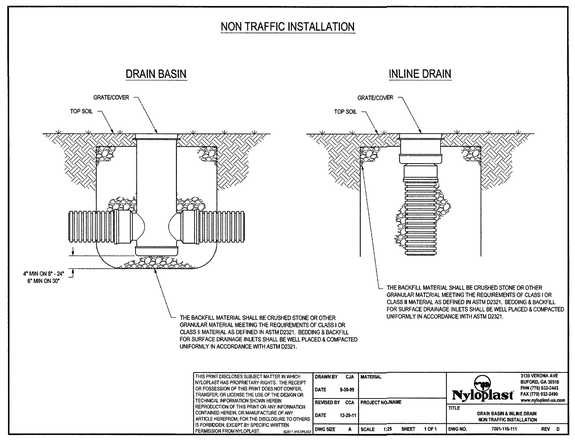

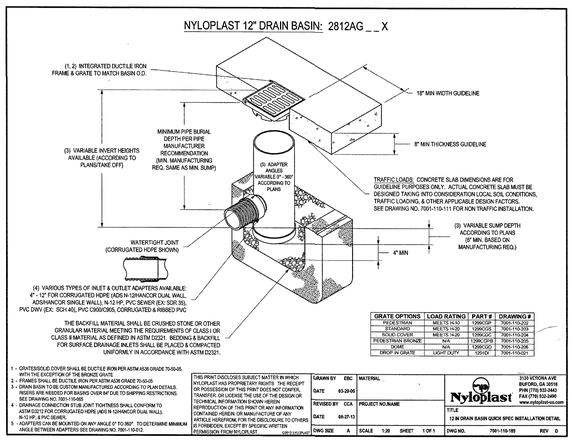

For each open utility cut of City streets, a $325 permit shall be required from the City prior to occupancy and/or project acceptance.

1 inch

Approved Construction Plan

	Name	Date
Planning		12/15/16
Traffic		12-13-16
Fire		12.16.16

CITY OF WILMINGTON NORTH CAROLINA
Public Services - Engineering Division
APPROVED STORMWATER MANAGEMENT PLAN
Date: 12/15/16 Permit # 20156212
Signed:

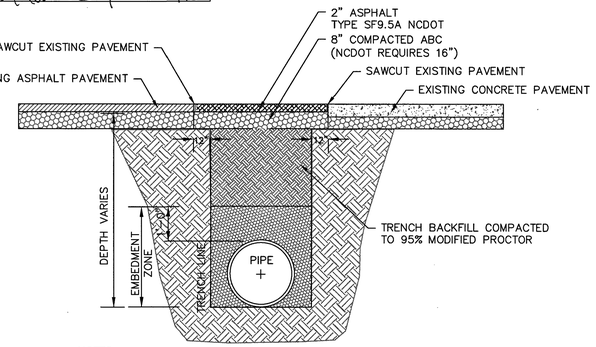

NOTES:
* BACKFILL TO BE INSTALLED IN 6" LIFTS (MAXIMUM) AND COMPACTED TO A MINIMUM DENSITY OF 95% AS DETERMINED BY THE MODIFIED A.A.S.H.T.O. STANDARD METHOD T-99
* CUT - BACK TO BE PREPARED AFTER TRENCH BACKFILLING AND COMPACTION

STANDARD SHOWING METHOD MAKING PAVEMENT REPAIRS WHERE PIPE IS INSTALLED

PAVEMENT REPAIR DETAIL
SD 1-16
NOT TO SCALE

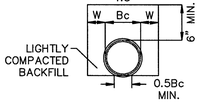

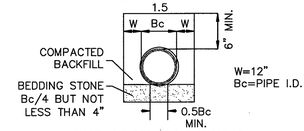

GUIDELINES FOR BEDDING DETAILS, STORM SEWER CLASS C
SD 2-17
NOT TO SCALE

- EXCAVATION FOR STORM DRAINAGE PIPE SHALL BE TO THE LINES AND GRADES AS SHOWN ON THE PLANS.
- THE BEDDING SHALL BE SHAPED IN ACCORDANCE WITH CLASS "C" BEDDING AS SHOWN ON CITY STANDARD DETAIL SD 2-17.
- THE BEDDING SHALL PROVIDE A FIRM FOUNDATION OF UNIFORM DENSITY ALONG THE ENTIRE LENGTH OF PIPE. RECESSES SHALL BE MADE TO ACCOMMODATE BELLS AND JOINTS.
- WHERE UNSTABLE SOILS ARE ENCOUNTERED AS DETERMINED BY GEOTECHNICAL ENGINEER, A MINIMUM 4-INCH THICK BEDDING OF STONE SHALL BE PLACED, SEE FIGURE 2, SD 2-17.
- THE STONE SHALL BE UNIFORMLY GRADED FROM 3/4 INCH TO NO. 4 IN ACCORDANCE WITH ASTM C-33. CARE SHALL BE TAKEN TO PREVENT UNDERCUTTING IN SUITABLE SOIL.
- AREAS UNDERCUT SHALL BE FILLED WITH SUITABLE SOIL AND COMPACTED TO 95% OF MAXIMUM DENSITY AT OPTIMUM MOISTURE CONTENT AS DETERMINED BY ASTM D 1557 STANDARD TEST METHOD.

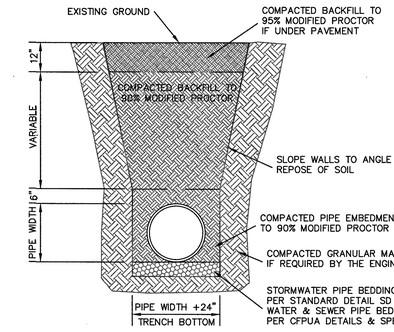

STANDARD PIPE TRENCH DETAIL
SD 1-07
NOT TO SCALE

ROOF LEADER COLLECTION DETAILS FOR NON-TRAFFIC AREAS
NOT TO SCALE

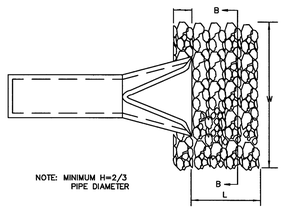

SECTION B-B

NOTES:
1. SEE OUTLET PROTECTION TABLE BELOW FOR RIP-RAP DIMENSIONS AND CLASSES.
2. RIPRAP SHOULD EXTEND UP BOTH SIDES OF THE APRON AND AROUND THE END OF THE PIPE OR CULVERT AT THE DISCHARGE OUTLET AT A MAXIMUM SLOPE OF 2:1 AND A HEIGHT NOT LESS THAN TWO THIRDS THE PIPE DIAMETER OR CULVERT HEIGHT.
3. THERE SHALL BE NO OVERFLOW FROM THE END OF THE APRON TO THE SURFACE OF THE RECEIVING CHANNEL. THE AREA TO BE PAVED OR RIPRAPPED SHALL BE UNDERCUT SO THAT THE INVERT OF THE APRON SHALL BE AT THE SAME GRADE (FLUSH) WITH THE SURFACE OF THE RECEIVING CHANNEL. THE APRON SHALL HAVE A CUTOFF OR TOE WALL AT THE DOWNSTREAM END.
4. THE WIDTH OF THE END OF THE APRON SHALL BE EQUAL TO THE BOTTOM WIDTH OF THE RECEIVING CHANNEL. MAXIMUM TAPER TO RECEIVING CHANNEL 5:1
5. ALL SUBGRADE FOR STRUCTURE TO BE COMPACTED TO 95% OR GREATER.
6. THE PLACING OF FILL, EITHER LOOSE OR COMPACTED IN THE RECEIVING CHANNEL SHALL NOT BE ALLOWED.
7. NO BENDS OR CURVES IN THE HORIZONTAL ALIGNMENT OF THE APRON WILL BE PERMITTED.

RIP RAP APRON OUTLETS
NOT TO SCALE

STORM DRAINAGE NOTES:

1. ALL PIPE BEDDING SHALL BE CLASS "C" UNLESS OTHERWISE DIRECTED BY THE ENGINEER.
2. ALL STORM DRAINAGE PIPES SHALL BE RCP CLASS III UNLESS OTHERWISE NOTED ON THE PLANS.
3. DO NOT PLANT TREES WITHIN UTILITY AND DRAINAGE EASEMENTS.
4. THE ENGINEER AND THE CONTRACTOR SHALL INSPECT ALL EXISTING PIPES USED IN THE FINAL DRAINAGE SYSTEM AND AGREE ON THE CONDITION OF THE PIPES PRIOR TO CONSTRUCTION. IF DAMAGE OCCURS TO THESE PIPES DURING CONSTRUCTION, THE CONTRACTOR SHALL BE RESPONSIBLE FOR THE REPAIR OR REPLACEMENT OF THE PIPE(S).
5. THE CONTRACTOR SHALL CONTACT ONECALL BEFORE COMMENCING ANY WORK. THE CONTRACTOR SHALL VERIFY THE LOCATION OF ALL UNDERGROUND UTILITIES WHETHER INDICATED ON THE DRAWINGS OR NOT. THE CONTRACTOR WILL ASSURE THE PRESENCE ONSITE OF A REPRESENTATIVE OF THE GAS COMPANY WHEN WORKING IN THE VICINITY OF ANY GAS MAINS.

OUTLET NUMBER	OUTLET DIA (in)	OUTLET Q (cfs)	OUTLET V (fps)	ZONE	RIPRAP D50 (in)	RIPRAP CLASS	RIPRAP Dmax (in)	APRON THICKNESS (in)	APRON LENGTH* (ft)	APRON WIDTH (ft)
1	30	17.90	6.20	2	8	B	12	22	12	7.5

NOTES: 1.) Minimum apron length of 10 ft shall be installed.
2.) Dmax = D50 x 1.5
3.) Thickness = Dmax x 1.5
4.) Width = 3 x Pipe Dia.

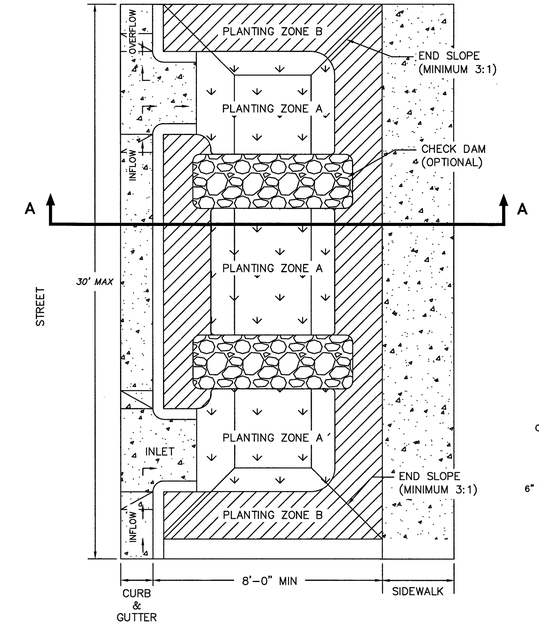

STREET SWALE PLAN VIEW
NOT TO SCALE

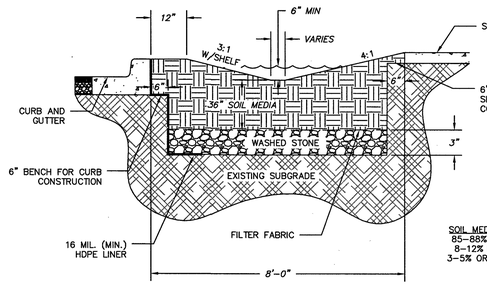

STREET SWALE CROSS SECTION A-A
NOT TO SCALE

REV.NO.	DESCRIPTIONS	DATE
4	CITY OF WILMINGTON ENGINEERING COMMENTS	09/21/2016
3	CITY OF WILMINGTON TRC COMMENTS	08/23/2016
2	SITE PLAN AND STORM DRAINAGE REVISIONS	07/19/2016
1	CFPUA COMMENTS	04/11/2016
0	ISSUED FOR CONSTRUCTION	03/17/2016

REVISIONS

SEAL

SEAL
NORTH CAROLINA PROFESSIONAL ENGINEER SEAL 035107 NICHOLAS J. LAURETTA
09/21/16

McKIM&CREED
243 North Front Street
Wilmington, North Carolina 28401
Phone: (910)343-1048, Fax: (910)251-8282
License: F-1222
www.mckimcreed.com

NORTH AMERICA SEKISUI HOUSE, LLC
RIVERLIGHTS™

RIVERLIGHTS MARINA VILLAGE PHASE 1B

STORMWATER DRAINAGE DETAILS

DATE:	17MAR16
MCE PROJ. #	2735-0124
DRAWN	ALM
DESIGNED	NJL
CHECKED	KCBE
PROJ. MGR.	NJL

SCALE: HORIZONTAL: N/A VERTICAL: N/A

MAC FILE NUMBER: CG-503
DRAWING NUMBER: 31

STATUS: FINAL DESIGN
ISSUED FOR CONSTRUCTION
REVISION: 0

S:\2735\0124 Marina Village 3\0-Drawings\Phase 1B\CG-503.dwg