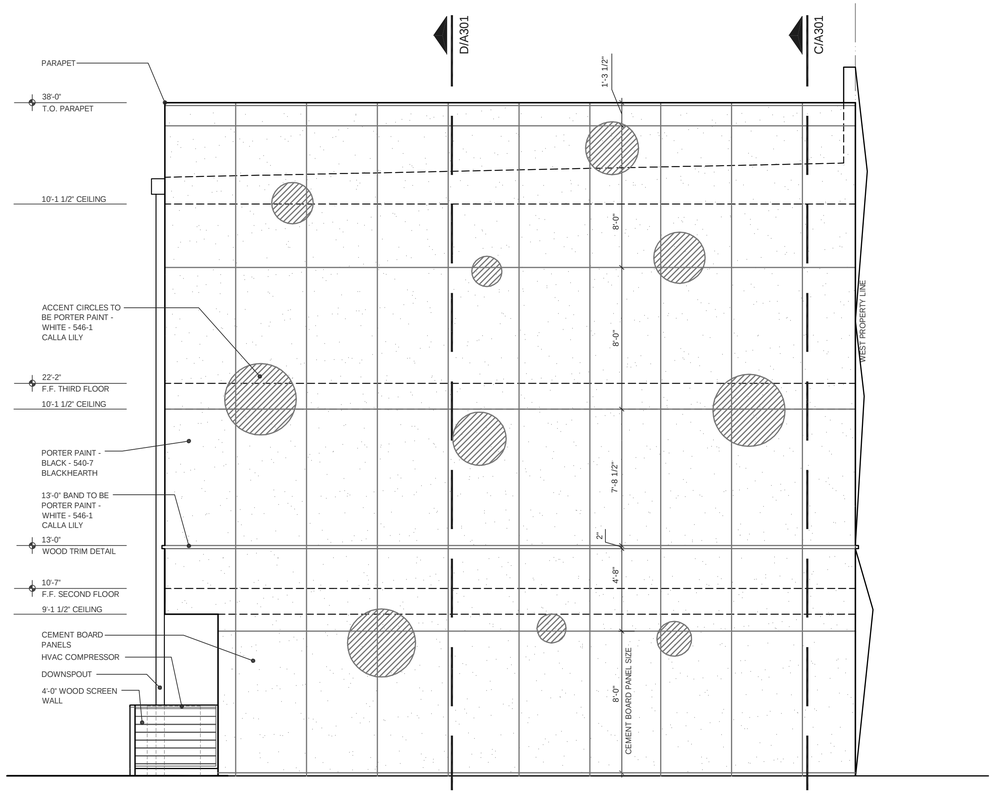

D NORTH ELEVATION
SCALE = 1/4" = 1'-0"

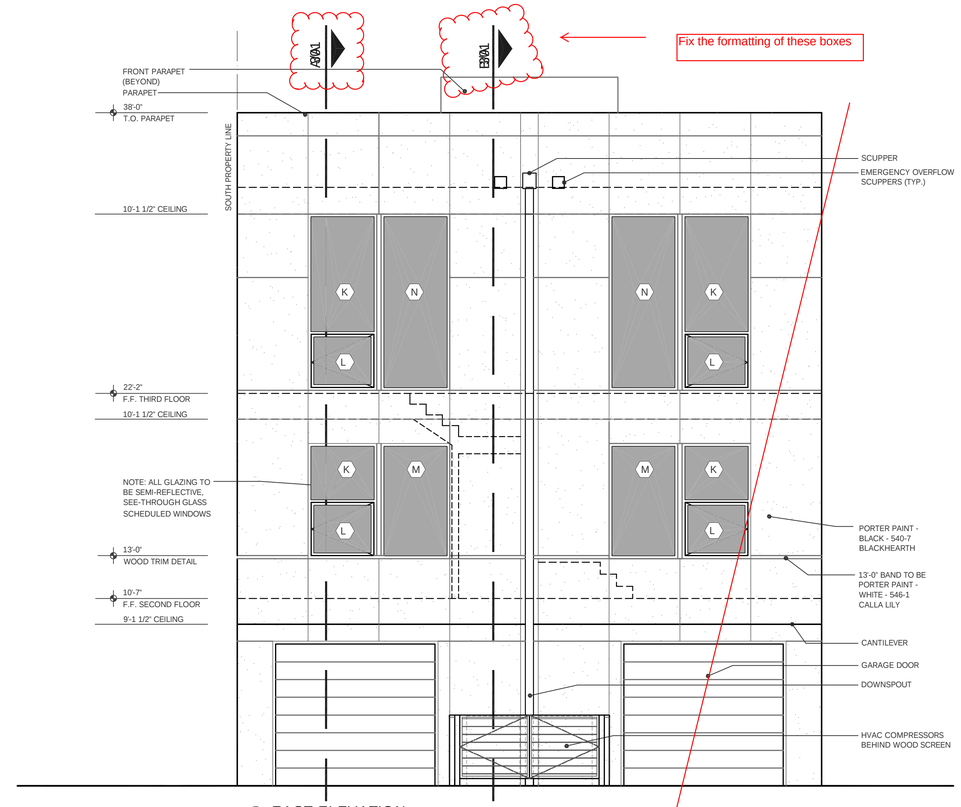

C EAST ELEVATION
SCALE = 1/4" = 1'-0"

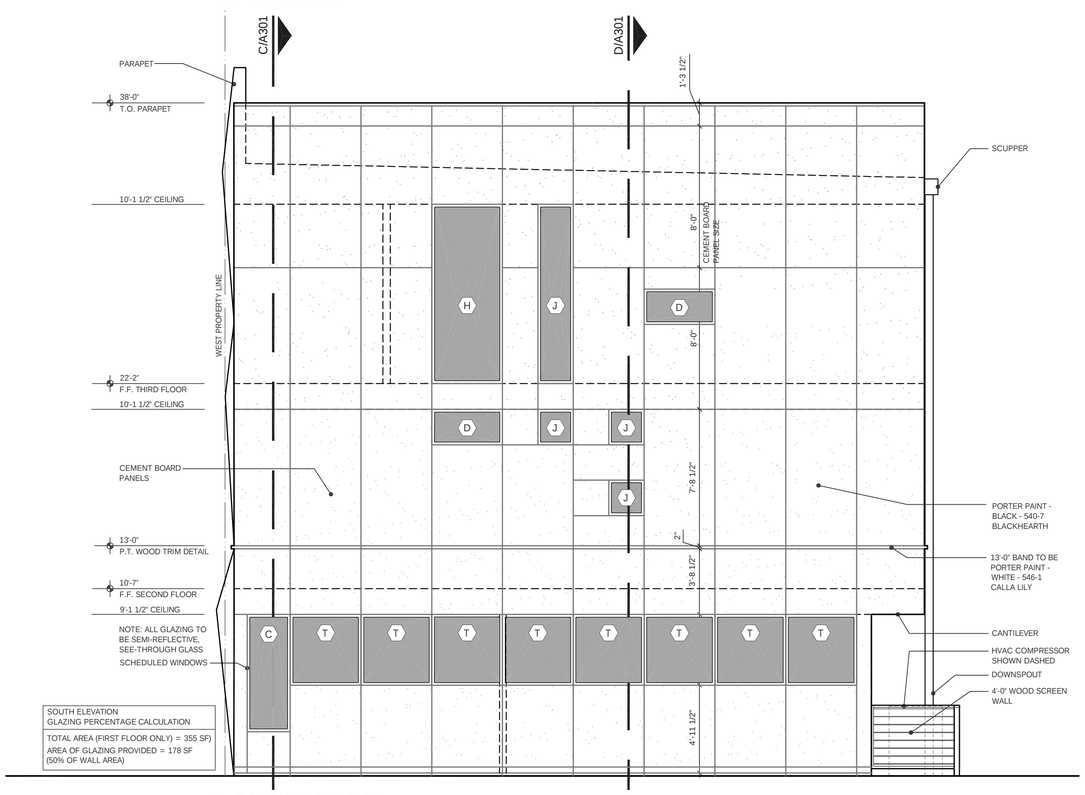

B SOUTH ELEVATION
SCALE = 1/4" = 1'-0"

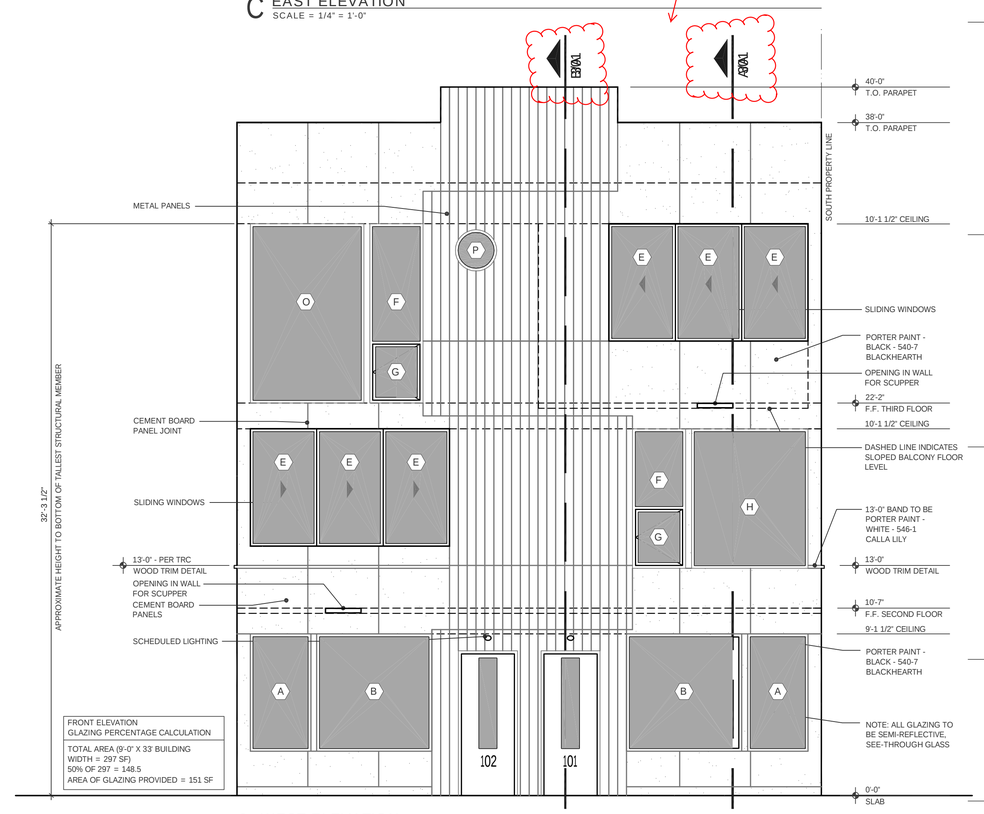

A WEST ELEVATION
SCALE = 1/4" = 1'-0"

DESIGNED BY ROMERAMA
ARCHITECTURE
MUSIC
ART
1507 RANKIN STREET
WILMINGTON, NORTH CAROLINA 28401
910.228.3137
contact: ROB ROMERO rob@romerama.com

www.romerama.com

WORKLIVE RECLAMATION

802 NORTH FOURTH STREET
WILMINGTON, NORTH CAROLINA 28401

A 201 ELEVATIONS

09.12.2013	ISSUED FOR OWNER REVIEW
09.13.2013	ISSUED FOR OWNER REVIEW
10.02.2013	ISSUED FOR OWNER REVIEW
11.14.2013	ISSUED FOR POTENTIAL USER
12.05.2013	ISSUED FOR OWNER REVIEW
12.12.2013	ISSUED FOR TRC REVISIONS
01.22.2014	ISSUED FOR TRC REVISIONS & OWNER VE
02.04.2014	ISSUED FOR TRC REVISIONS