THEATER SIDE A FROM PREVIOUS APPROVED PLANS

47.23 SF PLANT BED CUTOUT IN SIDEWALK

50.58 SF PLANT BED CUTOUT IN SIDEWALK

192 SF PREVIOUSLY PROPOSED FOUNDATION PLANTING AREA TO BE REPLACED BY SIDEWALK CUTOUTS AS INDICATED THIS SHEET

51.29 SF PLANT BED CUTOUT IN SIDEWALK

62.16 SF PLANT BED CUTOUT IN SIDEWALK

TOTAL AREA OF CUTOUTS = 211.46 SF

EXISTING PLANTINGS NOT CALCULATED THIS SHEET

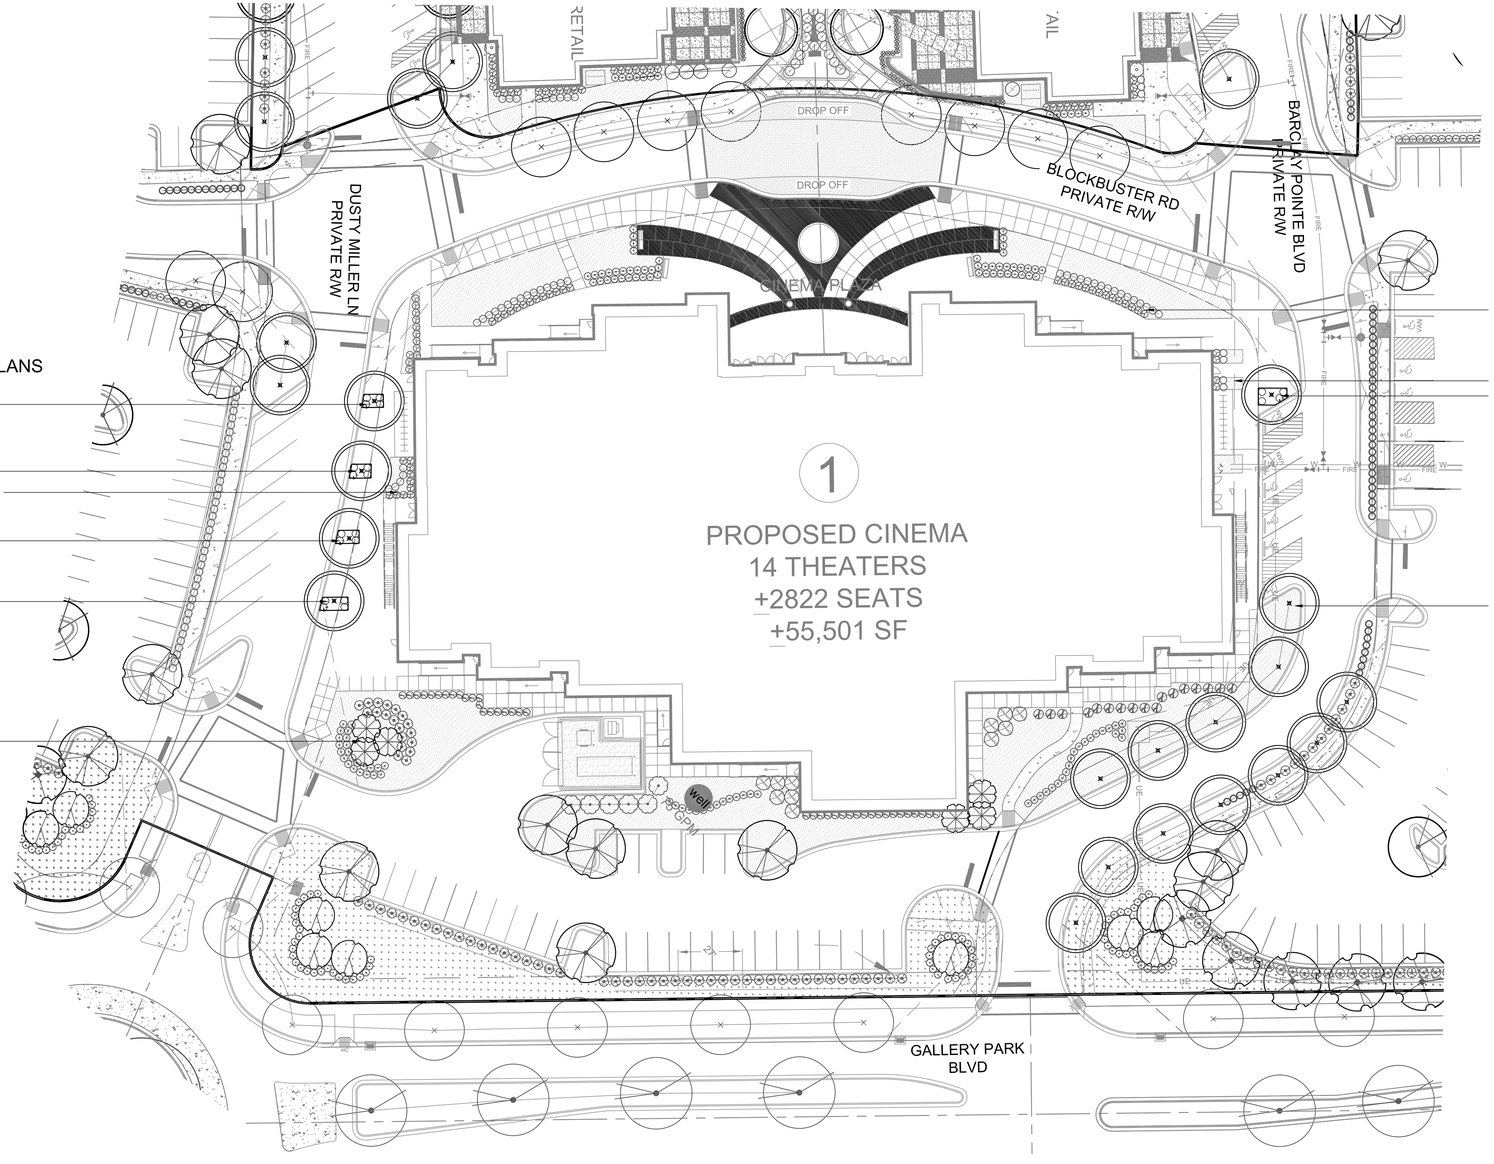

THEATER SIDE B FROM PREVIOUS APPROVED PLANS

EXISTING PLANTINGS NOT CALCULATED THIS SHEET

61.85 SF PREVIOUS FOUNDATION PLANTING TO BE REPLACED WITH SIDEWALK CUTOUT

66.02 SF PLANT BED CUTOUT IN SIDEWALK

EXISTING PLANTINGS NOT CALCULATED THIS SHEET

GRAPHIC SCALE

0 15 30 60 120

SCALE: 1"=30'

FINAL DESIGN - PARTIAL LANDSCAPE AS-BUILT

REVISIONS:

CLIENT INFORMATION:

Barclay Commons Retail, LLC.
2508 Independence Blvd., Suite 202
Wilmington, NC

PARAMOUNTE ENGINEERING, INC
122 Cinema Drive
Wilmington, North Carolina 28403
(910) 791-6707 (O) (910) 791-6760 (F)
NC License #: C-2846

PARTIAL LANDSCAPE AS-BUILT
THE POINTE THEATER

THE POINTE AT BARCLAY
'BARCLAY WEST TRACT B' - PHASE 1
CITY OF WILMINGTON
NORTH CAROLINA

PROJECT STATUS
CONCEPTUAL LAYOUT:
PRELIMINARY LAYOUT:
FINAL DESIGN:
RELEASED FOR CONST:

DRAWING INFORMATION
DATE: 4/11/17
SCALE: 1" = 30'
DESIGNED: AHE
DRAWN: JKM
CHECKED: AHE

SEAL

EX-1

PEI JOB#: 14222.PE